
#62-70

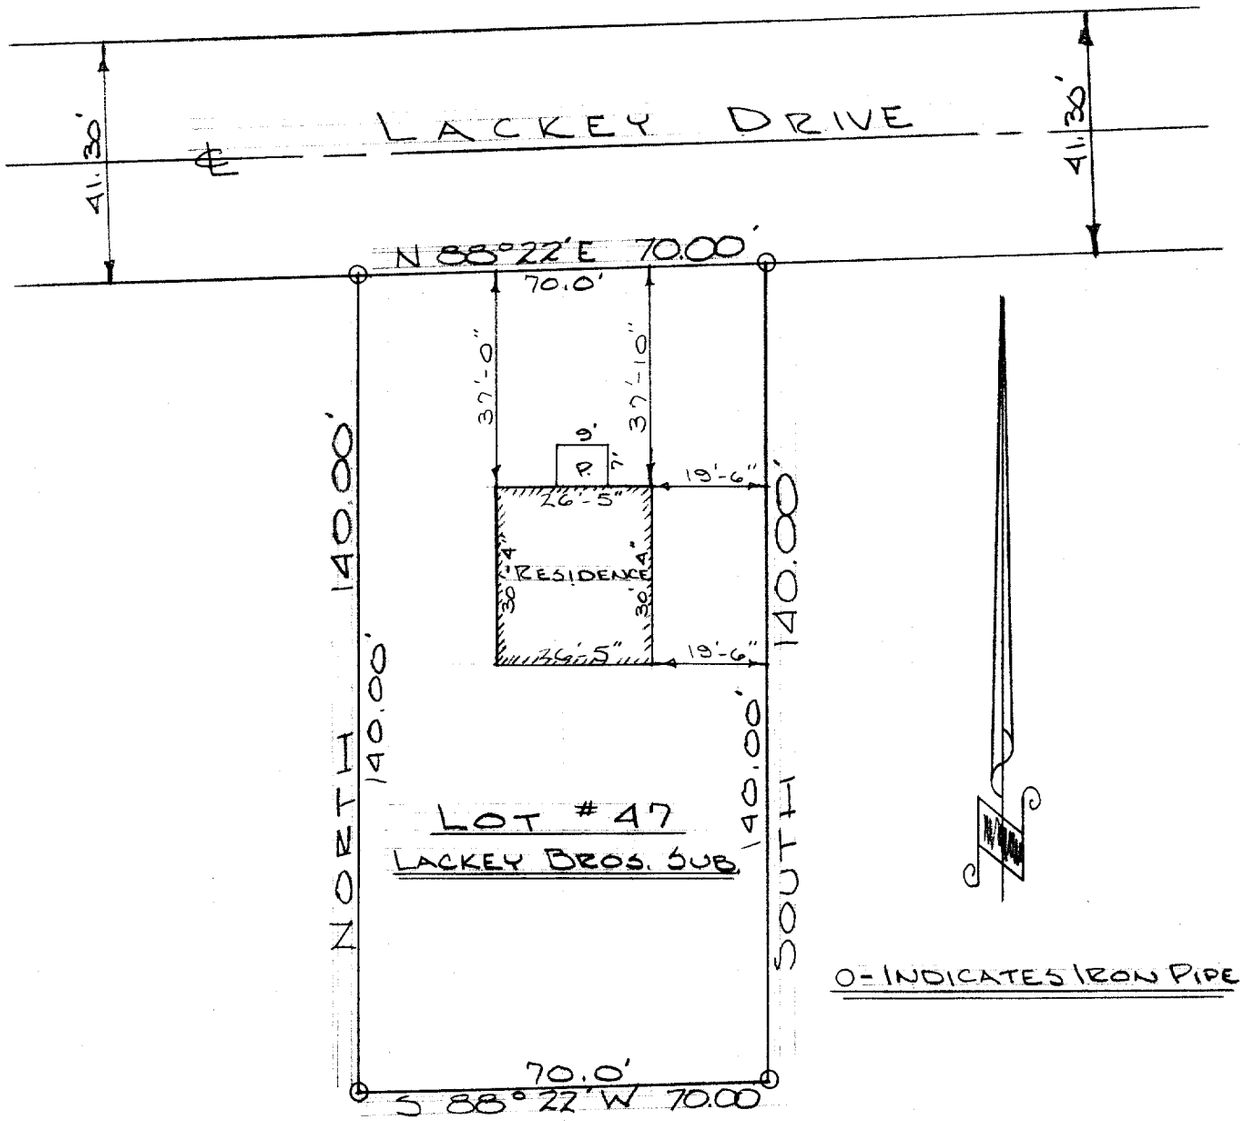

DESCRIPTION:

Lot 47 in Lackey Brothers Addition located in the Village of Williams Bay, Walworth County, Wisconsin.

CERTIFICATE:

I, James F. Biagi, surveyor, do hereby certify that I have surveyed the property hereon described and that the location of the improvements are as shown.

March 27, 1970.

WISCONSIN JAMES F. BIAGI MILWAUKEE, WIS. LAND SURVEYOR

James F. Biagi, R.L.S. 272

11-8B