
ABELL
SURVEYING & MAPPING
DELAVAN, WISCONSIN 53115
414-728-6737

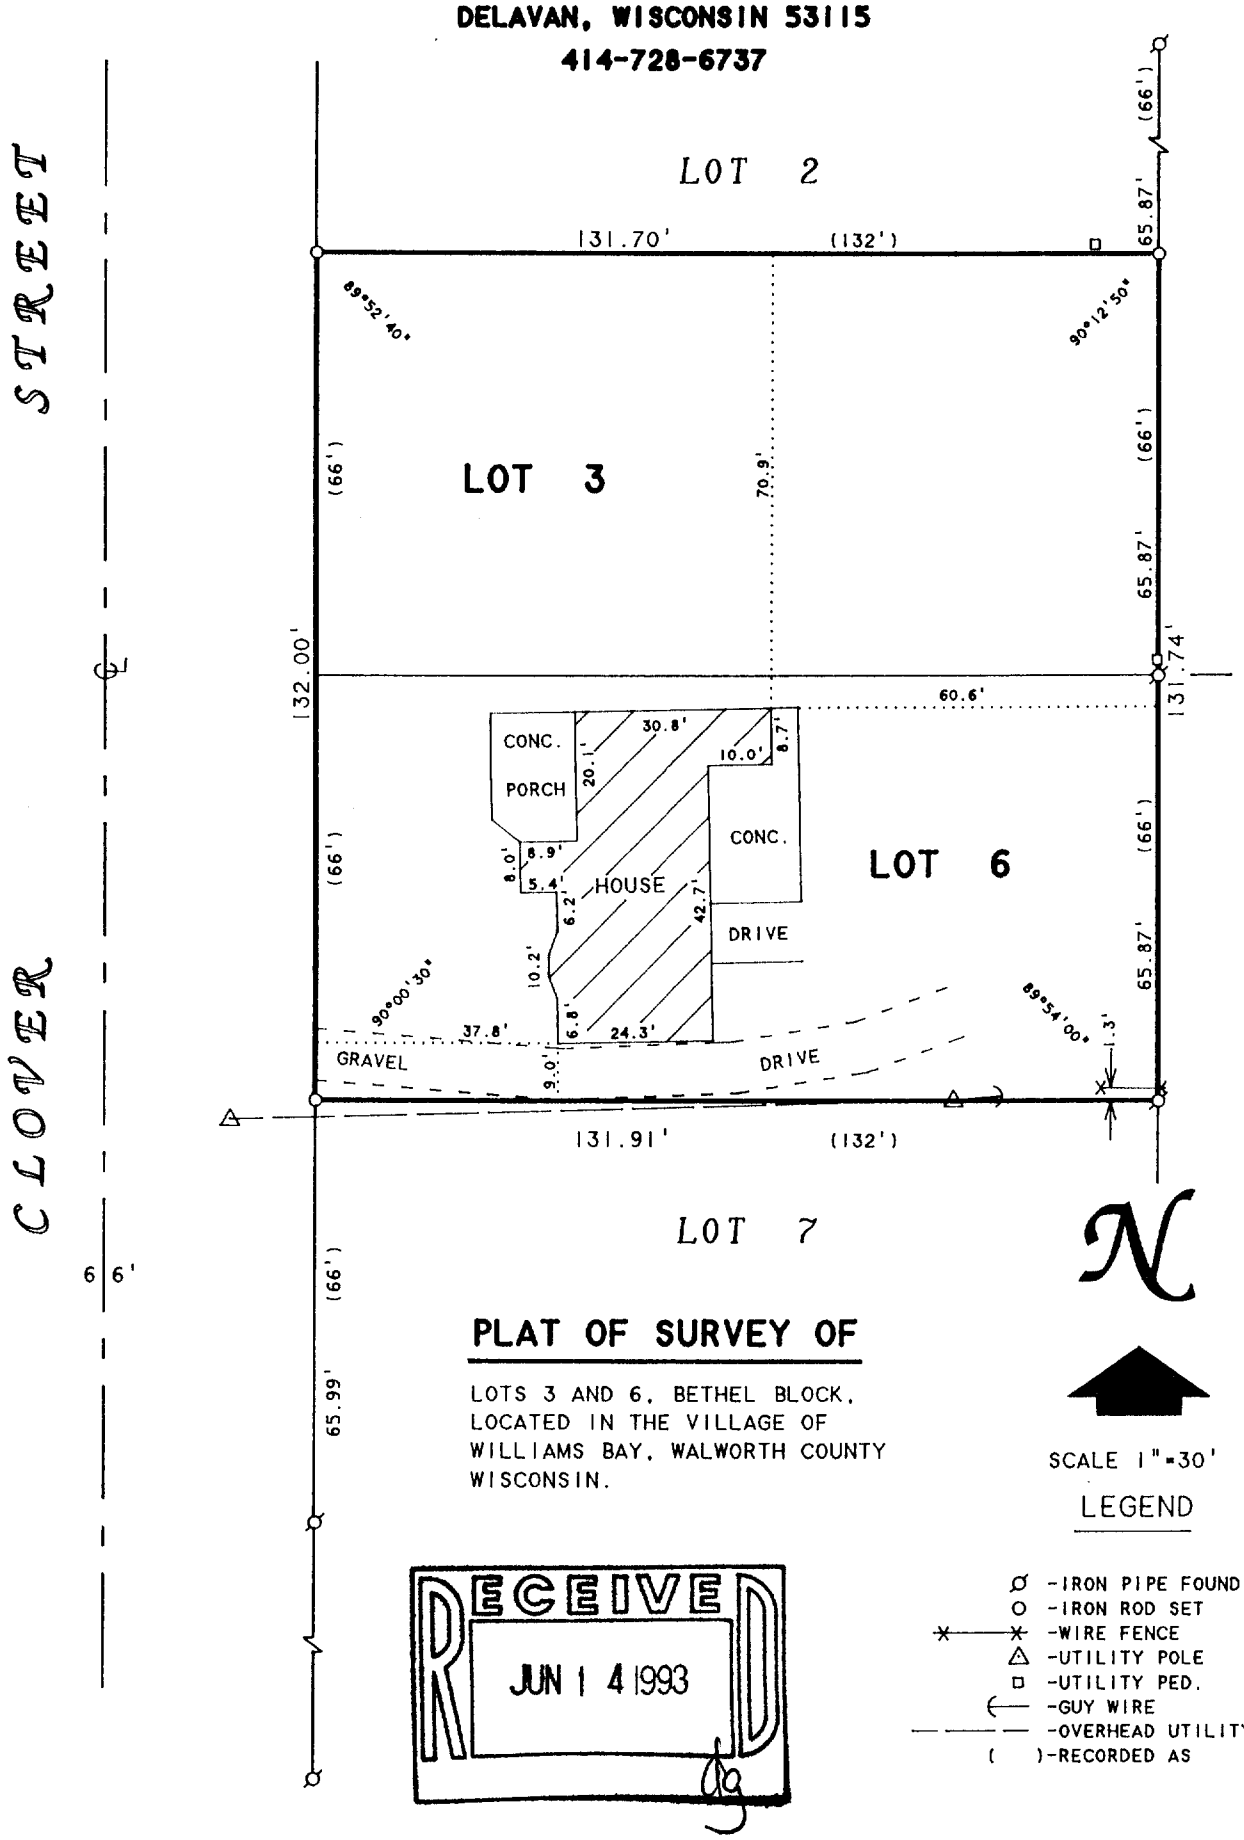

PLAT OF SURVEY OF

LOTS 3 AND 6, BETHEL BLOCK, LOCATED IN THE VILLAGE OF WILLIAMS BAY, WALWORTH COUNTY WISCONSIN.

SCALE 1"=30'

LEGEND

- ⌀ -IRON PIPE FOUND
- O -IRON ROD SET
- -X-X- -WIRE FENCE
- △ -UTILITY POLE
- □ -UTILITY PED.
- ⟵ -GUY WIRE
- — — — -OVERHEAD UTILITY LINE
- ( )-RECORDED AS

RECEIVED
JUN 14 1993

I, DAVID F. ABELL, DO HEREBY CERTIFY THAT I HAVE SURVEYED THE PROPERTY HEREON DESCRIBED ACCORDING TO THE OFFICAL RECORDS AND THAT THE PLAT HEREON IS A CORRECT REPRESENTATION OF THE PROPERTY LINES TO THE BEST OF MY KNOWLEDGE AND BELIEF.

ORDERED BY: BEVERLY GBUR
P.O. BOX 794
WILLIAMS BAY, WI 53191

David F. Abell
DAVID F. ABELL
WISCONSIN REGISTERED LAND SURVEYOR, S-1596

April 29, 1993
DATE

JOB NUMBER - 93045

NOTE: THIS IS NOT A CERTIFIED COPY UNLESS SEALED.

WBX - 3

011-987