
191-65

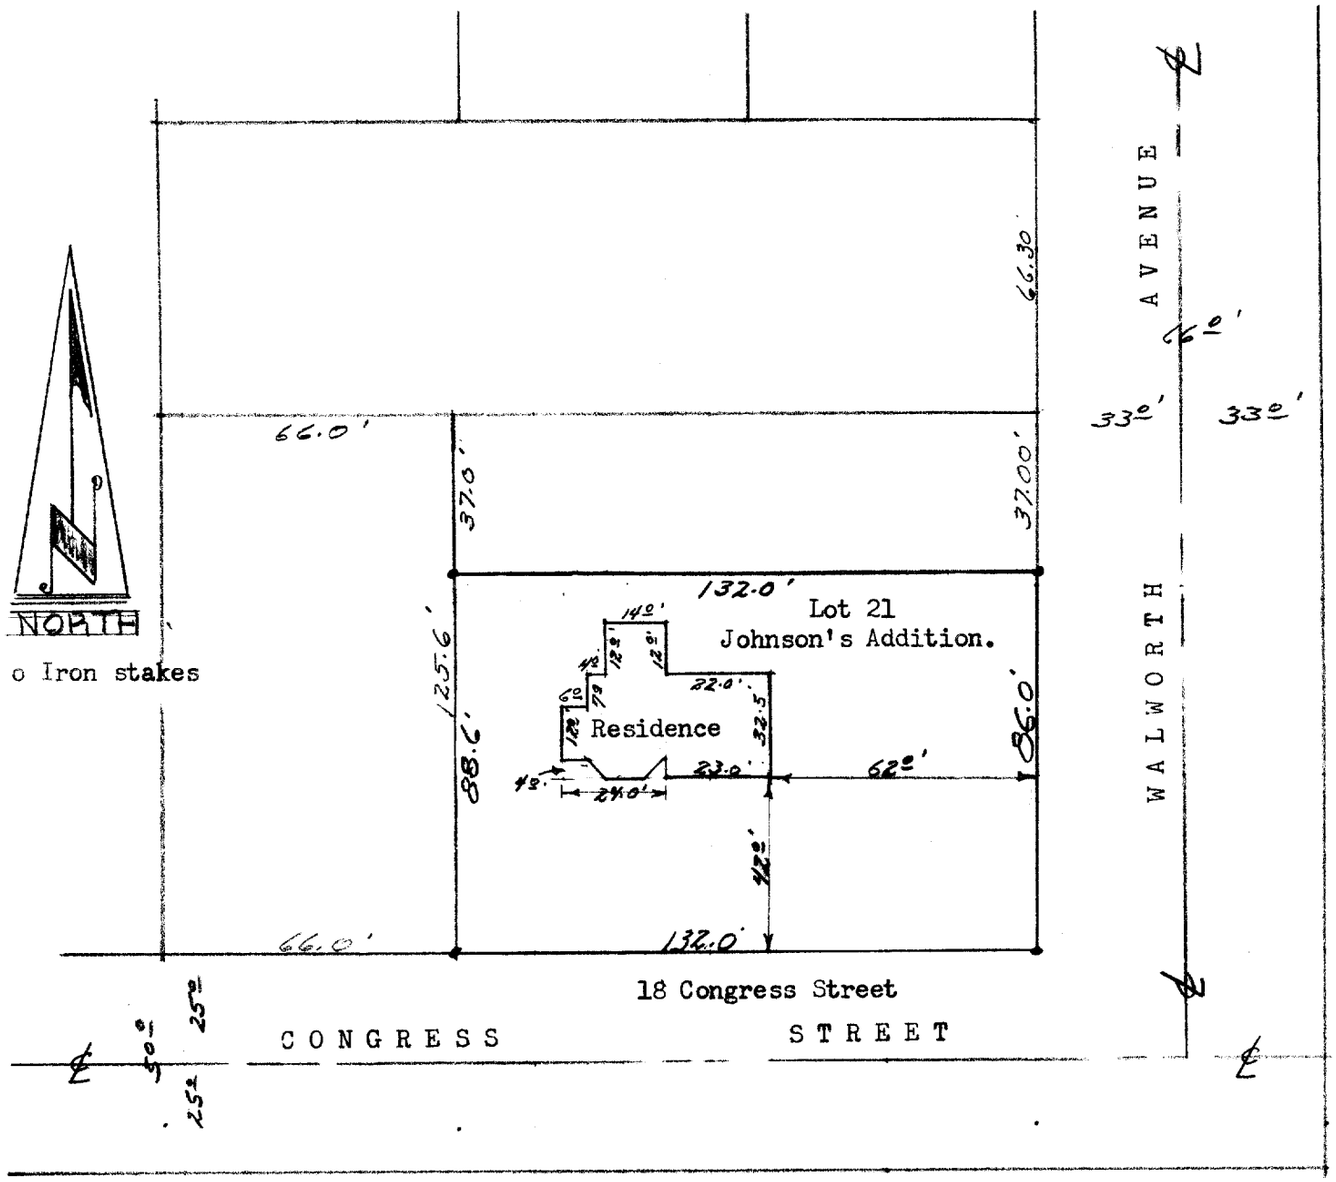

DESCRIPTION: Lot 21 (except the North 37 feet) in Johnson's Addition to the Village of Williams Bay, Walworth County, Wisconsin.

CERTIFICATE:

I, James F. Biagi, Surveyor, do hereby certify that I have surveyed the property hereon described and that the location of the improvements are as shown.

Dated : July 9th 1965.

WISCONSIN
JAMES F.
BIAGI
MILWAUKEE,
WIS.
LAND SURVEYOR

James F. Biagi. RLS 272
Elkhorn, Wisconsin.

WJA-20

11-9B