
ORDERED BY:
ACTION REALTY
P.O. BOX 324
HARVARD, IL 60033

ABELL
SURVEYING & MAPPING
DELAVAN, WISCONSIN 53115
414-728-6737

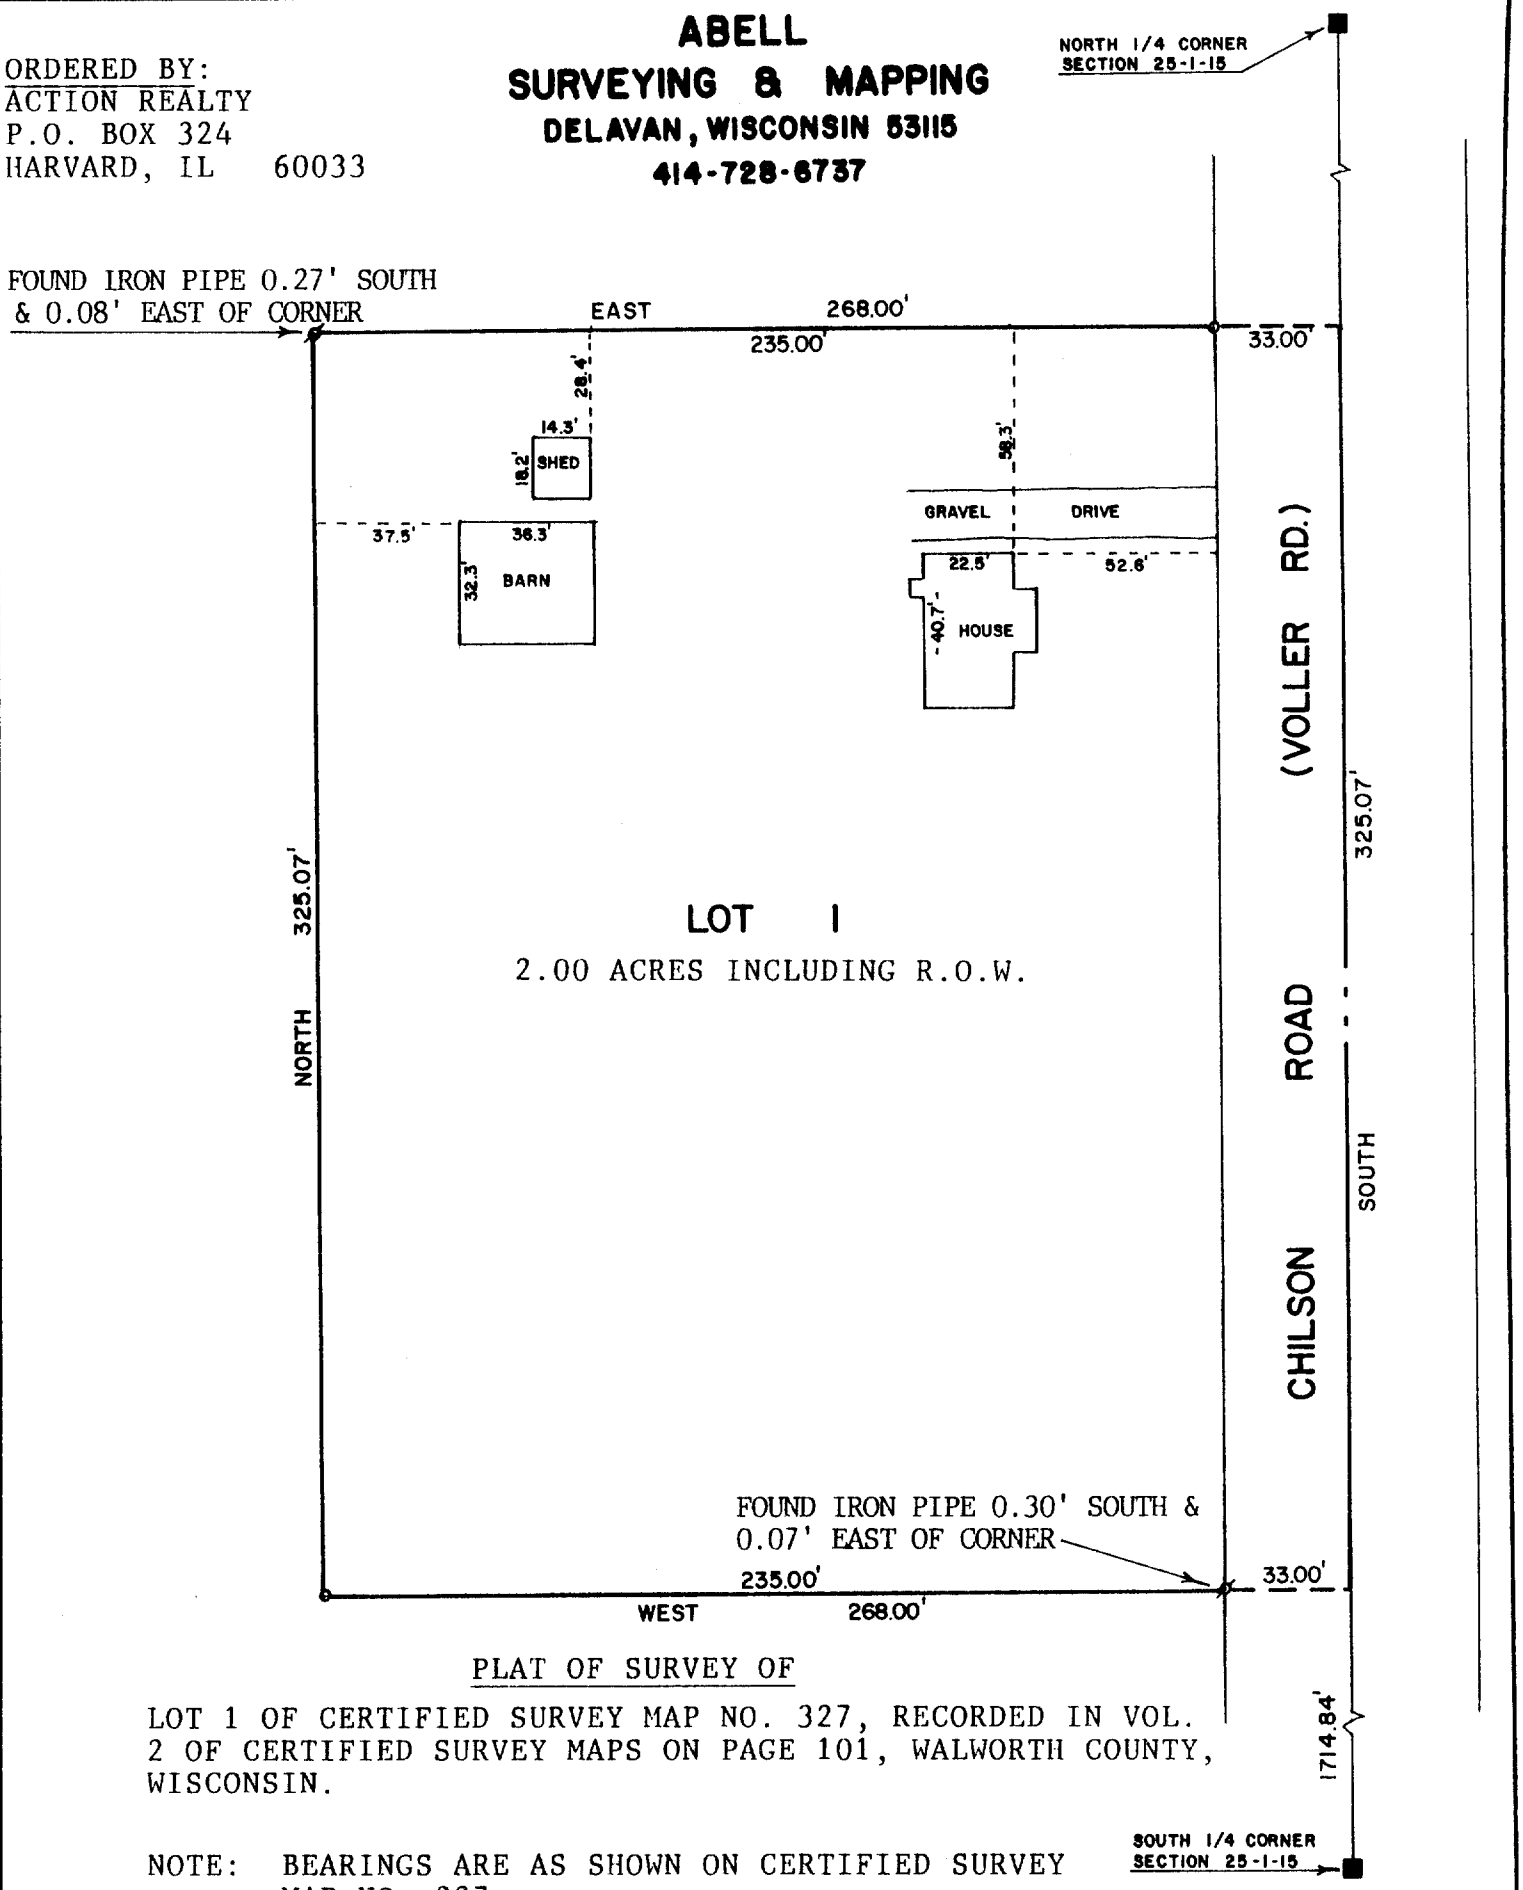

PLAT OF SURVEY OF

LOT 1 OF CERTIFIED SURVEY MAP NO. 327, RECORDED IN VOL. 2 OF CERTIFIED SURVEY MAPS ON PAGE 101, WALWORTH COUNTY, WISCONSIN.

NOTE: BEARINGS ARE AS SHOWN ON CERTIFIED SURVEY MAP NO. 327.

RECEIVED
JUL 8 1987

SCALE - 1"=50'

LEGEND
- ⌀ - IRON PIPE FOUND
- o - IRON PIPE SET
- ( )- RECORDED AS
- ■ - WAL. CO. MONUMENT

I, DAVID F. ABELL, DO HEREBY CERTIFY THAT I HAVE SURVEYED THE PROPERTY HEREON DESCRIBED ACCORDING TO THE OFFICIAL RECORDS AND THAT THE PLAT HEREON IS A CORRECT REPRESENTATION OF THE PROPERTY LINES TO THE BEST OF MY KNOWLEDGE AND BELIEF.

David F. Abell
DAVID F. ABELL
WISCONSIN REGISTERED LAND SURVEYOR, S-1596

DATE June 8, 1987 JOB NUMBER - 87073

NOTE: THIS IS NOT A CERTIFIED COPY UNLESS SEALED.

AA327-1

115-112