
ABELL SURVEYING & MAPPING

1140 SEQUOIA STREET • DELAVAN, WISCONSIN 53115
262-728-6737

NOTE 1: BEARINGS ARE REFERENCED TO THE WISCONSIN COORDINATE SYSTEM - SOUTH ZONE.

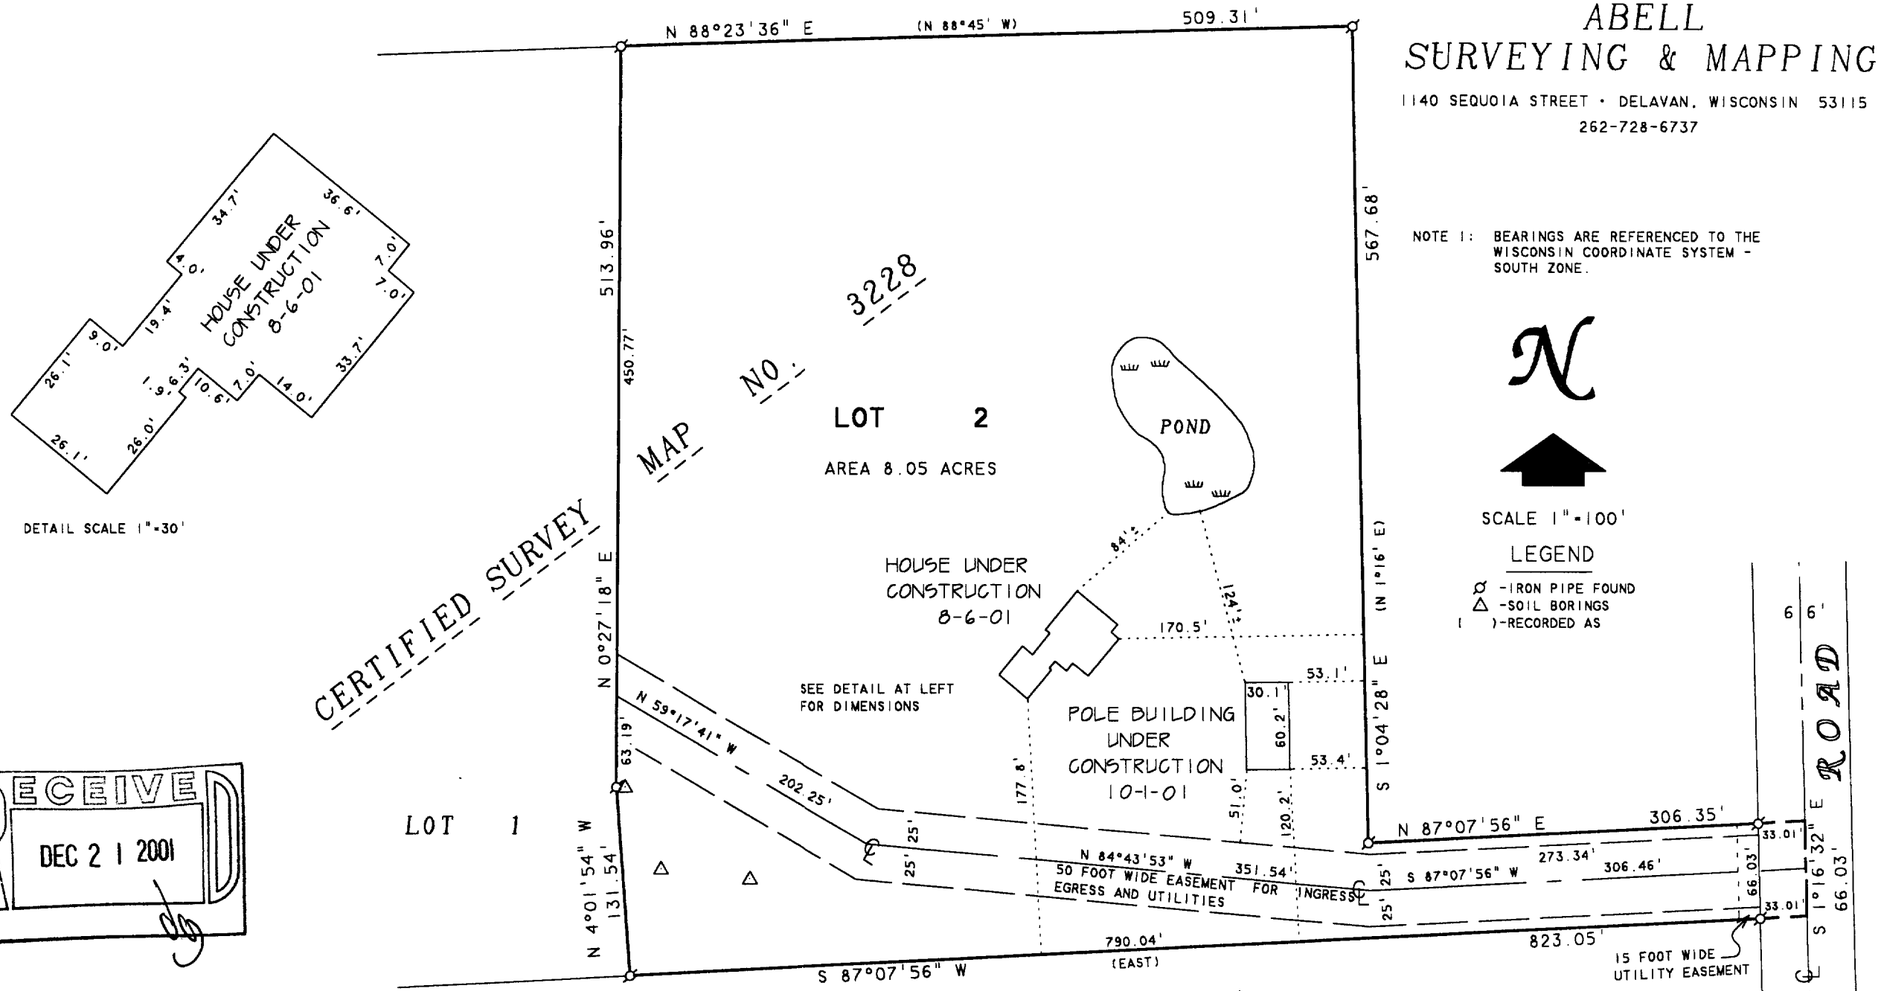

RECEIVED
DEC 2 1 2001

NOTE 1: BEARINGS ARE REFERENCED TO THE WISCONSIN COORDINATE SYSTEM - SOUTH ZONE.

N

SCALE 1"=100'

LEGEND

- -IRON PIPE FOUND
- -SOIL BORINGS
-)-RECORDED AS

I, DAVID F. ABELL, DO HEREBY CERTIFY THAT I HAVE SURVEYED THE PROPERTY HEREON DESCRIBED ACCORDING TO THE OFFICAL RECORDS AND THAT THE PLAT HEREON IS A CORRECT REPRESENTATION OF THE PROPERTY LINES TO THE BEST OF MY KNOWLEDGE AND BELIEF.

David F. Abell

DAVID F. ABELL
WISCONSIN REGISTERED LAND SURVEYOR, S-1596

March 22, 2001

DATE JOB NUMBER - 00017E
NOTE: THIS IS NOT A CERTIFIED COPY UNLESS SEALED.

REVISED DATE: OCTOBER 1, 2001
REVISED TO SHOW POLE BUILDING UNDER CONSTRUCTION.

REVISED DATE: AUGUST 6, 2001
REVISED TO SHOW HOUSE UNDER CONSTRUCTION.

REVISED DATE: APRIL 2, 2001
REVISED TO SHOW NEW PROPOSED HOUSE AND POLE BUILDING LOCATIONS.

ORDERED BY: LINDA HUGHES
P.O. BOX 125
RINGWOOD, IL 60072

PLAT OF SURVEY OF

LOT 2, CERTIFIED SURVEY MAP NO. 3228, LOCATED IN THE SOUTHEAST 1/4 OF SECTION 22, T1N, R15E, WALWORTH COUNTY, WISCONSIN.

B AA-3228-2 115-257