PLAT OF SURVEY

LOT 1 OF CERTIFIED SURVEY MAP NO. 44129

LOCATED IN PART OF THE SE /4 OF THE SW 1/4 OF SECTION 24,
TOWN 1 NORTH, RANGE 15 EAST, WALWORTH COUNTY, WISCONSIN




FARRIS, HANSEN & ASSOC. INC.
7 RIDGWAY COURT– P.O. BOX 437
ELKHORN, WISCONSIN 53121
PHONE (262) 723-2098
FAX (262) 723-5886
OWNER: ROBERT A. PEARCE FARMS, INC.
W5740 N. WALWORTH ROAD
WALWORTH, WI. 53184
ZONING: A-1
SOILS: MyA, MyB

CERTIFIED SURVEY MAP NO. 4129

732150

A FARM STRUCTURE SEPARATION LOCATED
IN THE SE 1/4 OF THE SW 1/4 SECTION 24
TOWN 1 NORTH, RANGE 15 EAST
TOWN OF SHARON
WALWORTH COUNTY, WISCONSIN

Filed
MAR. 18,2008 AT 04:04PM
Vol~~XXX~~ 26 Pag~~XXXX~~ 68
CONNIE J WOOLEVER
REGISTER OF DEEDS
WALWORTH COUNTY, WI
Fee Amount: $15.00

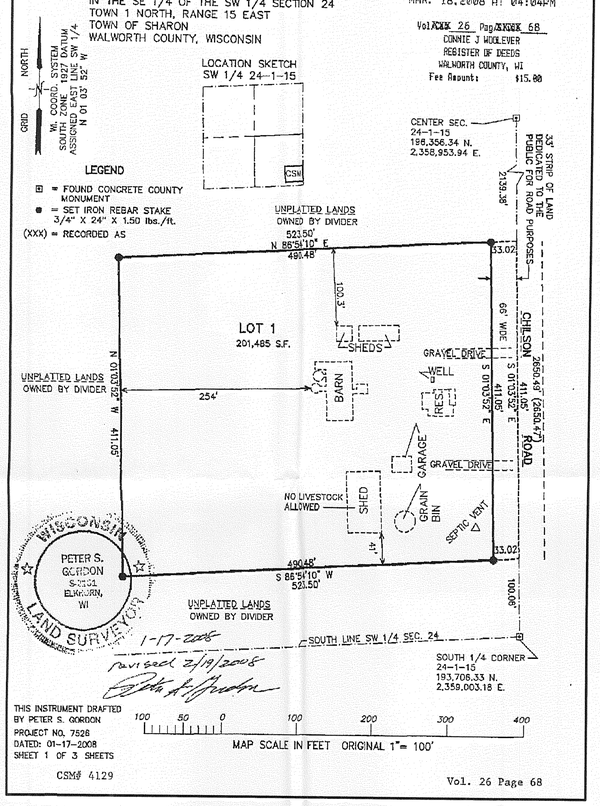

WISCONSIN PETER S. GORDON S-2101 ELKHORN, WI LAND SURVEYOR

1-17-2008
revised 2/19/2008

THIS INSTRUMENT DRAFTED BY PETER S. GORDON
PROJECT NO. 7526
DATED: 01-17-2008
SHEET 1 OF 3 SHEETS

CSM# 4129

Vol. 26 Page 68

RECEIVED
SEP 30 2008

NOTE: COPIES OF THIS MAP TO WHICH THE FOLLOWING CERTIFICATE WILL APPLY SHOW THE SURVEYOR'S ORIGINAL SEAL AND SIGNATURE IN RED INK. COPIES BY ANY OTHER MEANS MAY HAVE ALTERATIONS WHICH DO NOT REPRESENT THE SURVEYOR'S WORK PRODUCT.

I HEREBY CERTIFY THAT THE ABOVE DESCRIBED PROPERTY HAS BEEN SURVEYED UNDER MY DIRECTION AND THAT THE ABOVE MAP IS A TRUE REPRESENTATION THEREOF AND SHOWS THE SIZE AND LOCATION OF THE PROPERTY AND ITS EXTERIOR BOUNDARIES. THIS SURVEY IS MADE FOR THE USE OF THE PRESENT OWNERS OF THE PROPERTY, AND ALSO THOSE WHO PURCHASE, MORTGAGE, OR GUARANTEE THE TITLE THERETO WITHIN ONE YEAR FROM THE DATE HEREOF.

DATED: 5/1/2008

REVISED 09-10-2008
TO SHOW SIZE & LOCATION OF
AS BUILT FOUNDATION

WISCONSIN PETER S. GORDON S-2101 ELKHORN, WI LAND SURVEYOR

PETER S. GORDON R.L.S. 2101

PLAT OF SURVEY

– WORK ORDERED BY –
KUAT JUNGHEN
W7930 COUNTY ROAD X
DARIEN, WI 53114

FARRIS, HANSEN & ASSOCIATES, INC.
ENGINEERING – ARCHITECTURE – SURVEYING
7 RIDGWAY COURT P.O. BOX 437
ELKHORN, WISCONSIN 53121
OFFICE: (262) 723-2098 FAX: (262) 723-5886

REVISIONS

PROJECT NO. 7526.08
DATE 05/01/2008
SHEET NO. 1 OF 1

9/10/2008 X:\Projects\7526\7526_08\UCAD\PERMIT_20080501

AA4129-1

115-357