


Plat of Survey

of
Lot 1 of Certified Survey Map No. 3371,



recorded in Vol. 19 of Certified Survey Maps of Walworth County on
Page 153 and located in the Northwest 1/4 of Section 7, Town 1 North,
Range 15 East, Town of Sharon, Walworth County, Wisconsin.

Surveyed for: **Dan & Sue Jacobs**
N2001 Temperance Trail
Darien, Wisconsin. 53114

Tax Parcel
AS 700003

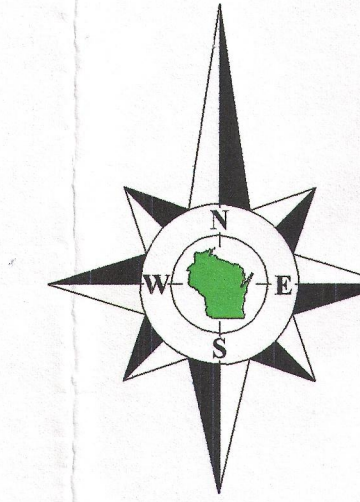


Bearings reference to the Wisconsin State
Plane Coordinate System, South Zone.

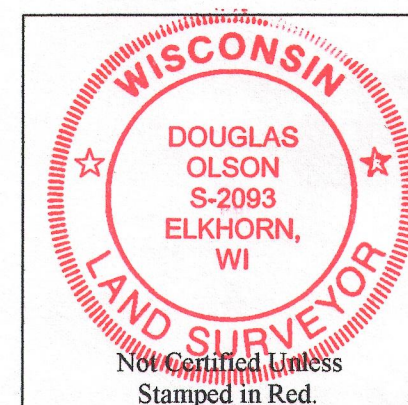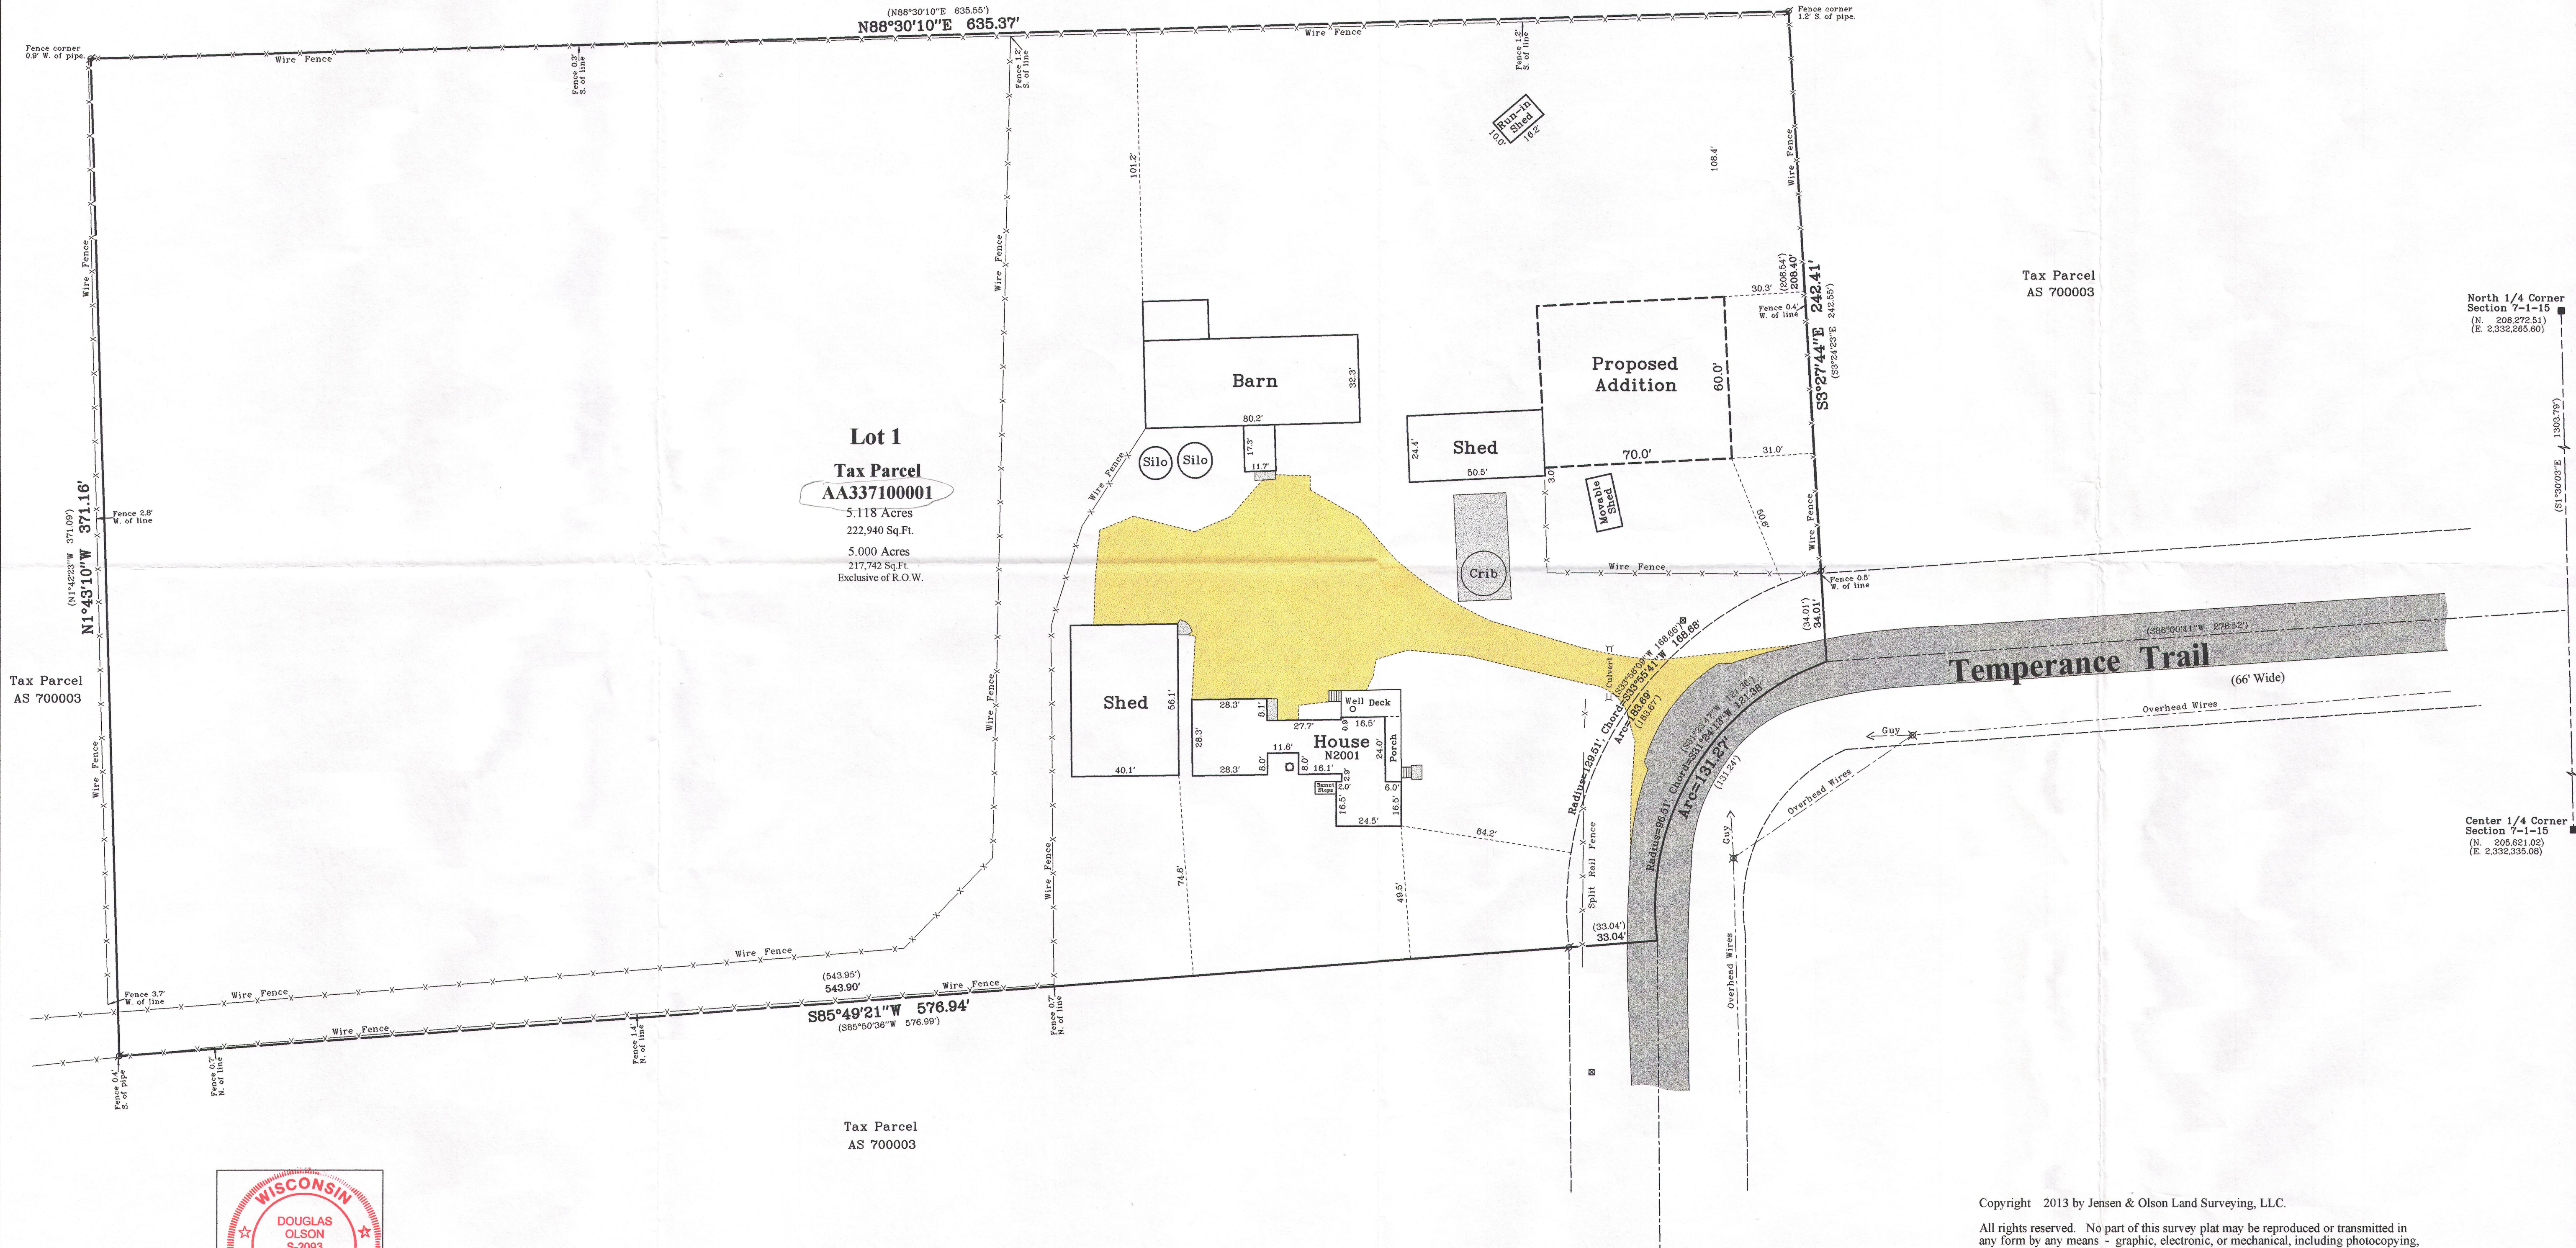

Notes:

- 1) This survey plat is not certified unless signed and sealed in red ink.
- 2) This survey is subject to Wisconsin lien laws. This Plat of Survey is the notice of intent to file lien. Lien waiver required.

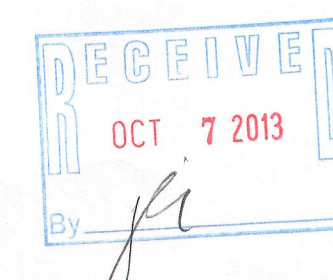


Copyright 2013 by Jensen & Olson Land Surveying, LLC.

All rights reserved. No part of this survey plat may be reproduced or transmitted in any form by any means - graphic, electronic, or mechanical, including photocopying, tracing, or information storage and retrieval systems - without permission in writing from Douglas G. Olson, Jensen & Olson Land Surveying, LLC.

I, Douglas G. Olson, Wisconsin Registered Land Surveyor, do hereby certify that this survey was performed by me, or under my direction in full compliance with the owner's/agent's instructions and Chapter A-E 7 of the Wisconsin Administrative Code "Minimum Standards for Property Surveys"; and that this map is an accurate representation thereof to the best of my knowledge and belief.

Douglas G. Olson
Wisconsin Registered Land Surveyor - 2093

Survey date: June 17, 2013.
Revisions:

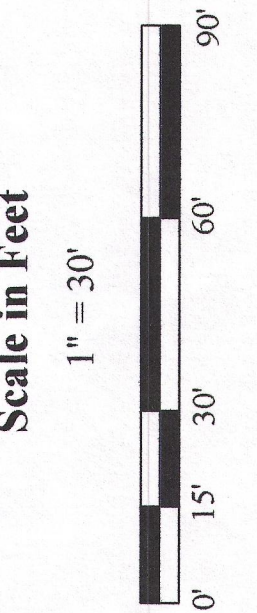

Jensen & Olson Land Surveying, LLC



45 South Wisconsin Street * P.O. Box 322 * Elkhorn, Wisconsin. 53121
Telephone: (262) 723-3434 * Facsimile: (262) 723-8044
Email: jensen.olson@elknet.net

Legend
Record County Section Corner Location
Recorded Information
Utility Pole
Survey Corner
Asphalt Surface
Gravel Surface

Sheet 1 of 1 Sheets
Drawing Name: 1115-2013049-2013049.dwg

Job Reference Number
2013.049

2013.049

115-408