LAND-MARK SURVEYING
Mark L. Miritz
Wisconsin Professional Land Surveyor S-2582

N9330 Knuteson Drive
Whitewater, WI 53190
Phone:(262)495-3284
MARKMIRITZ@
LAND-MARKSURVEYING.COM

PLAT OF SURVEY

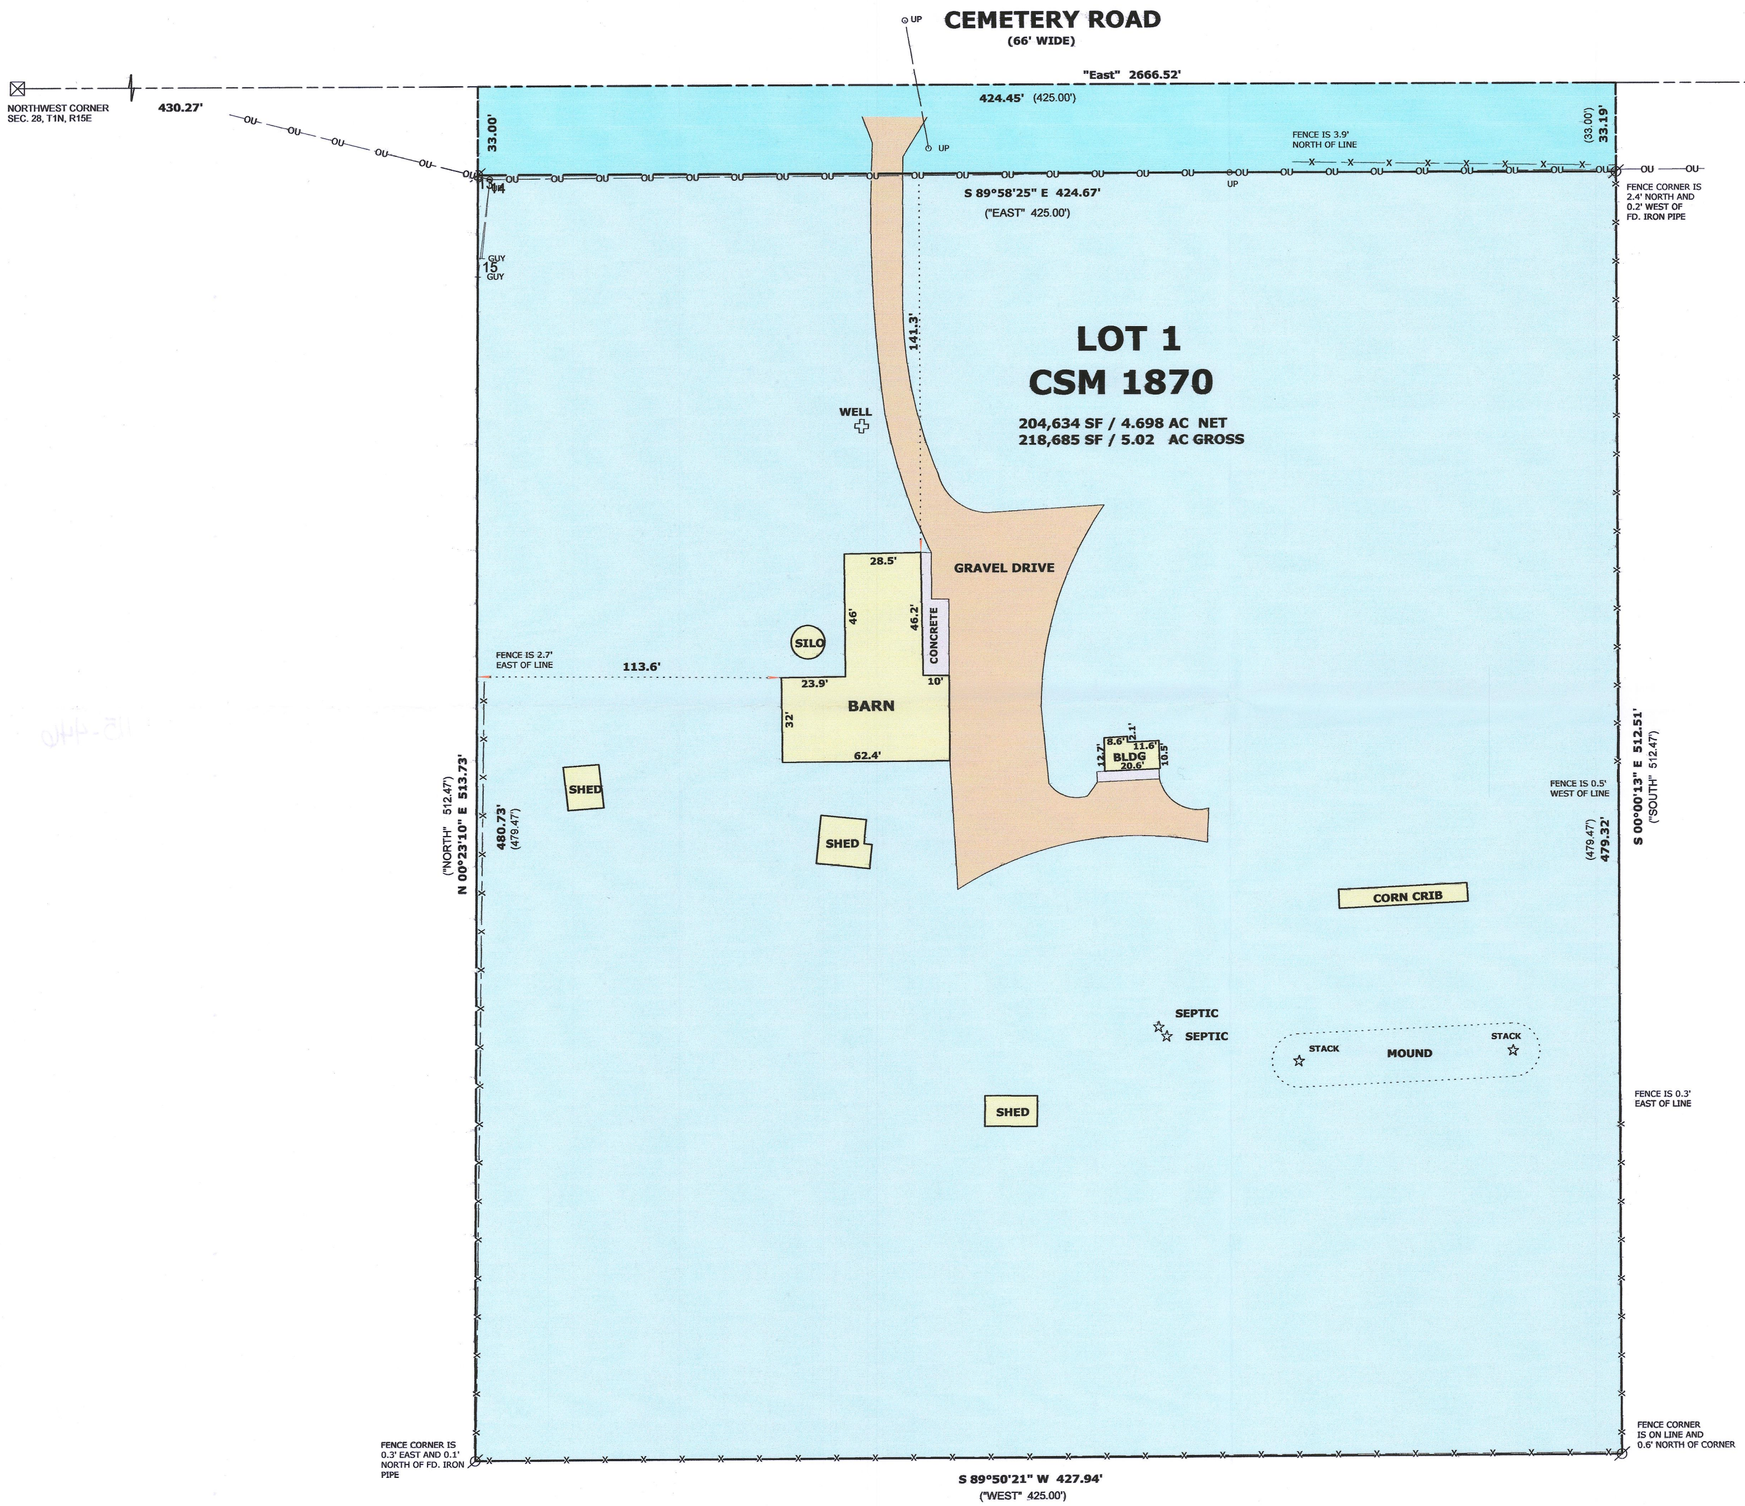

LEGAL DESCRIPTION

LOCATED IN THE NORTHWEST 1/4 OF THE NORTHWEST 1/4, SECTION 28, TOWNSHIP 1 NORTH, RANGE 15 EAST, IN THE TOWN OF SHARON, WALWORTH COUNTY, WISCONSIN.

LOT 1 OF CERTIFIED SURVEY MAP NO. 1870 RECORDED IN VOL. 9 OF CERTIFIED SURVEY MAPS, AT PAGE 32, RECORDS OF WALWORTH COUNTY.

ORDERED BY:
STACEY SCHULTZ
KEEFE REAL ESTATE
751 GENEVA PARKWAY
LAKE GENEVA, WI 53147

BASIS OF BEARINGS:
THE NORTH LINE OF THE NORTHWEST 1/4, SEC. 28, T1N, R15E BEING "EAST"

RECEIVED
SEP 1 2017
By SMF

LEGEND

○	UTILITY POLE
—OU—	OVERHEAD UTILITY LINES
⌀	FOUND IRON PIPE
⊠	FOUND COUNTY MONUMENT
(x x)	RECORDED AS DIMENSION
—x—x—	EXISTING FENCE

SCALE: 1 INCH= 40 FEET

"I hereby certify that the above described property has been surveyed by me or under my direction and that the above map is a true representation thereof and shows the size and location of the property, its exterior boundaries, the location of all visible structures and dimensions of all principal buildings thereon, boundary fences, apparent easements, roadways and visible encroachments, if any." "This survey is made for the use of the present owners of the property, and also those who purchase, mortgage, or guarantee the title thereto within one year from date hereof."

WISCONSIN
MARK L. MIRITZ
S-2582
WHITEWATER, WI
LAND SURVEYOR

Mark L. Miritz
MARK L. MIRITZ
WISCONSIN PROFESSIONAL LAND SURVEYOR S-2582

DATE: AUGUST 19, 2017 **JOB NO. 17.810**

AA1870-1

115-446