
GEORGE T. DUNHAM
SURVEYING & SUBDIVIDING
DELAVAN, WISCONSIN

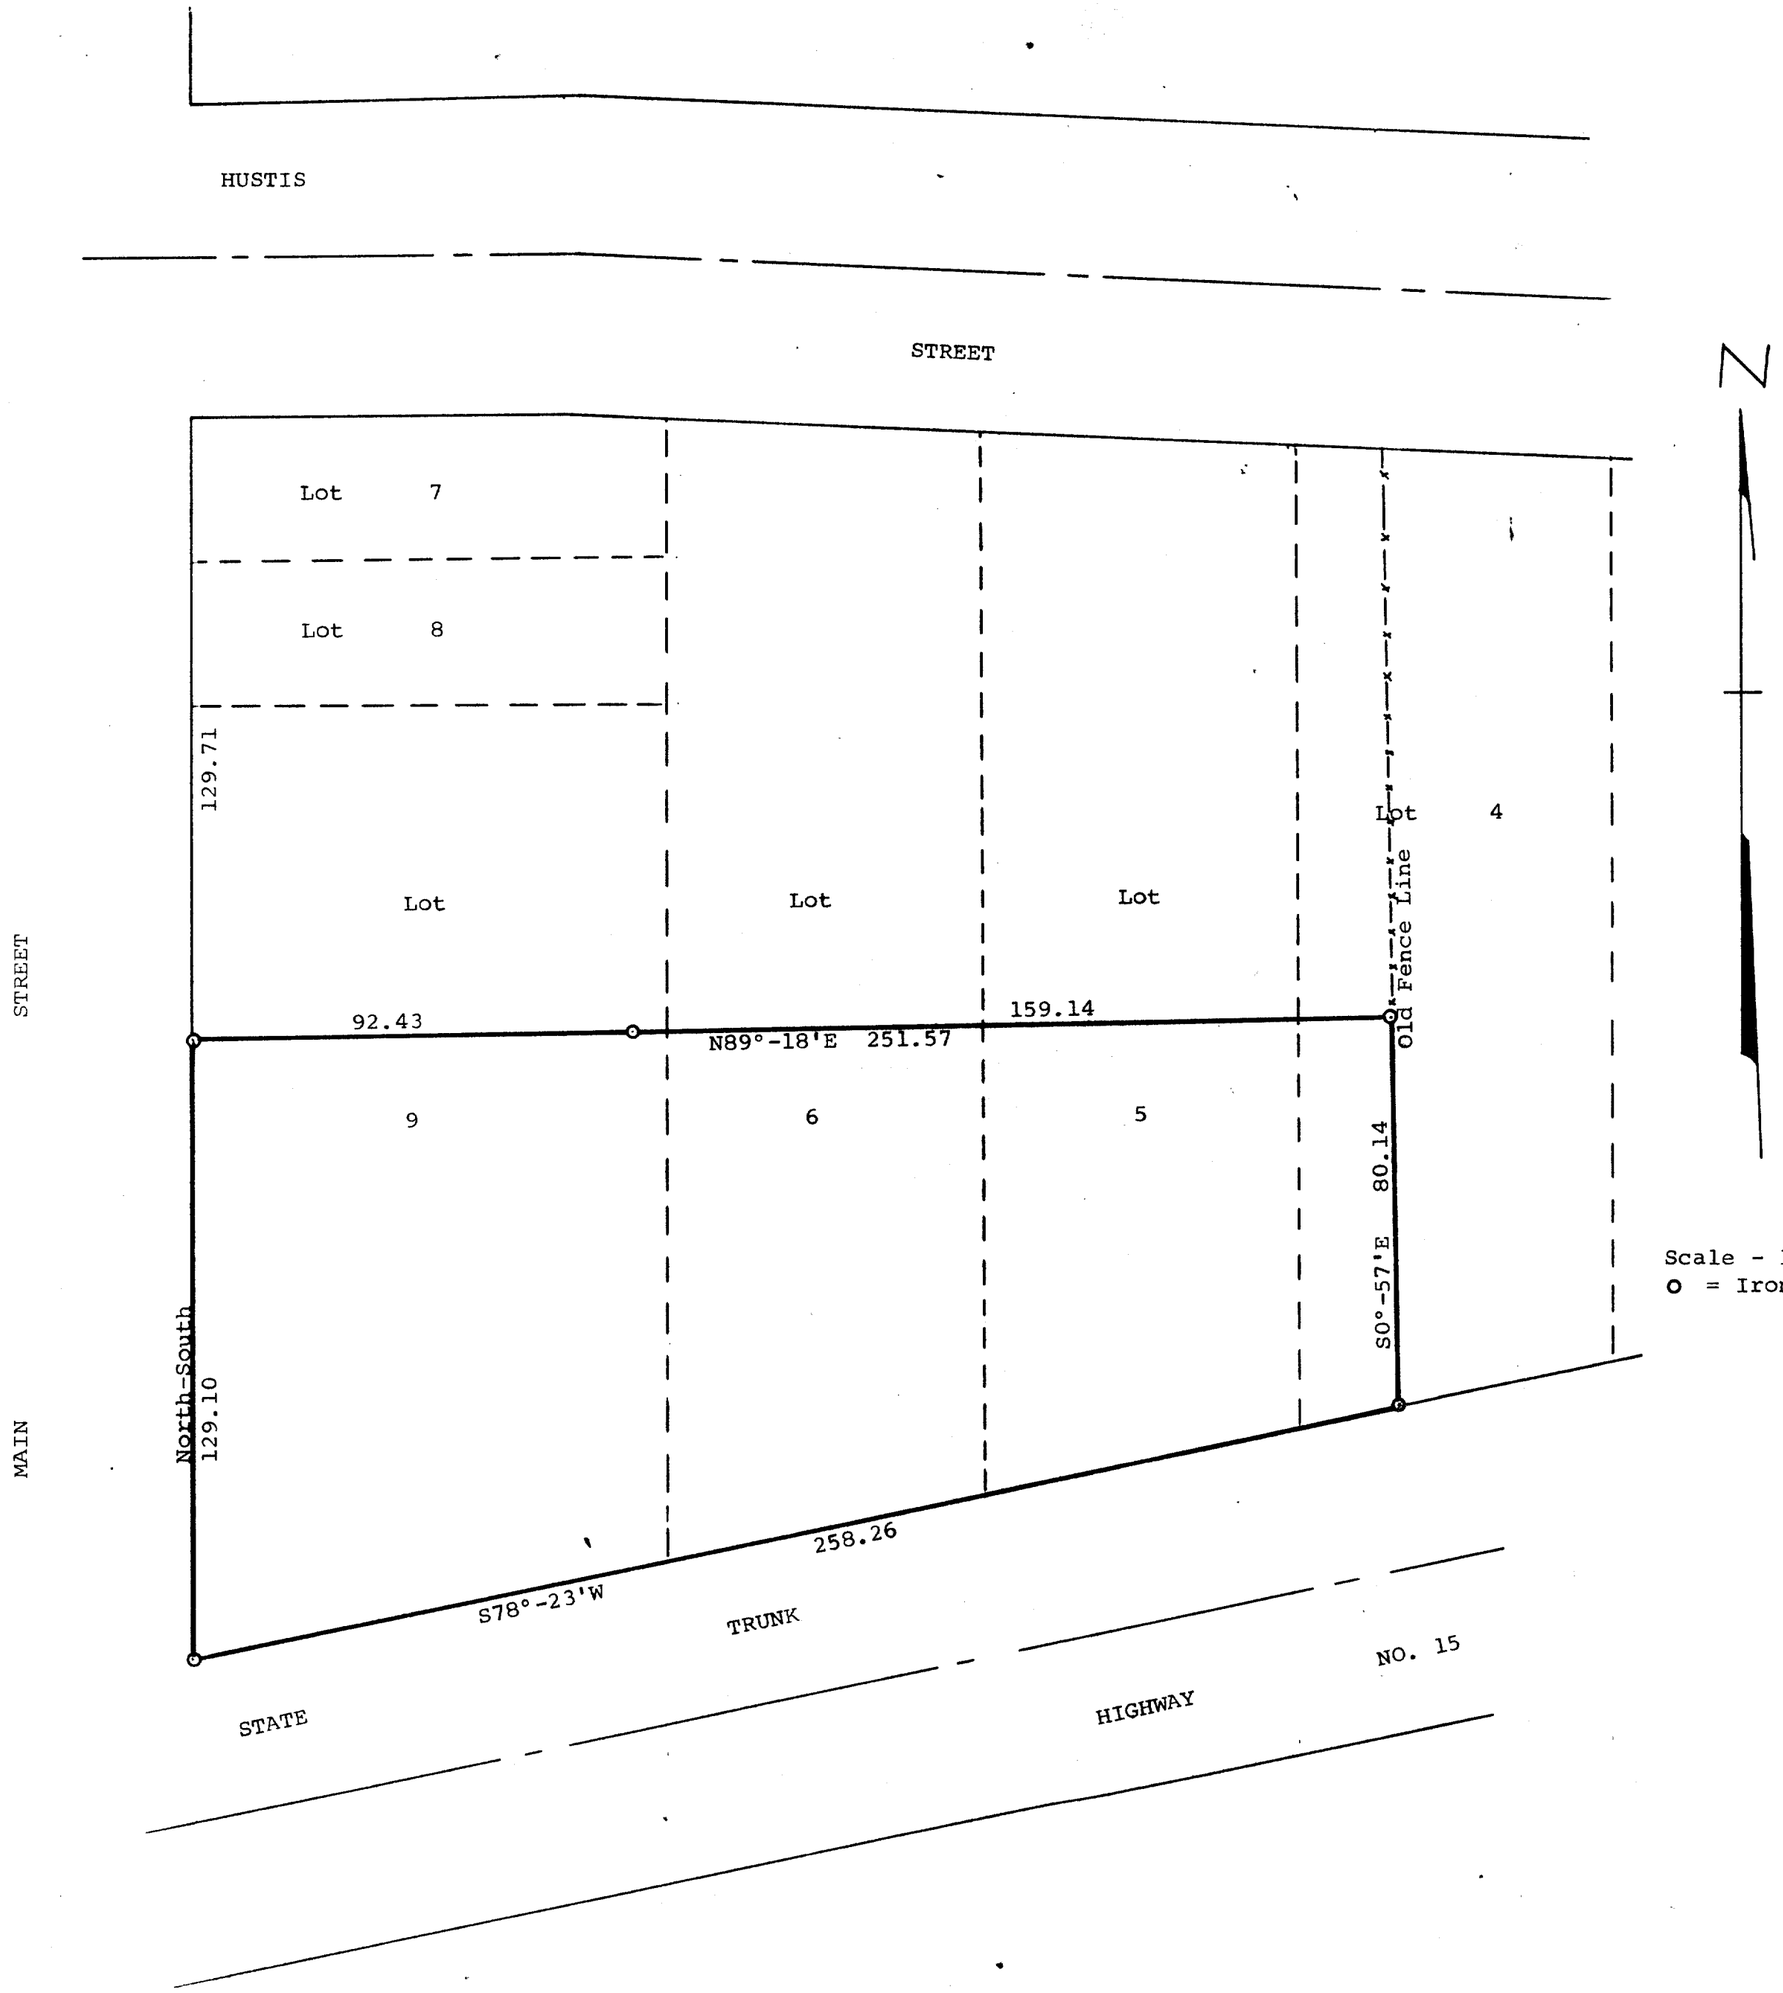

Scale - 1" = 30'
O = Iron Pipe

Plat of survey of land located in Lots 4, 5, 6, and 9, Block 10 of the Original Plat of the Village of Allens Grove, Walworth County, Wisconsin.
January 14, 1971

George T. Dunham

George T. Dunham, Surveyor

AAG-00019

115-66
12-5
~~215-100~~