


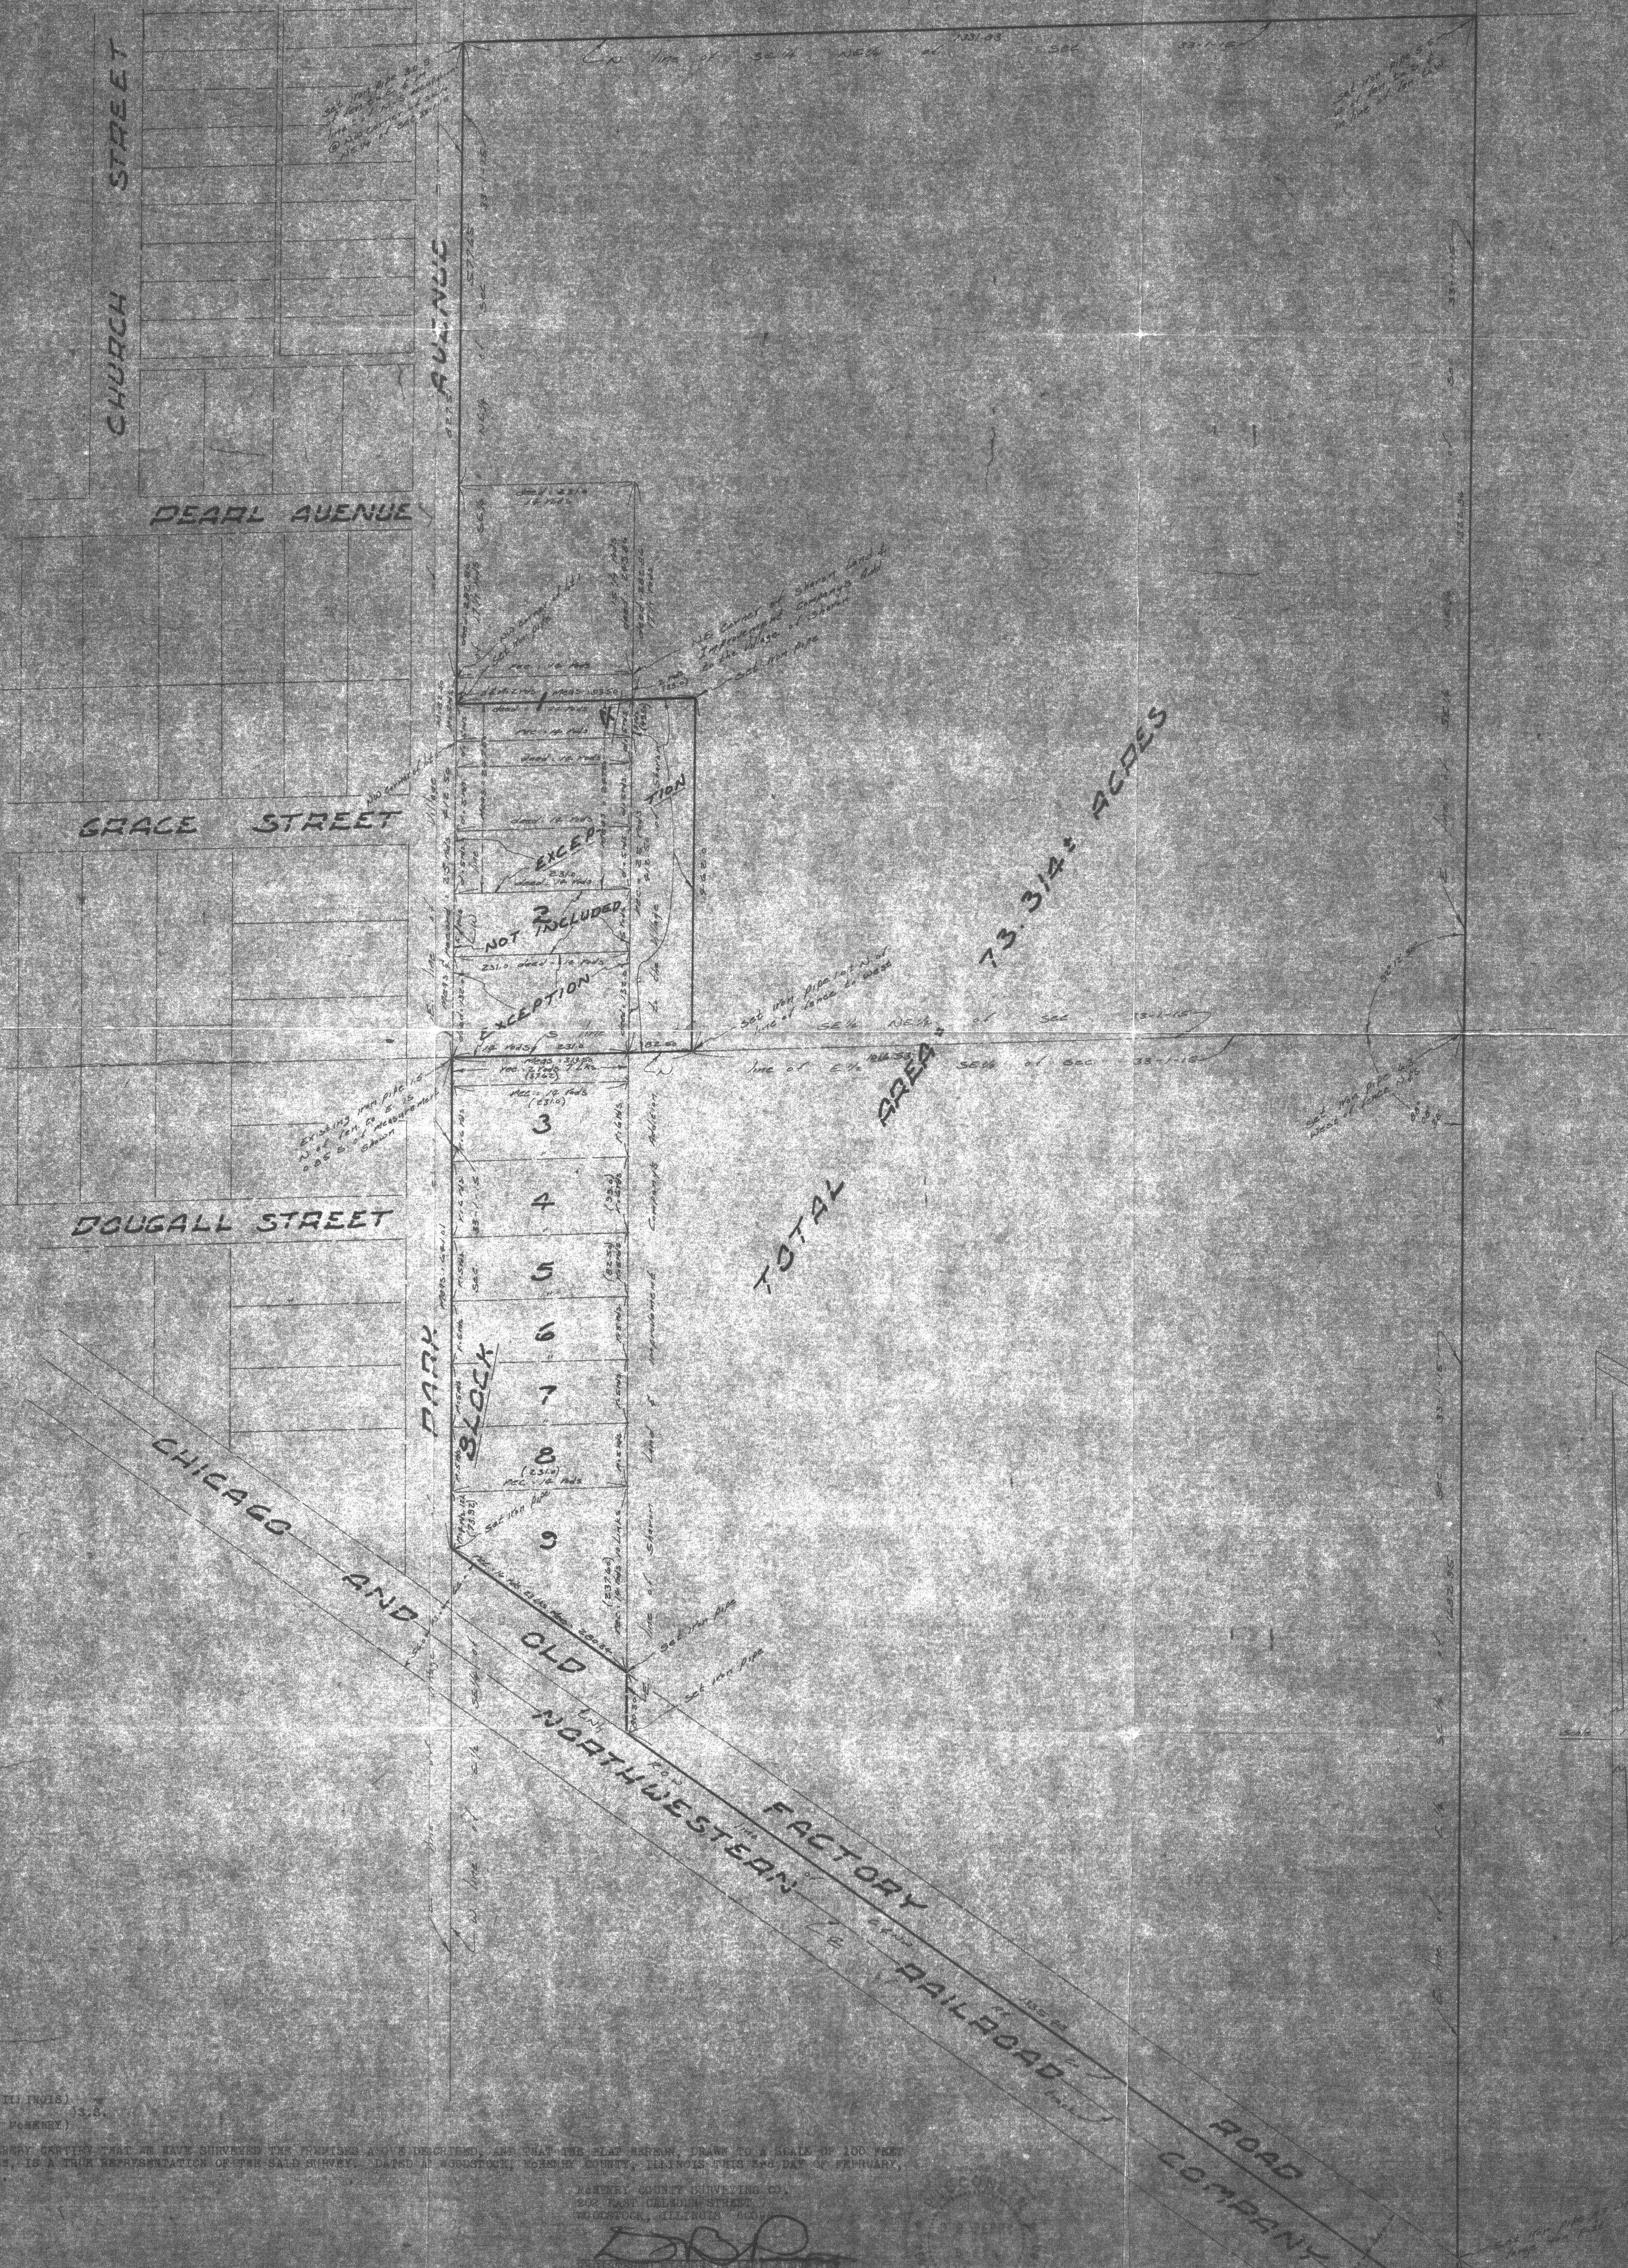

STATE OF ILLINOIS) -

I HEREBY CERTIFY THAT WE HAVE SURVEYED THE PREMISES AS ABOVE DESCRIBED, AND THAT THE PLAT HEREON, DRAWN TO A SCALE OF 100 FEET PER INCH, IS A TRUE REPRESENTATION OF THE SAID SURVEY. DATED AT WOODSTOCK, COCKER COUNTY, ILLINOIS THIS 28th DAY OF FEBRUARY, A.D. 1987.



