


X:\PROJECTS\5878\5878_22\ACAD\5878_22.dwg

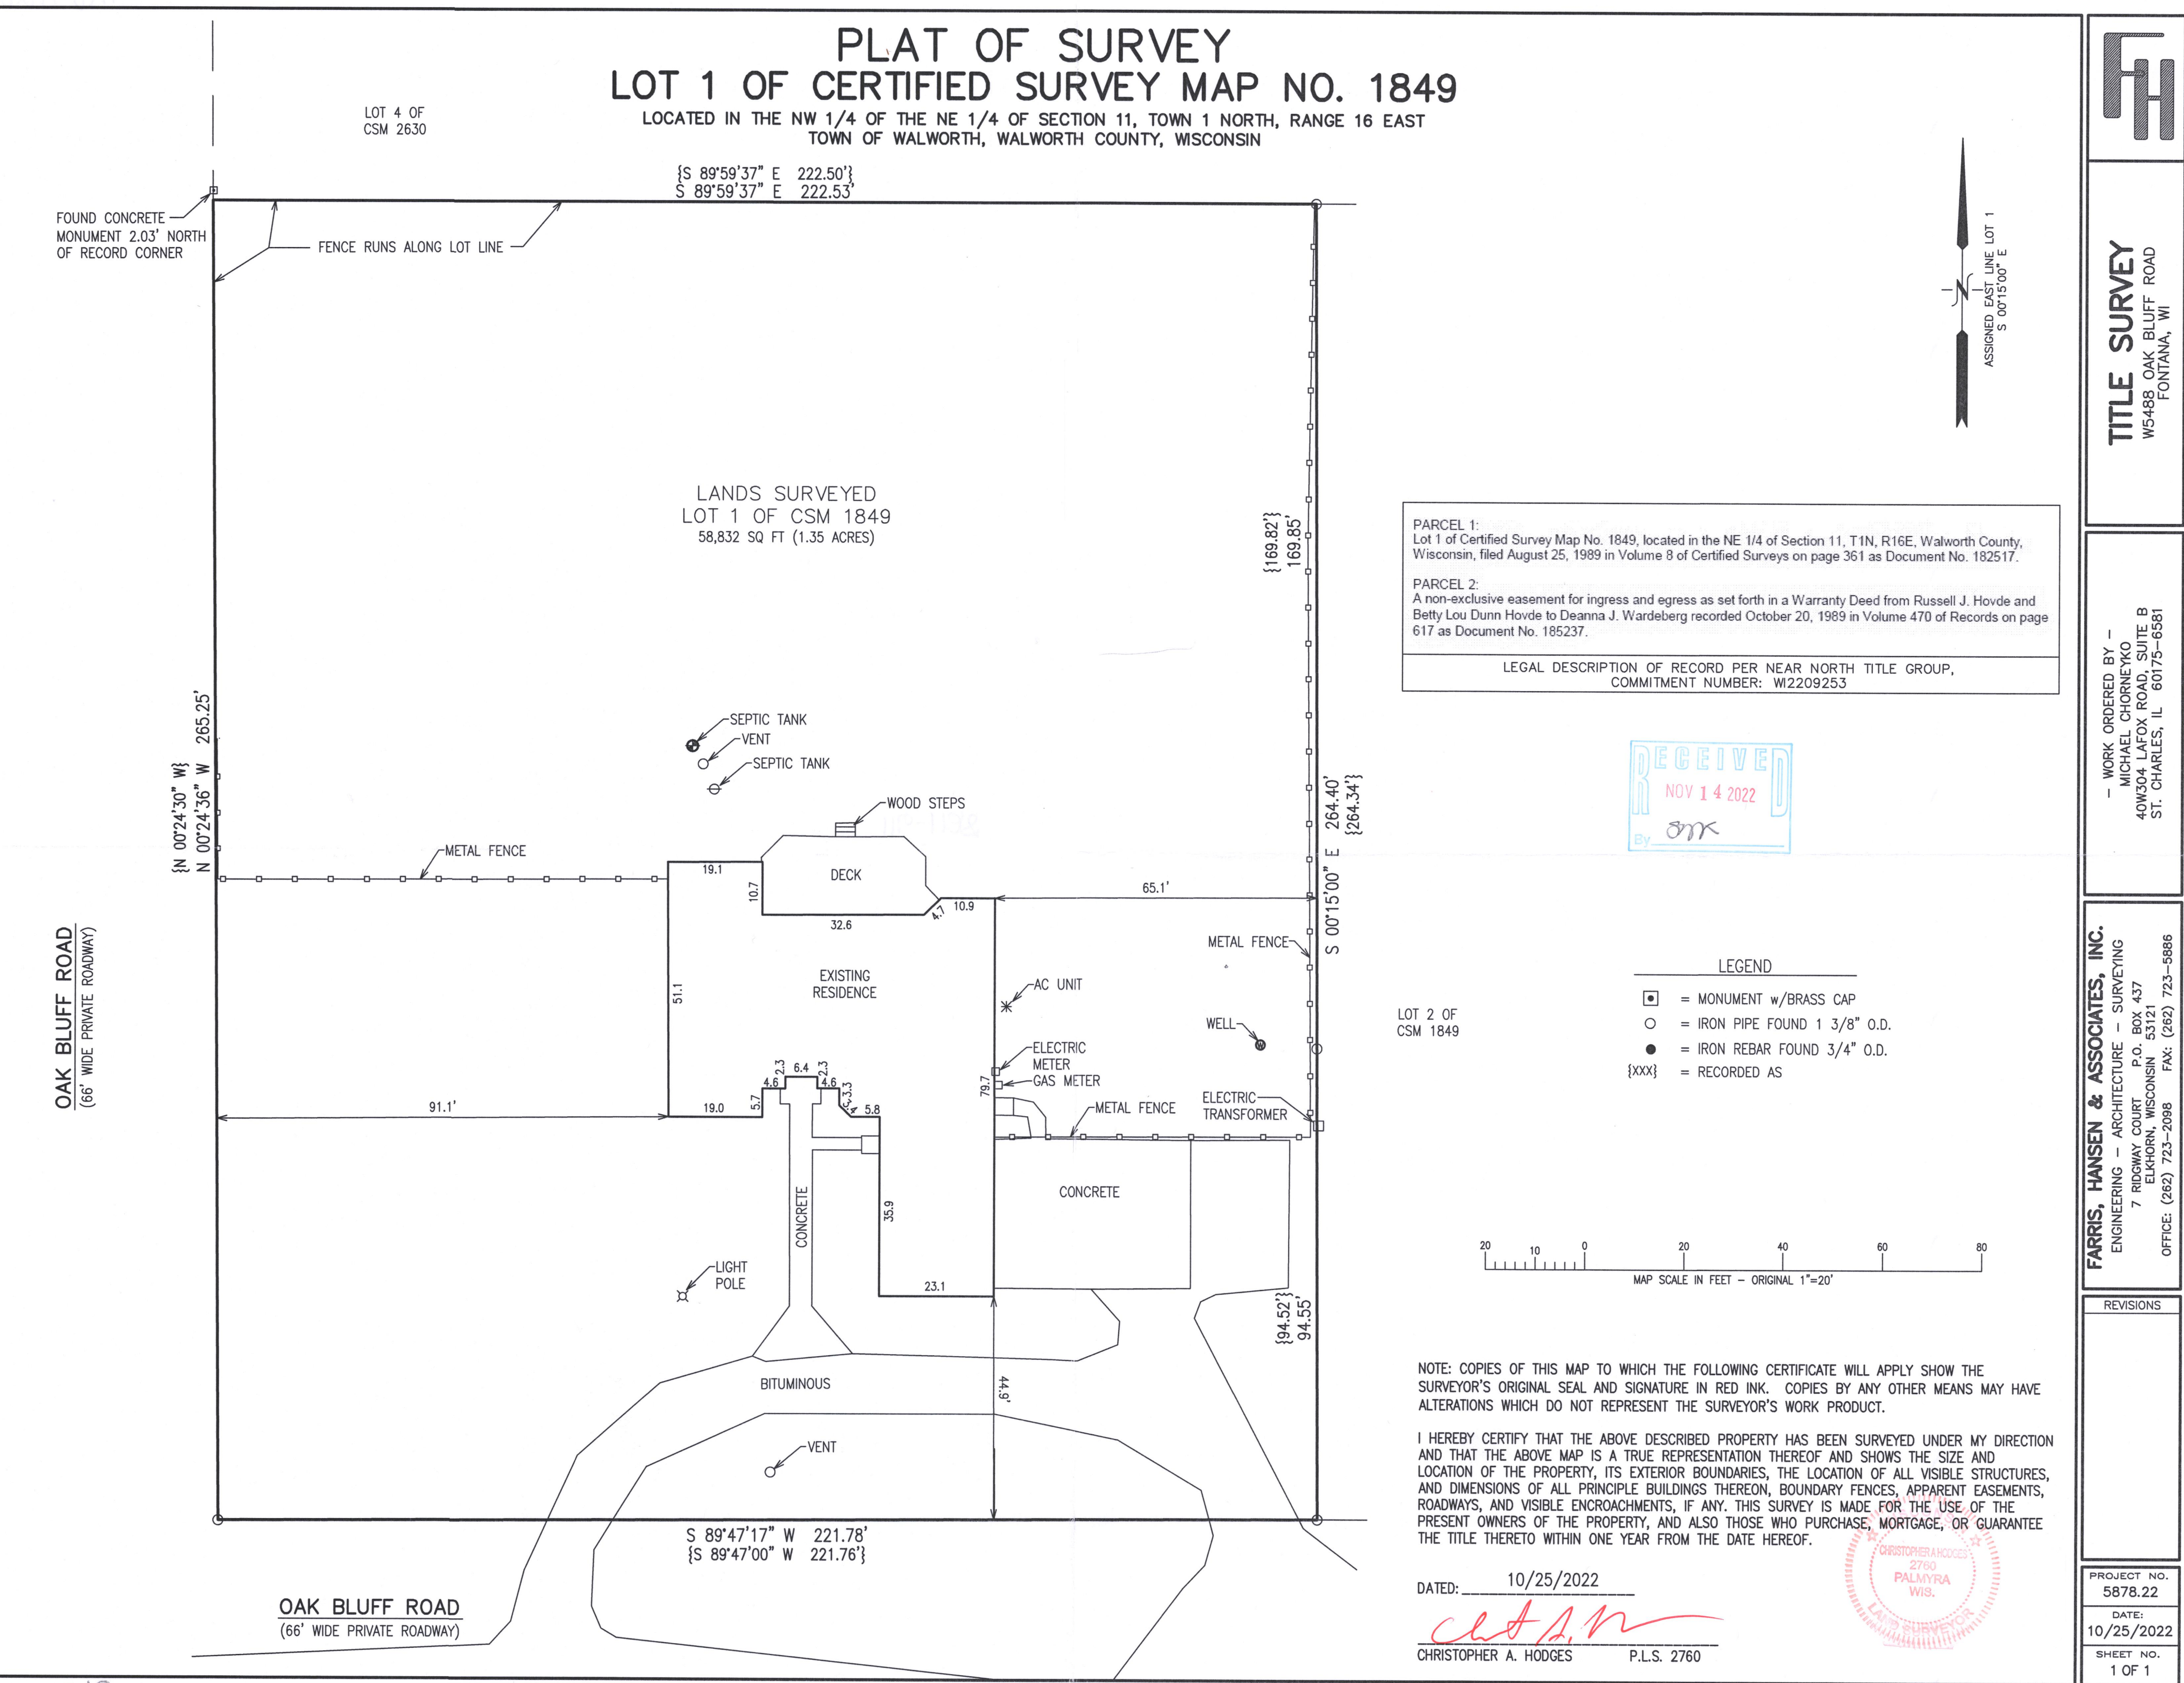

EA1849-1

116-1128