


PLAT OF SURVEY

LOT 1 OF CERTIFIED SURVEY MAP NO. 1728,
LOCATED IN THE SOUTHEAST 1/4 OF SECTION
16, TOWN 1 NORTH, RANGE 16 EAST, TOWN OF
WALWORTH, WALWORTH COUNTY, WISCONSIN.

SITE ADDRESS: W6175 BRICK CHURCH RD, WALWORTH

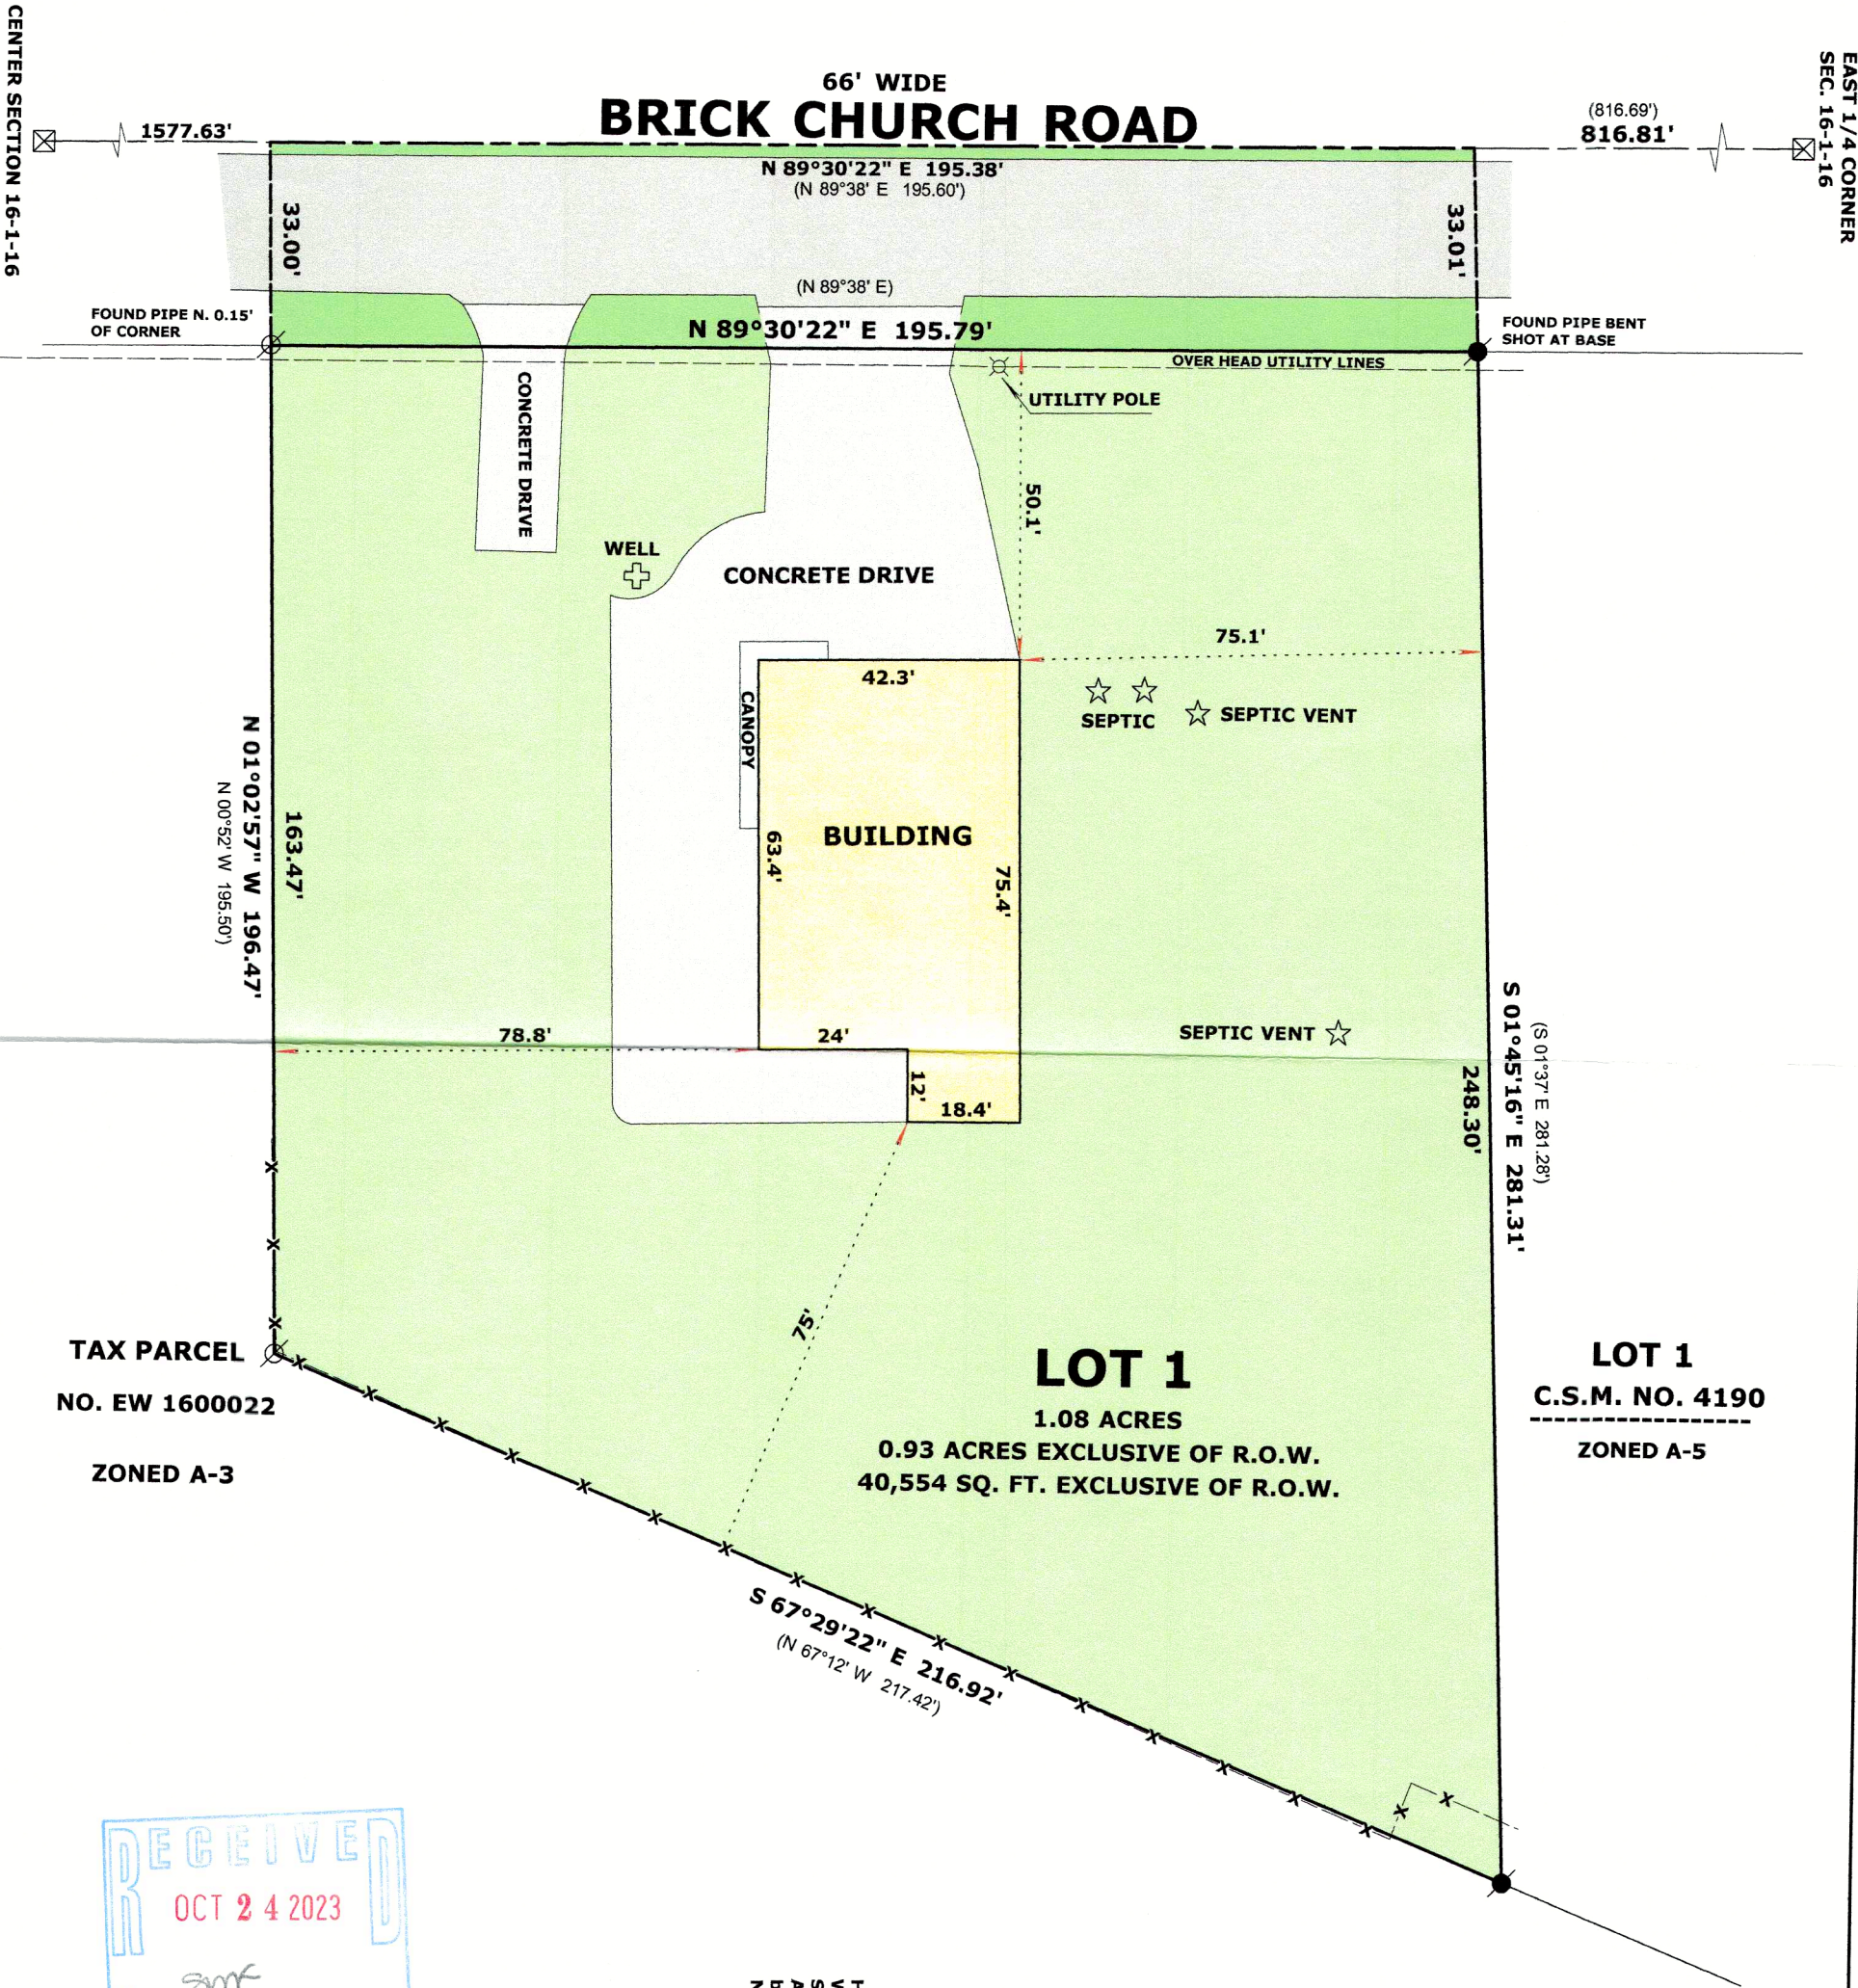


TAX PARCEL
NO. EW 1600022
ZONED A-3

LOT 1
C.S.M. NO. 4190
ZONED A-5

RECEIVED
OCT 24 2023
By *zmf*

- LEGEND**
- FOUND IRON PIPE 1"
 - FOUND IRON PIPE 1 1/4"
 - FOUND COUNTY MONUMENT
 - RECORDED AS DIMENSION
 - EXISTING CHAIN LINK FENCE

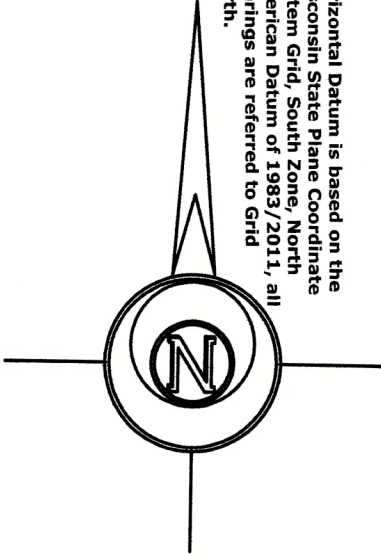

SCALE: 1 INCH = 30 FEET

"I hereby certify that the above described property has been surveyed by me or under my direction and that the above map is a true representation thereof and shows the size and location of the property, its exterior boundaries, the location of all visible structures and dimensions of all principal buildings thereon, boundary fences, apparent easements, roadways and visible encroachments, if any."

"This survey is made for the use of the present owners of the property, and also those who purchase, mortgage, or guarantee the title thereto within one year from date hereof."

Mark L. Miritz
MARK L. MIRITZ
WISCONSIN PROFESSIONAL
LAND SURVEYOR S-2582

DATE: OCT. 23, 2023 JOB NO. 16.105