
WALWORTH COUNTY
SURVEYING & MAPPING
LAKE GENEVA, WISCONSIN

RECEIVED
AUG 5 1985

PLAT OF SURVEY OF

PART OF LOT 4 OF ROBERTS SUBDIVISION LOCATED IN SECTION 11, T1N,R16E, ~~VILLAGE OF FONTANA-ON-GENEVA LAKE~~, WALWORTH COUNTY, WISCONSIN, AS DESCRIBED IN VOLUME 451, PAGE 229, WALWORTH COUNTY, WISCONSIN.

ORDERED BY: KEEFE REAL ESTATE
P.O.B. 268
WALWORTH, WI 53184

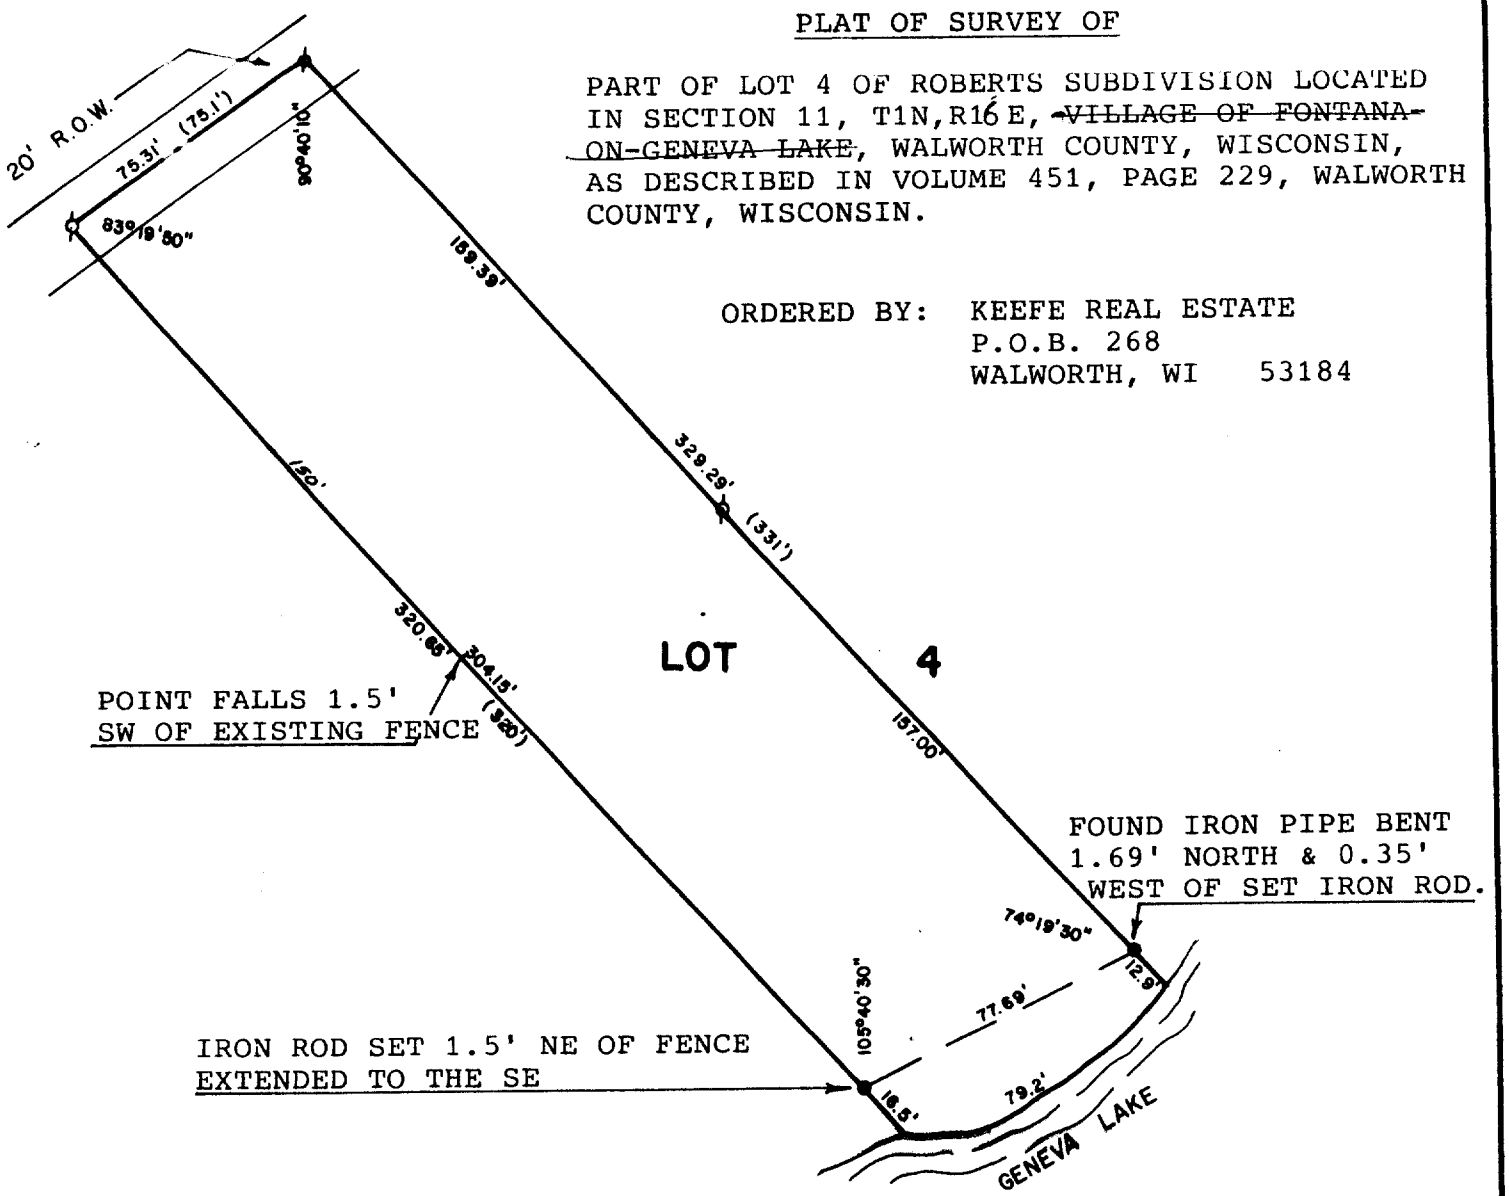

WISCONSIN
DAVID F. ABELL S-1596 Delavan, Wis.
LAND SURVEYOR

SCALE - 1"=50'

LEGEND
ø - IRON PIPE FOUND
● - IRON ROD SET
( ) - RECORDED AS

I, DAVID F. ABELL, DO HEREBY CERTIFY THAT I HAVE SURVEYED THE PROPERTY HEREON DESCRIBED ACCORDING TO THE OFFICIAL RECORDS, AND THAT THE PLAT HEREON IS A CORRECT REPRESENTATION OF THE PROPERTY LINES TO THE BEST OF MY KNOWLEDGE AND BELIEF.

David F. Abell
DAVID F. ABELL
WISCONSIN REGISTERED LAND SURVEYOR, S-1596

July 9, 1985
DATE JOB NUMBER 0303

ERB-3

116-193