
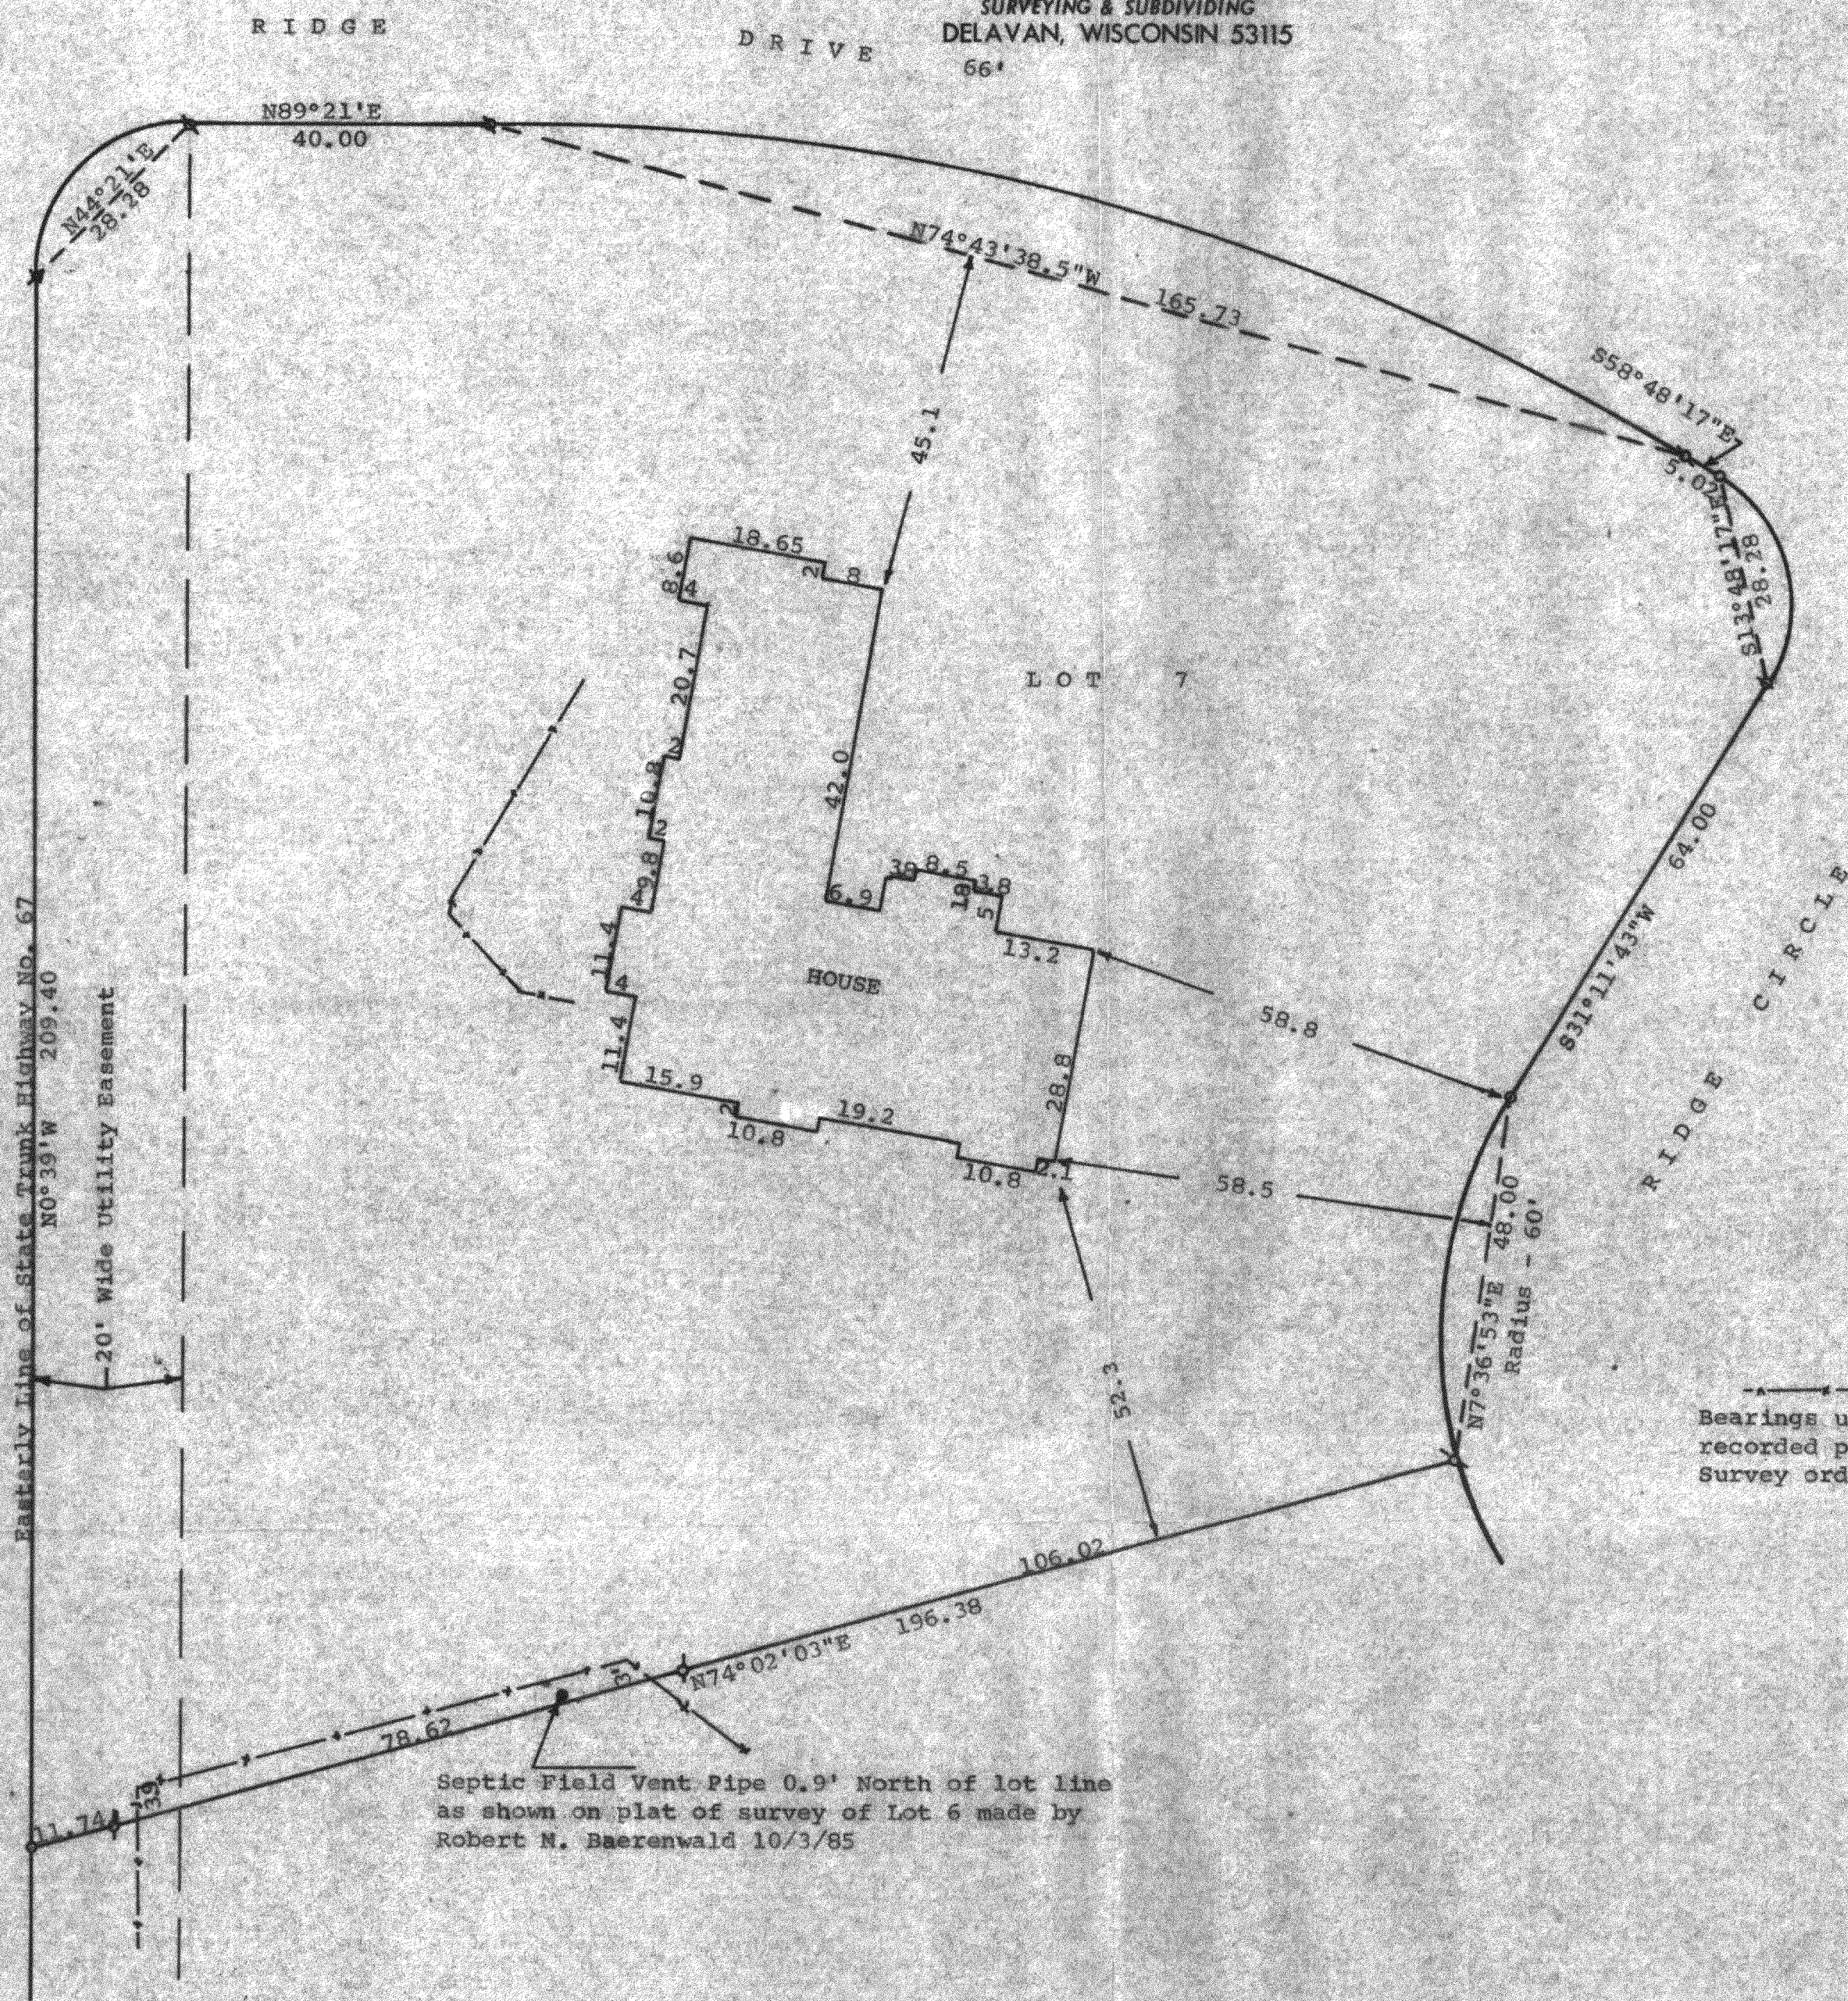


DUNHAM SURVEYING, S.C.

SURVEYING & SUBDIVIDING

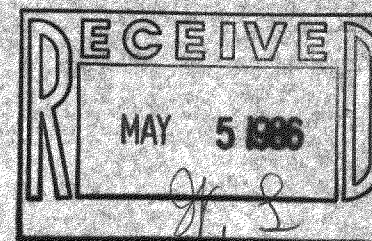

Scale - 1" = 20'
 x = 2" Iron Pipe Found
 o = 1" Iron Pipe Found
 v = 3/4" Iron Pipe Found
 q = 1/2" Iron Pipe Found
 □ = 1/2" X 24" Iron Pipe Set
 ○ = 3/4" X 24" Iron Pipe Set

--- = Fence Line
 Bearings used are those shown on the
 recorded plat of Sunset Ridge-Unit 1
 Survey ordered by: Ron Nyman
 Walworth, WI 53184

STATE OF WISCONSIN) ss
 COUNTY OF WALWORTH)

I, George T. Dunham, Surveyor, certify that I have surveyed
 the property described as follows:

Lot 7 in Sunset Ridge-Unit 1 located in the Northwest 1/4 of
 the Northwest 1/4 of Section 11, T 1 N, R 16 E, Walworth County,
 Wisconsin,

and that the map shown above is a true representation thereof and shows
 the size and location of the property, its exterior boundaries, the
 location of all visible structures and dimensions of all principal buildings
 thereon, boundary fences, apparent easements, roadways and visible encroach-
 ments, if any, and that I have surveyed the property hereon described according
 to the official records, to the best of my knowledge and belief.

March 4, 1986

George T. Dunham
 George T. Dunham, Surveyor

