


**SURVEYING & SUBDIVIDING
DELAN, WISCONSIN 53115**



SOUTH SHORE DRIVE

(LAKE ROAD)

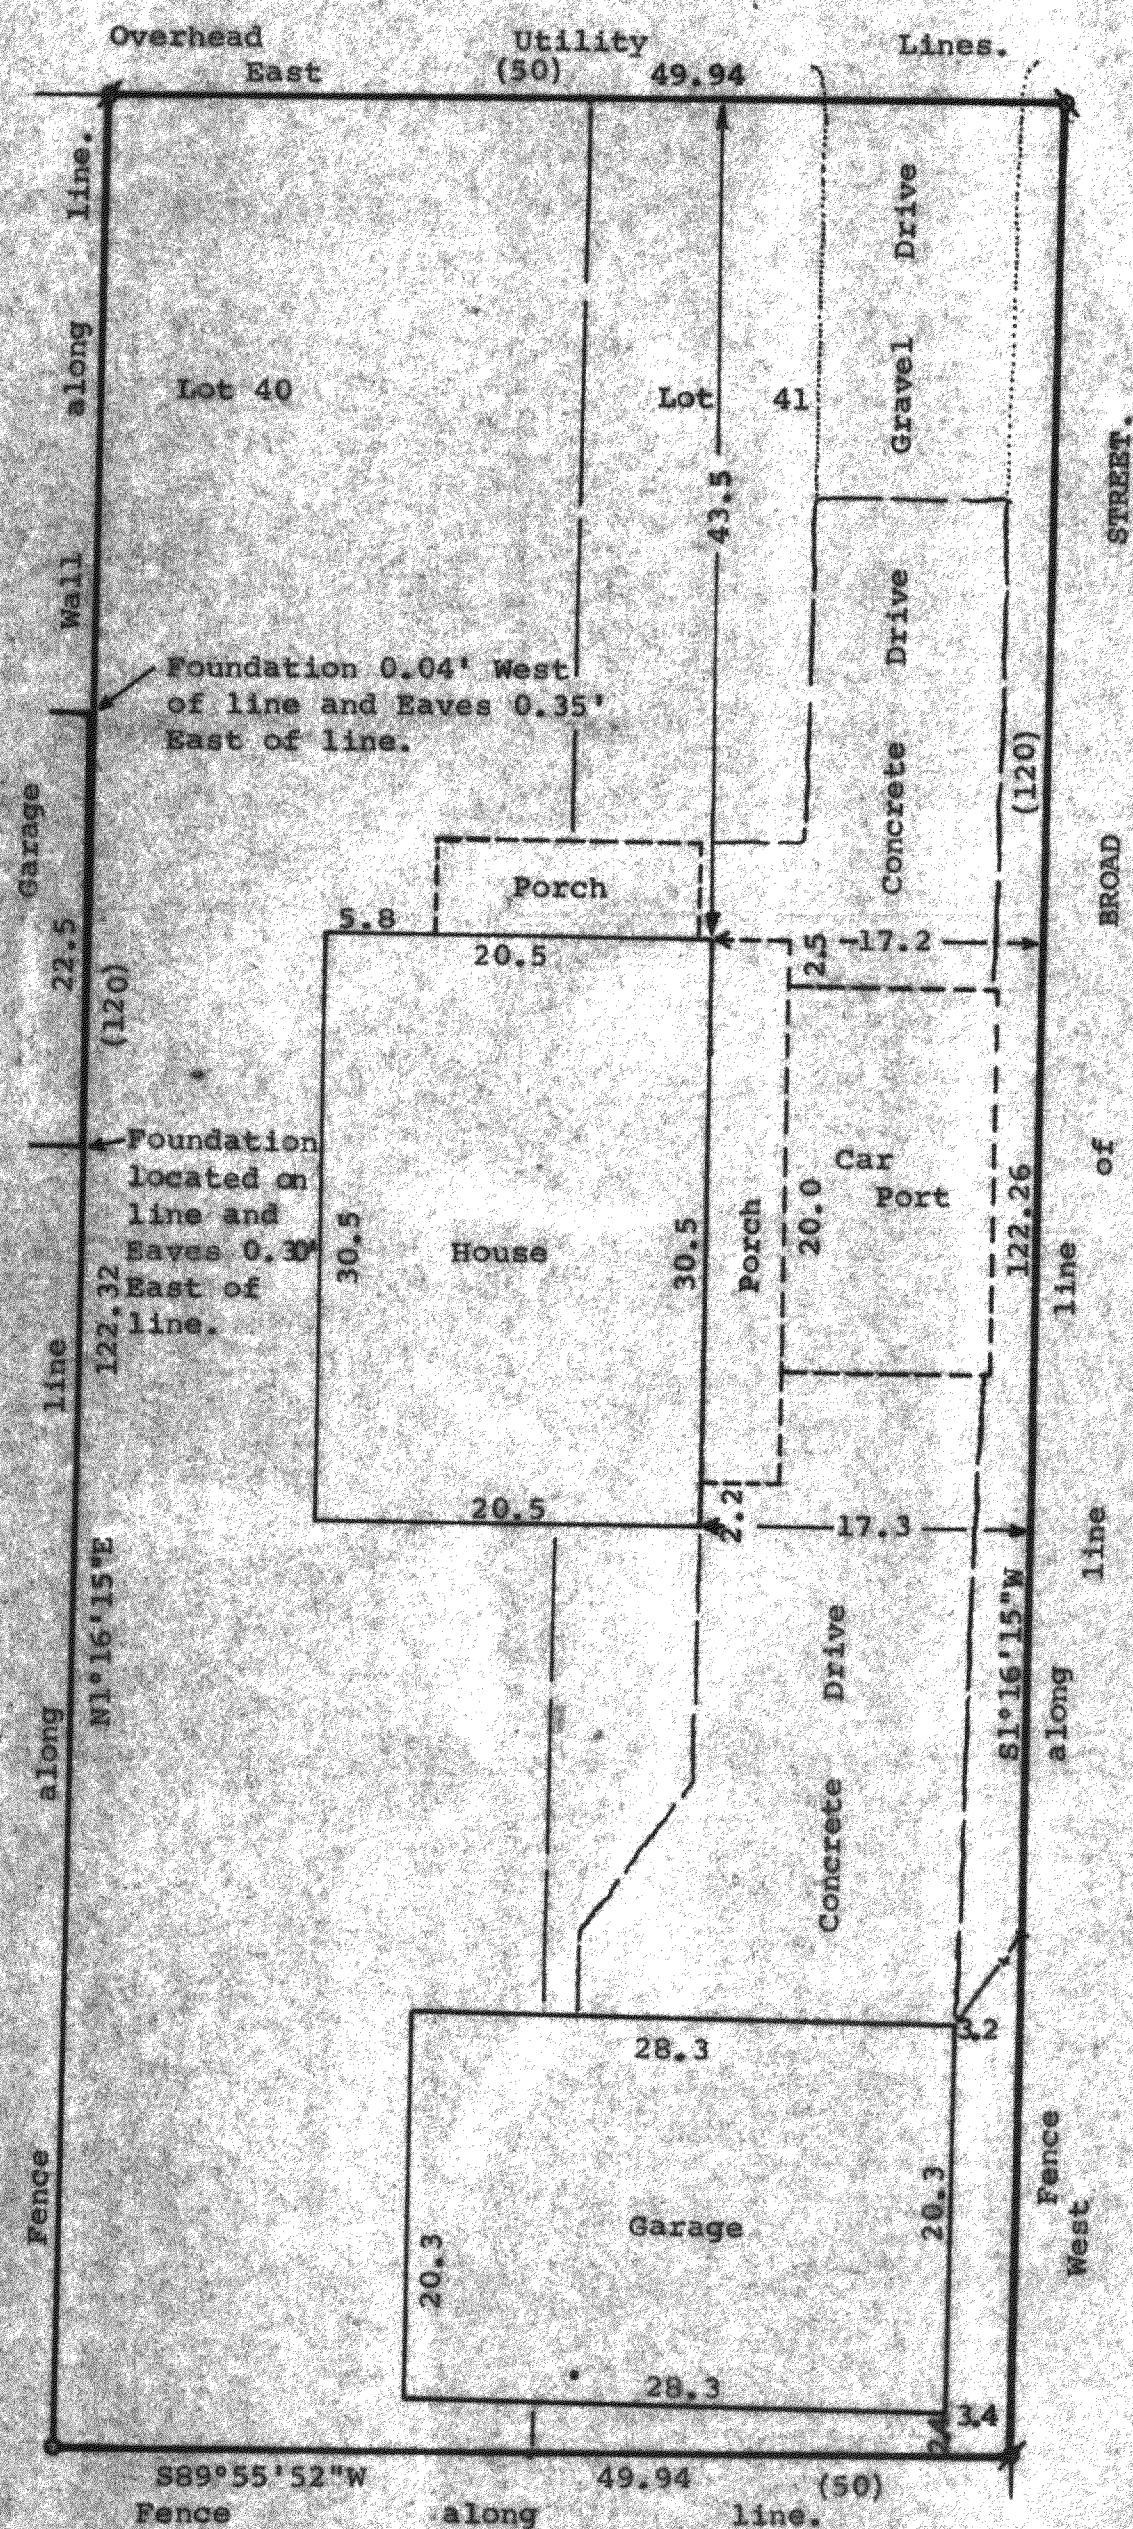

Scale - 1" = 10'
 Ø = 2" Dia. Iron Pipe Found
 Ø = 3/4" Dia. Iron Pipe Found
 Ø = 1/2" Dia. Iron Pipe Found

Bearings are referenced to the assumed bearing of East, along the North line of Lots 40 and 41 of Robbins Subdivision.

Owner: Richard Pfeiffer
708 S. Shore Drive
Delavan, Wisconsin 53115

STATE OF WISCONSIN)
COUNTY OF WALWORTH) SS

I, Richard C. Schulz, Surveyor, certify that I have surveyed the property described as follows, Lots 40 and 41, Block 4 of Robbins Subdivision, located in the Northwest $\frac{1}{4}$ of Section 5, T1N, R16E, Walworth County, Wisconsin.

and that the map shown above is a true representation thereof and shows the size and location of the property, its exterior boundaries, the location of all visible structures and dimensions of all principal buildings thereon, boundary fences, apparent easements, roadways and visible encroachments, if any, and that I have surveyed the property hereon described according to the official records to the best of my knowledge and belief.

July 19, 1984.

Richard C. Schulz
Richard C. Schulz, Surveyor

