


DUNHAM SURVEYING, S.C.
SURVEYING & SUBDIVIDING
DELAVER, WISCONSIN 53115

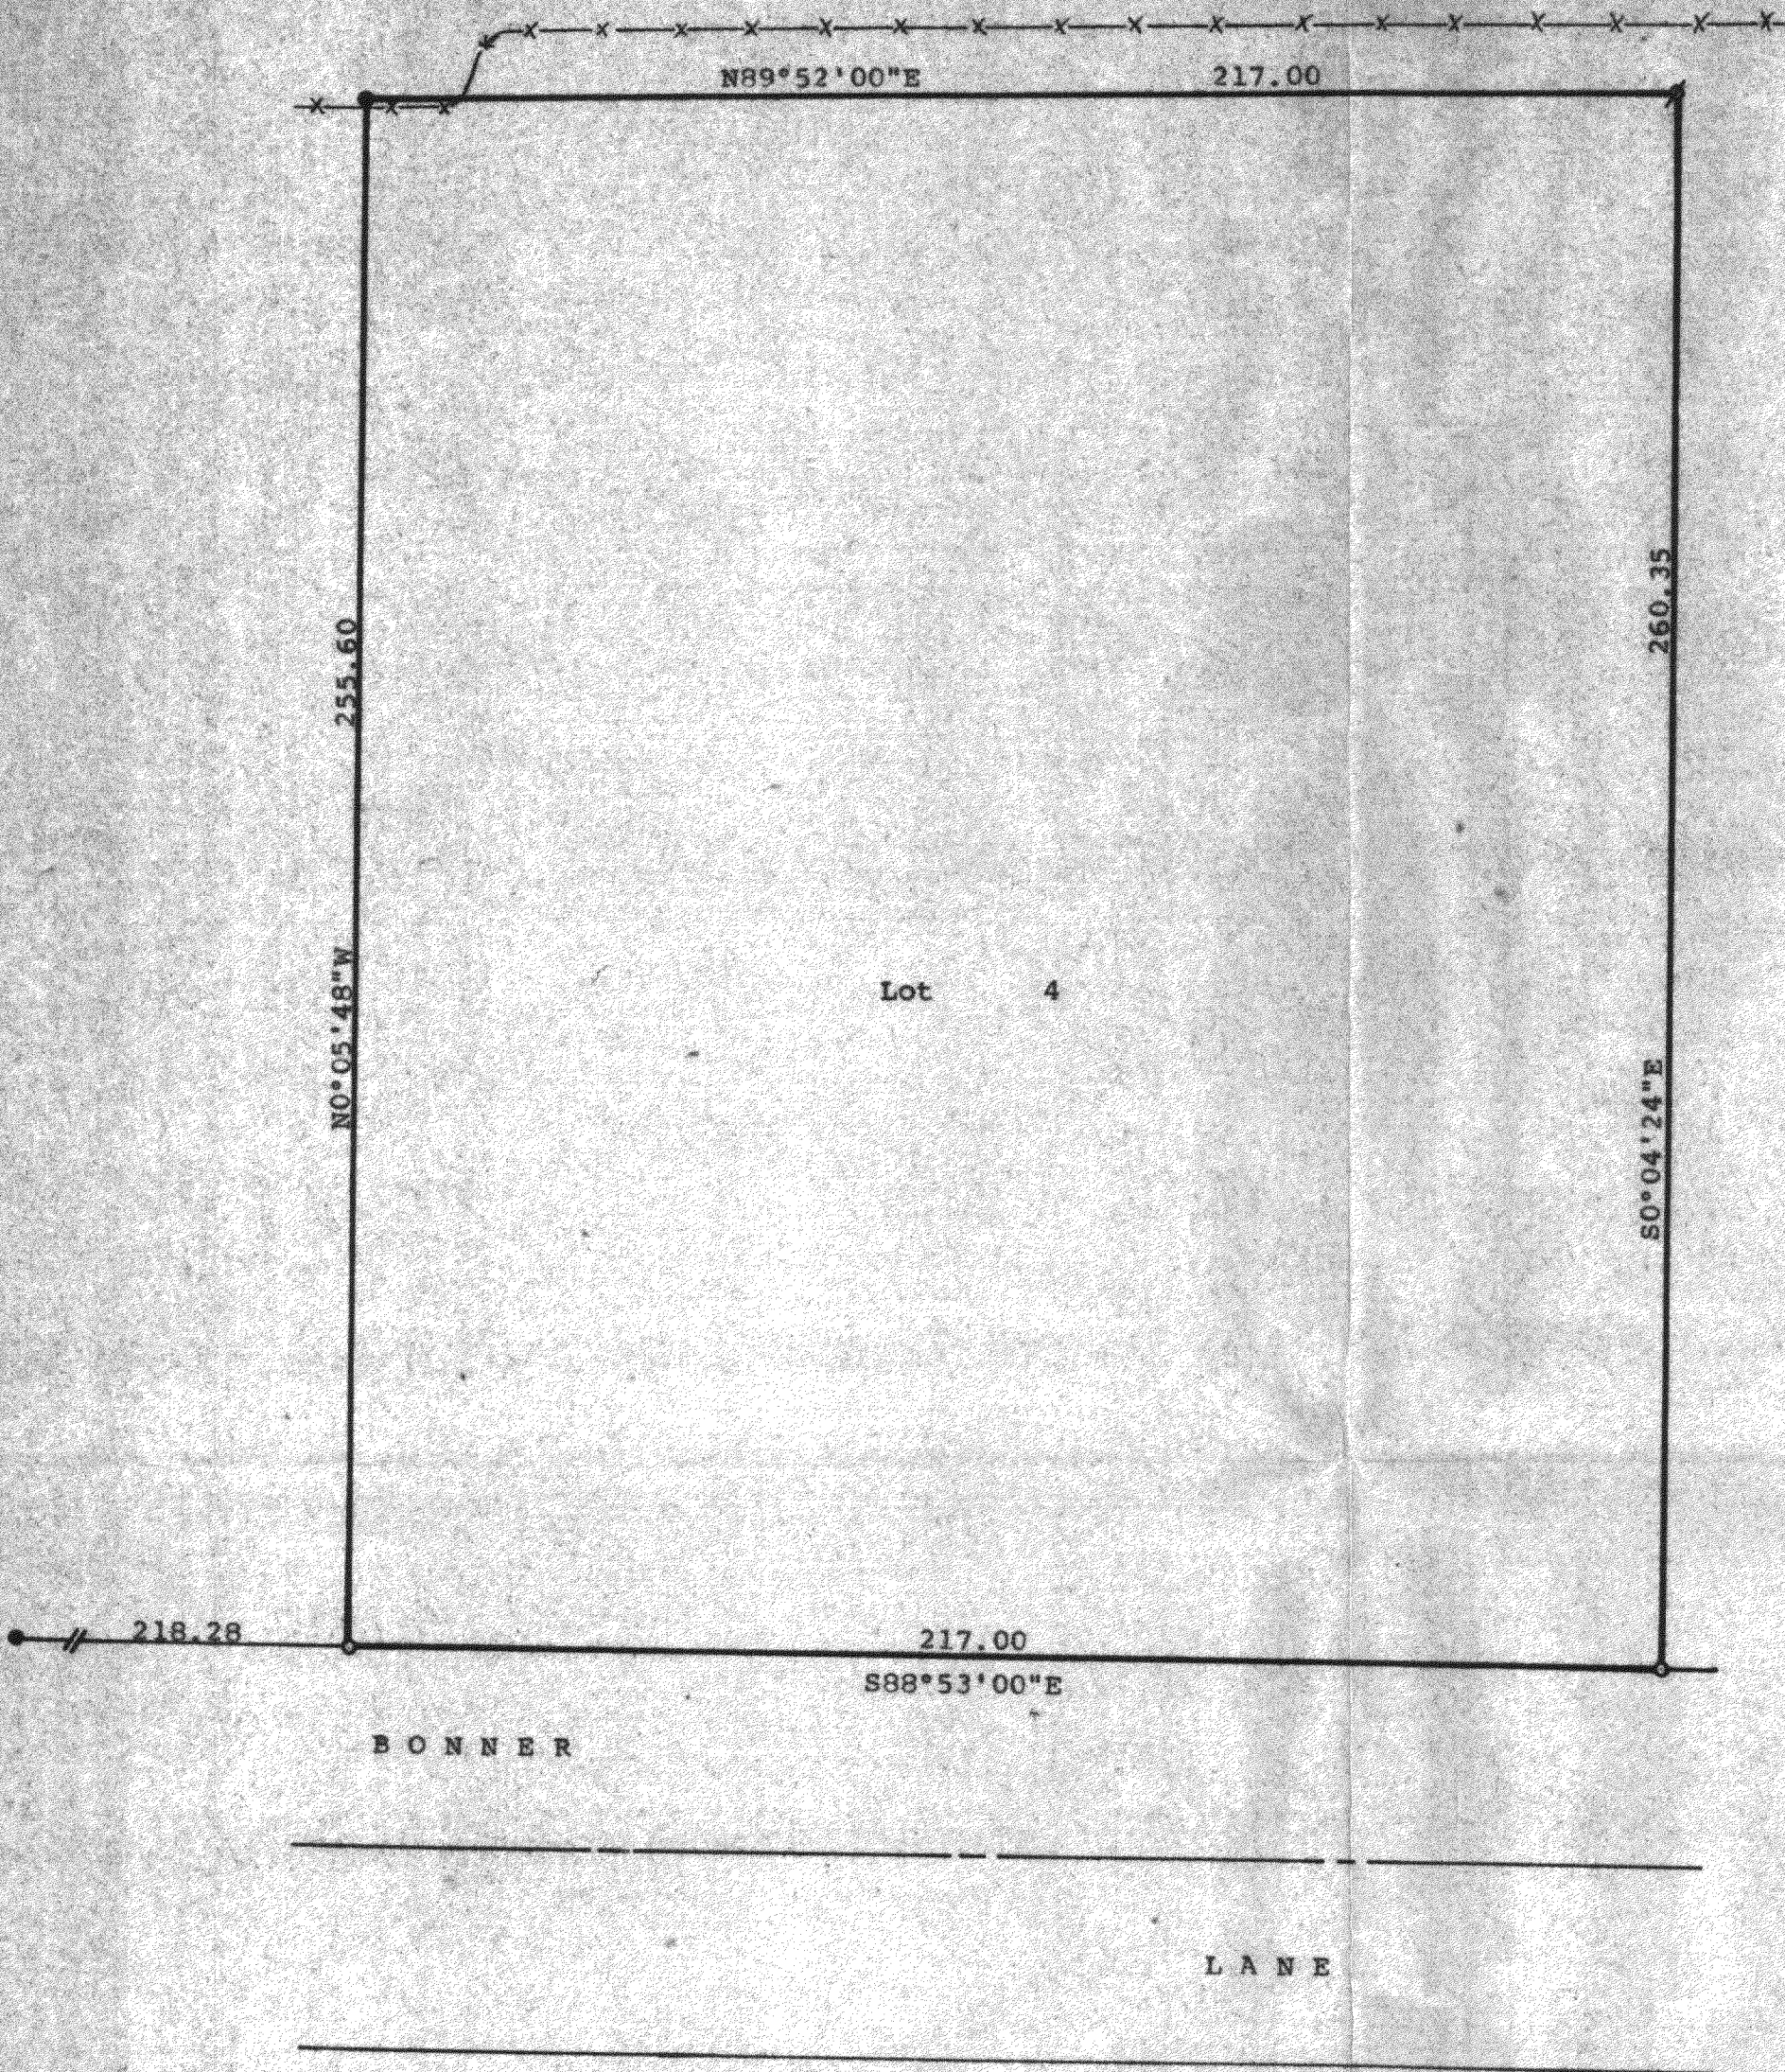

Scale - 1" = 30'

● = 2" Dia. Iron Pipe Found

○ = 1" Dia. Iron Pipe Found

○ = 1" Dia. Iron Pipe Found Bent and Reset

—x—x— = Fenceline

Bearings used are those of record.

Survey Ordered By:

David Kolnik

Box 537


Walworth, WI 53184

STATE OF WISCONSIN)
COUNTY OF WALWORTH) SS

I, George T. Dunham, Surveyor, certify that I have surveyed the property described as follows,

Lot 4 of October Hills, a subdivision located in the Southeast ¼ of Section 22 and in the Southwest ¼ of Section 23, T1N, R16E, Walworth County, Wisconsin,

and that the map shown hereon is a correct representation thereof and shows the size and location of the property, its exterior boundaries, the location of all visible structures and dimensions of all principal buildings thereon, boundary fences, apparent easements, roadways and visible encroachments, if any, and that I have surveyed the property hereon described, according to the official records, to the best of my knowledge and belief.
February 2, 1988.

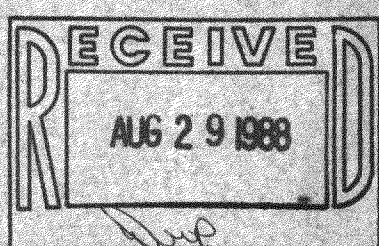

George T. Dunham
George T. Dunham, Surveyor

