


DUNHAM SURVEYING, S.C.
SURVEYING & SUBDIVIDING
DELAVER, WISCONSIN 53115

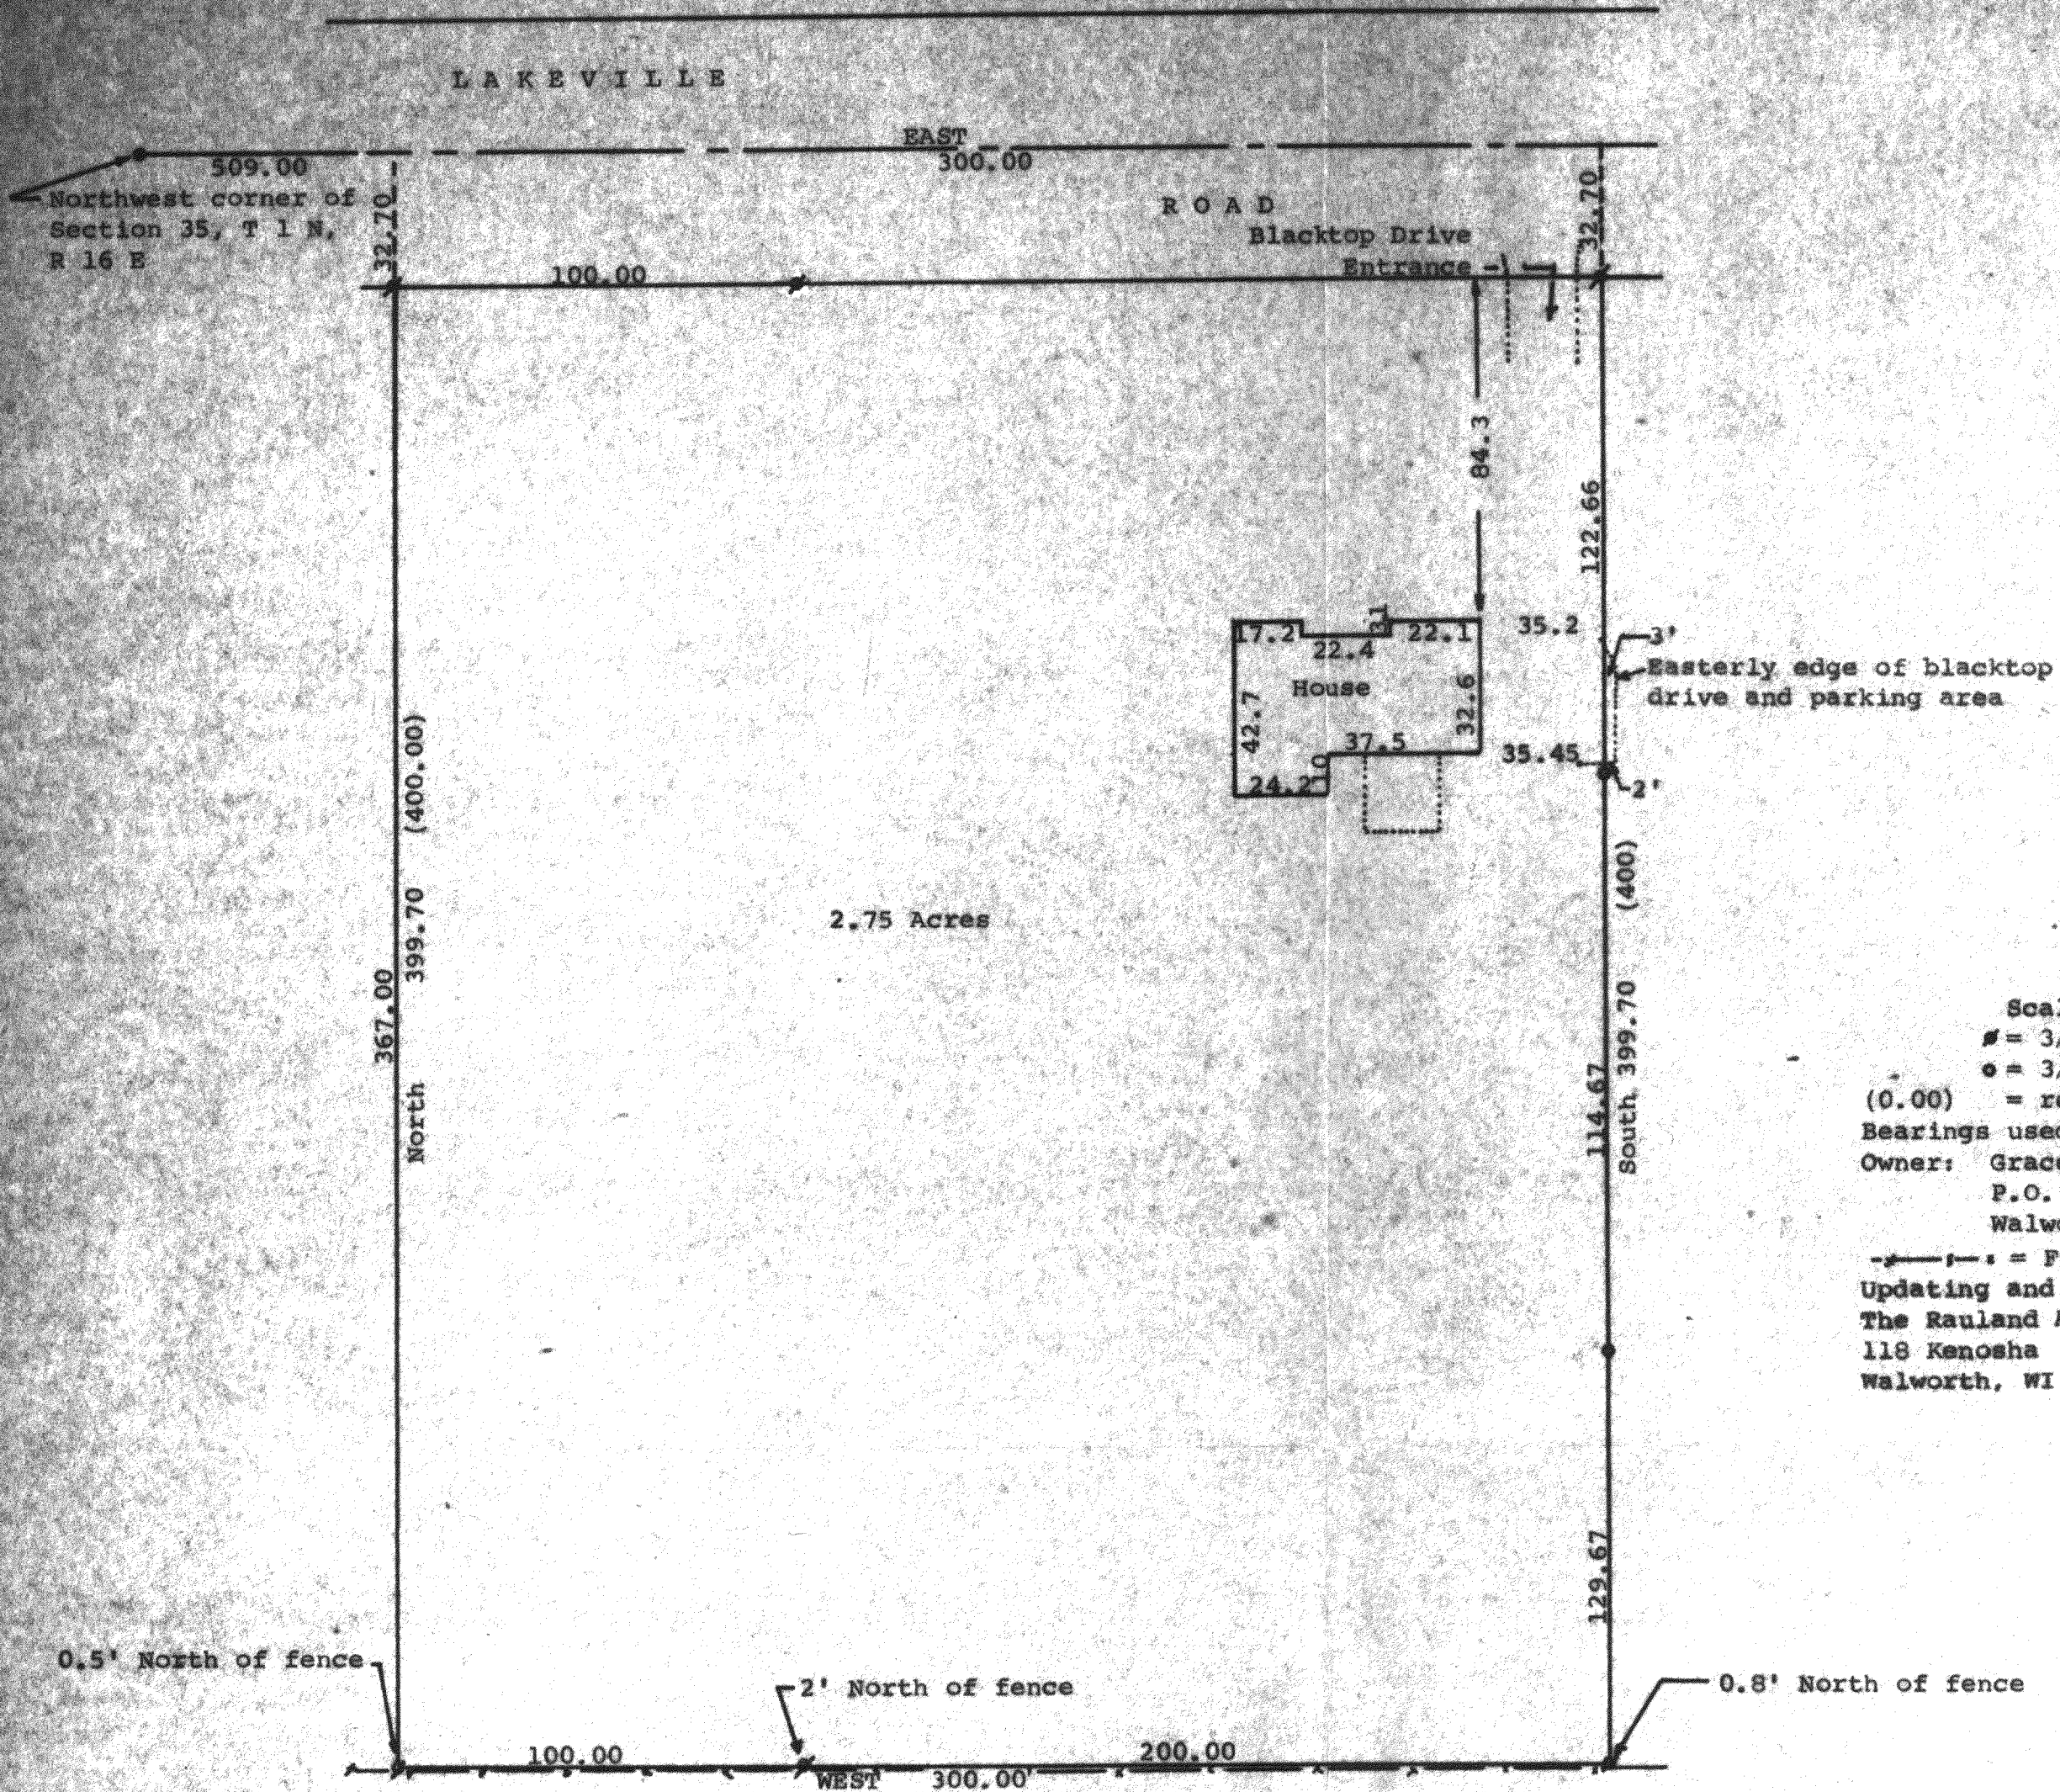

STATE OF WISCONSIN)
COUNTY OF WALWORTH)

I, George T. Dunham, Surveyor, certify that I have surveyed the property described as follows:



A parcel of land located in the Northwest 1/4 of Section 35, T 1 N, R 16 E, Walworth County, Wisconsin, described as follows: Commencing at the northwest corner of said Section 35; thence East along the north line of said section 509.00 feet to the place of beginning; thence continue East 300.00 feet; thence South 400.00 feet; thence West 300.00 feet; thence North 400.00 feet to the place of beginning containing 2.75 acres of land, subject to easements of record.

and that the map shown above is a true representation thereof and shows the size and location of the property, its exterior boundaries, the location of all visible structures and dimensions of all principal buildings thereon, boundary fences, apparent easements, roadways and visible encroachments, if any and that I have surveyed the property hereon described according to the official records to the best of my knowledge and belief.

August 23, 1985

Updated and recertificated to this 11th day of July, 1990

George T. Dunham
George T. Dunham, Surveyor

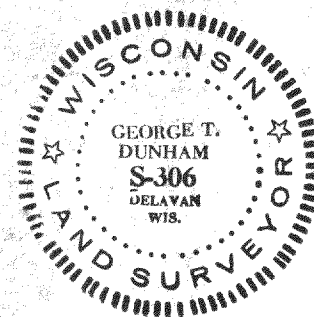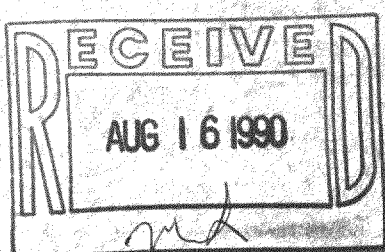

Survey # 116-281

TAX KEY # EW 35000011

116-281