
ABELL
SURVEYING & MAPPING

1140 SEQUOIA STREET • DELAVAN, WISCONSIN 53115
414-728-6737

RECEIVED
APR 18 1999

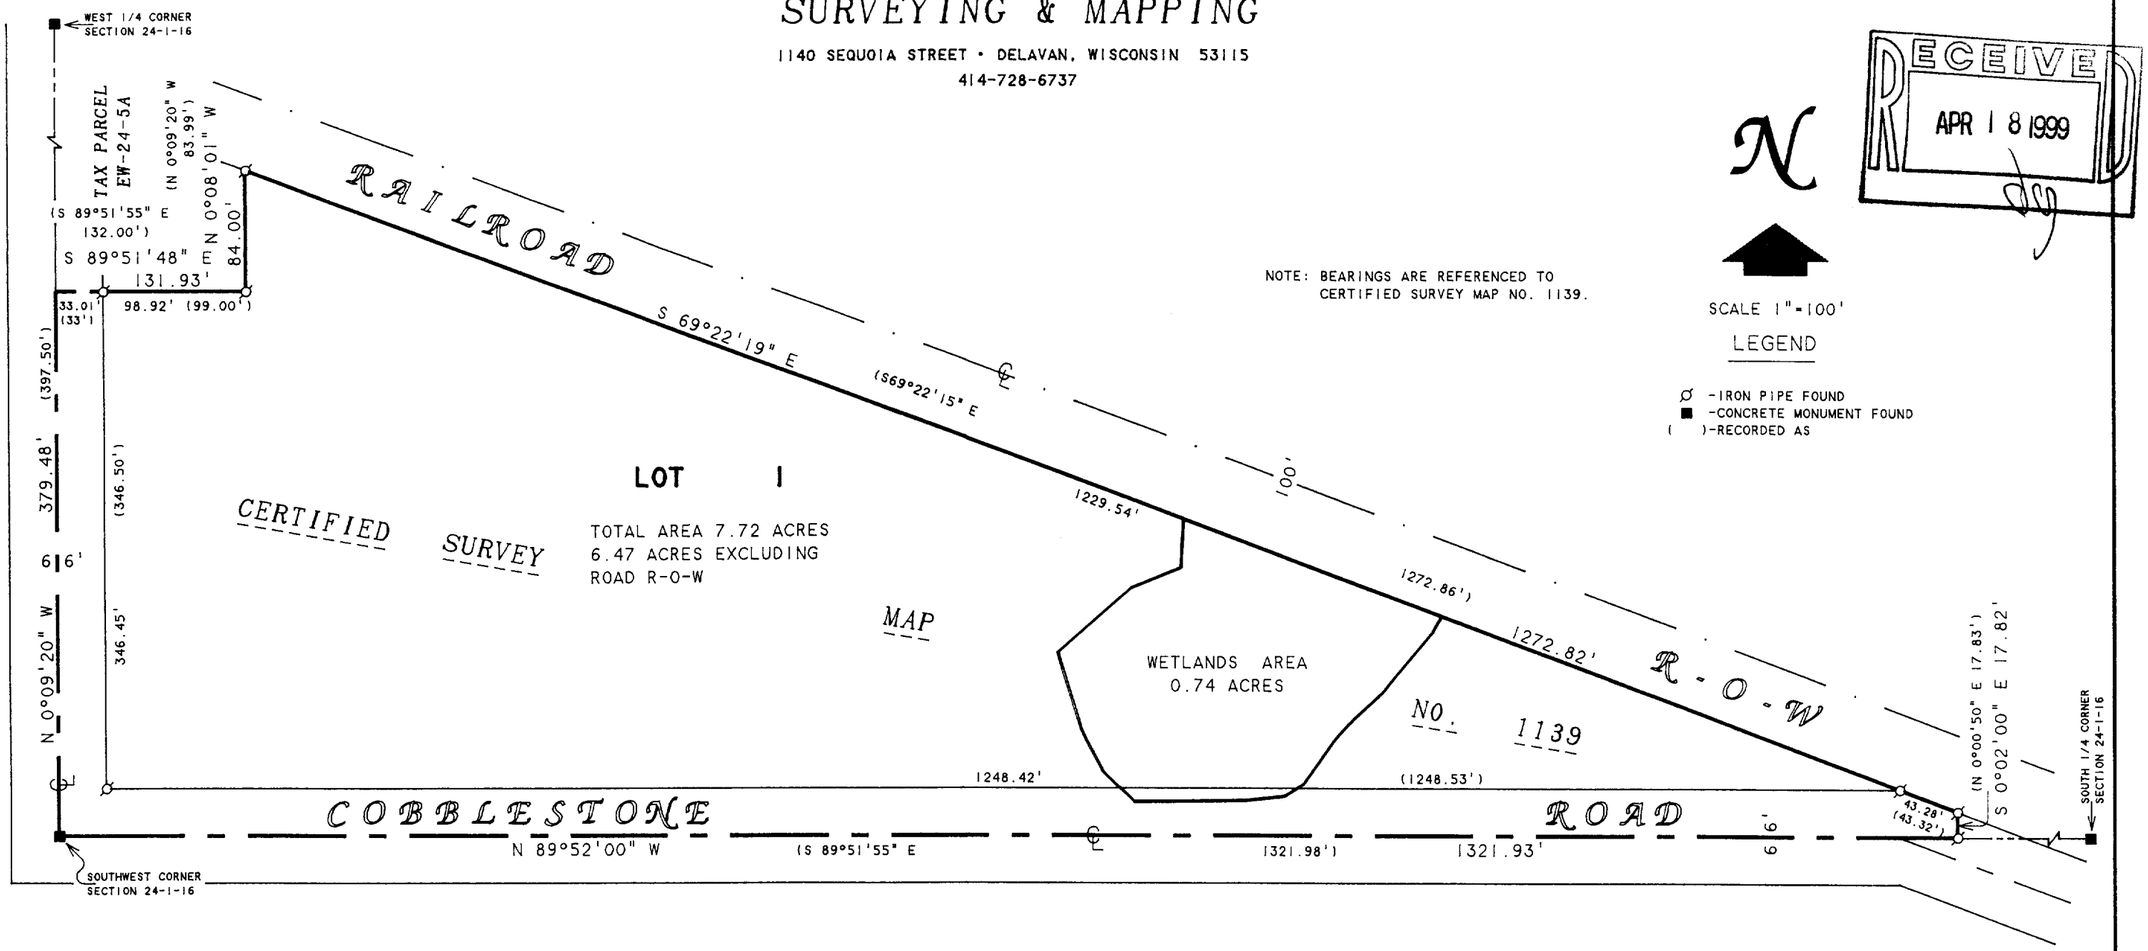

NOTE: BEARINGS ARE REFERENCED TO CERTIFIED SURVEY MAP NO. 1139.

N

SCALE 1"=100'

LEGEND

- ø -IRON PIPE FOUND
- ■ -CONCRETE MONUMENT FOUND
- ( )-RECORDED AS

ORDERED BY: NANCY WELCH
FOR: DAVE BRAID
110 WEST STREET
BUILDING 1, UNIT 7
LAKE GENEVA, WI 53147

PLAT OF SURVEY OF

LOT 1, CERTIFIED SURVEY MAP NO. 1139, LOCATED IN THE SOUTHWEST 1/4 OF THE SOUTHWEST 1/4 OF SECTION 24, T1N, R16E, WALWORTH COUNTY, WISCONSIN.

I, DAVID F. ABELL, DO HEREBY CERTIFY THAT I HAVE SURVEYED THE PROPERTY HEREON DESCRIBED ACCORDING TO THE OFFICAL RECORDS AND THAT THE PLAT HEREON IS A CORRECT REPRESENTATION OF THE PROPERTY LINES TO THE BEST OF MY KNOWLEDGE AND BELIEF.

David F. Abell

DAVID F. ABELL
WISCONSIN REGISTERED LAND SURVEYOR, S-1596

January 4, 1999

DATE JOB NUMBER - 98221

NOTE: THIS IS NOT A CERTIFIED COPY UNLESS SEALED.

116 - 518

EA-1139-1