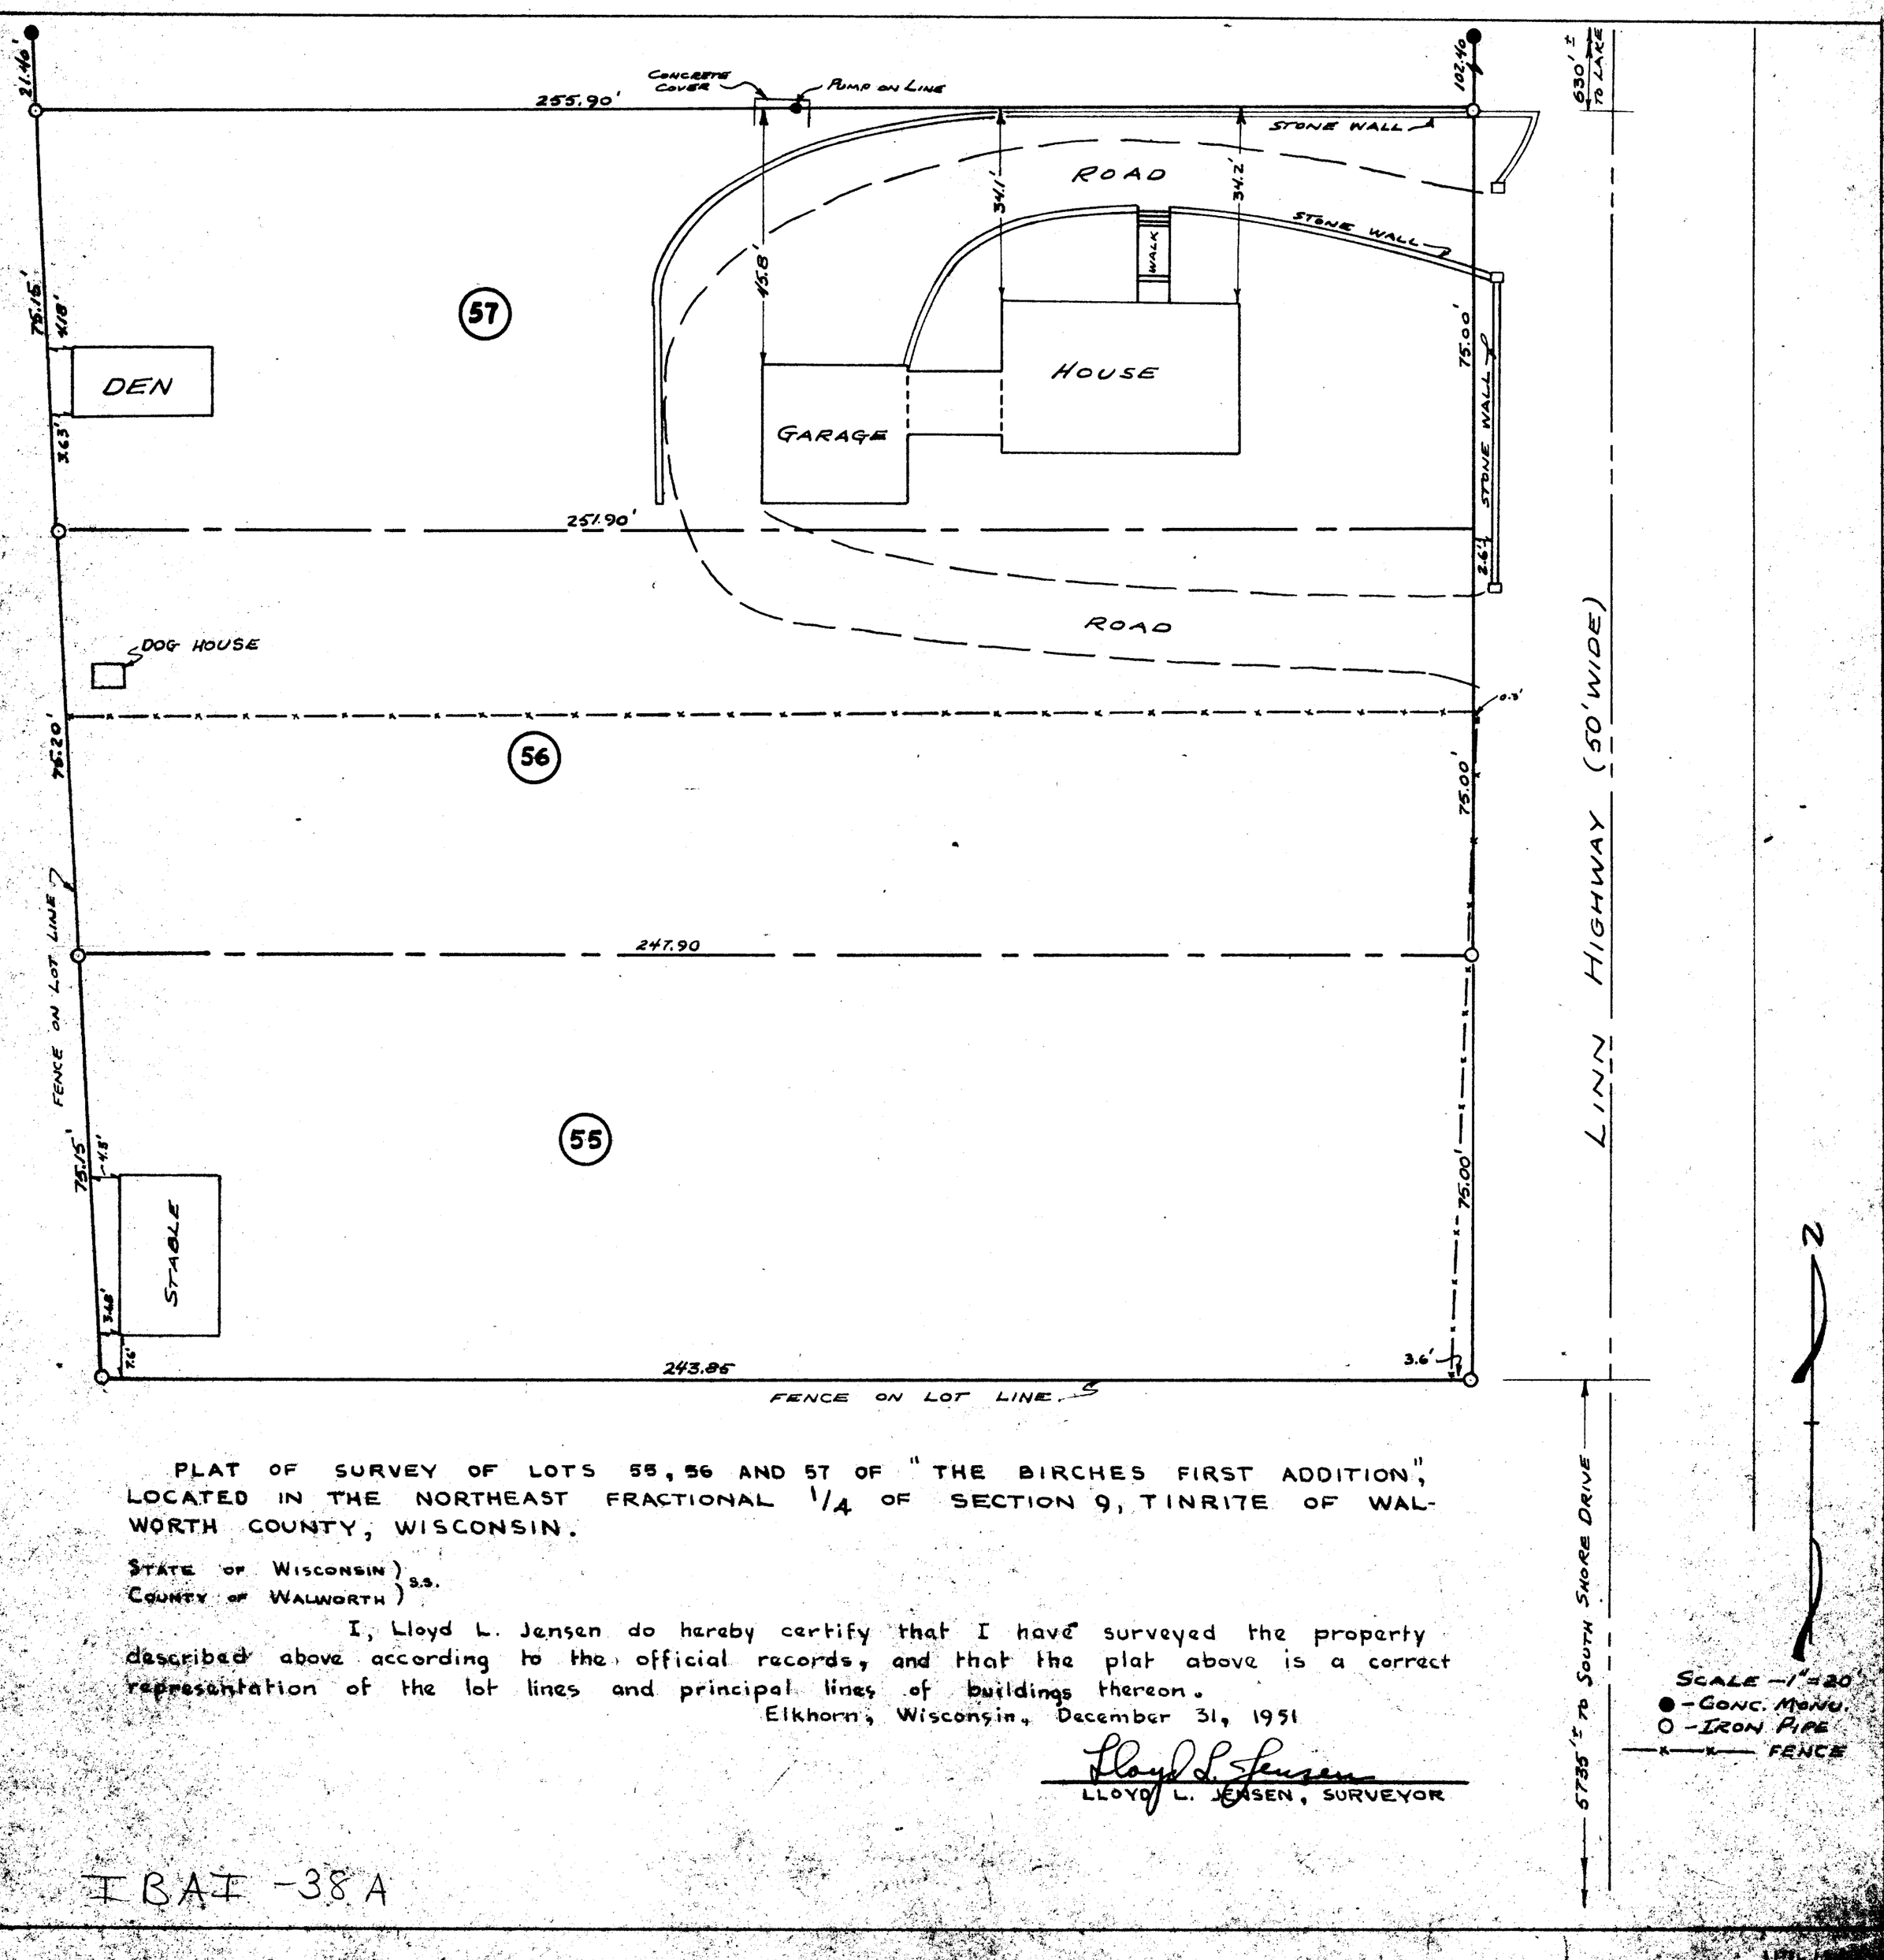

PLAT OF SURVEY OF LOTS 55, 56 AND 57 OF "THE BIRCHES FIRST ADDITION", LOCATED IN THE NORTHEAST FRACTIONAL 1/4 OF SECTION 9, T1NR17E OF WALWORTH COUNTY, WISCONSIN.

STATE OF WISCONSIN)
COUNTY OF WALWORTH) S.S.

I, Lloyd L. Jensen do hereby certify that I have surveyed the property described above according to the official records, and that the plat above is a correct representation of the lot lines and principal lines of buildings thereon.

Elkhorn, Wisconsin, December 31, 1951

Lloyd L. Jensen
LLOYD L. JENSEN, SURVEYOR

IBAI-38A