KOLB LAND CONSULTING, INC.

LAND SURVEYING · SUBDIVIDING · LAND PLANNING

929 WILLIAMS STREET LAKE GENEVA, WISCONSIN 53147 414-248-3697

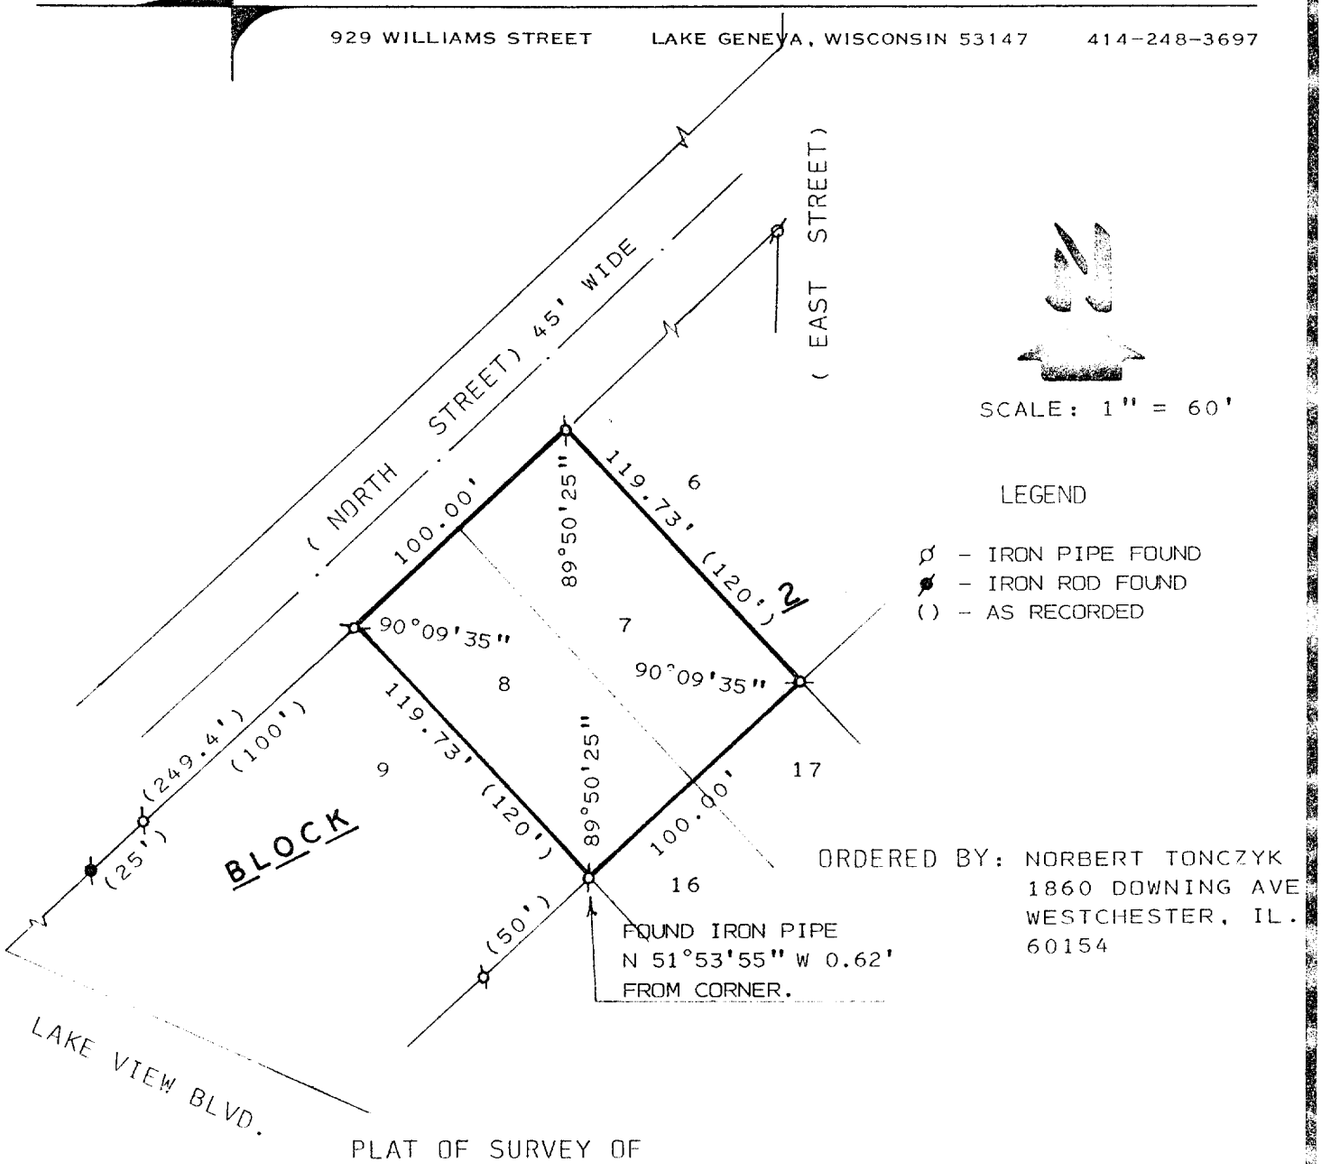

SCALE: 1" = 60'

LEGEND

- ⌀ – IRON PIPE FOUND
- ⌀ – IRON ROD FOUND
- ( ) – AS RECORDED

ORDERED BY: NORBERT TONCZYK
1860 DOWNING AVE
WESTCHESTER, IL.
60154

PLAT OF SURVEY OF

LOTS 7 & 8, BLOCK 2 OF ROBINSON HILLSIDE,
A SUBDIVISION LOCATED IN THE TOWN OF LINN,
WALWORTH COUNTY, WISCONSIN.

I, HAROLD H. KOLB, DO HEREBY CERTIFY THAT I HAVE SURVEYED THE PROPERTY HEREON DESCRIBED ACCORDING TO THE OFFICIAL RECORDS AND THAT THE PLAT HEREON IS A CORRECT REPRESENTATION OF THE LOT LINES TO THE BEST OF MY KNOWLEDGE AND BELIEF.
SURVEY NOT VALID UNLESS SURVEYOR'S SIGNATURE IS IN RED.

HAROLD H. KOLB

WISCONSIN REGISTERED LAND SURVEYOR, S-187

DATE JANUARY 16, 1991

REVISED

REVISED

1-17-385

117-1212

IRH-4A