


HAROLD H. KOLB
REGISTERED PROFESSIONAL LAND SURVEYOR
LAKE GENEVA, WISCONSIN

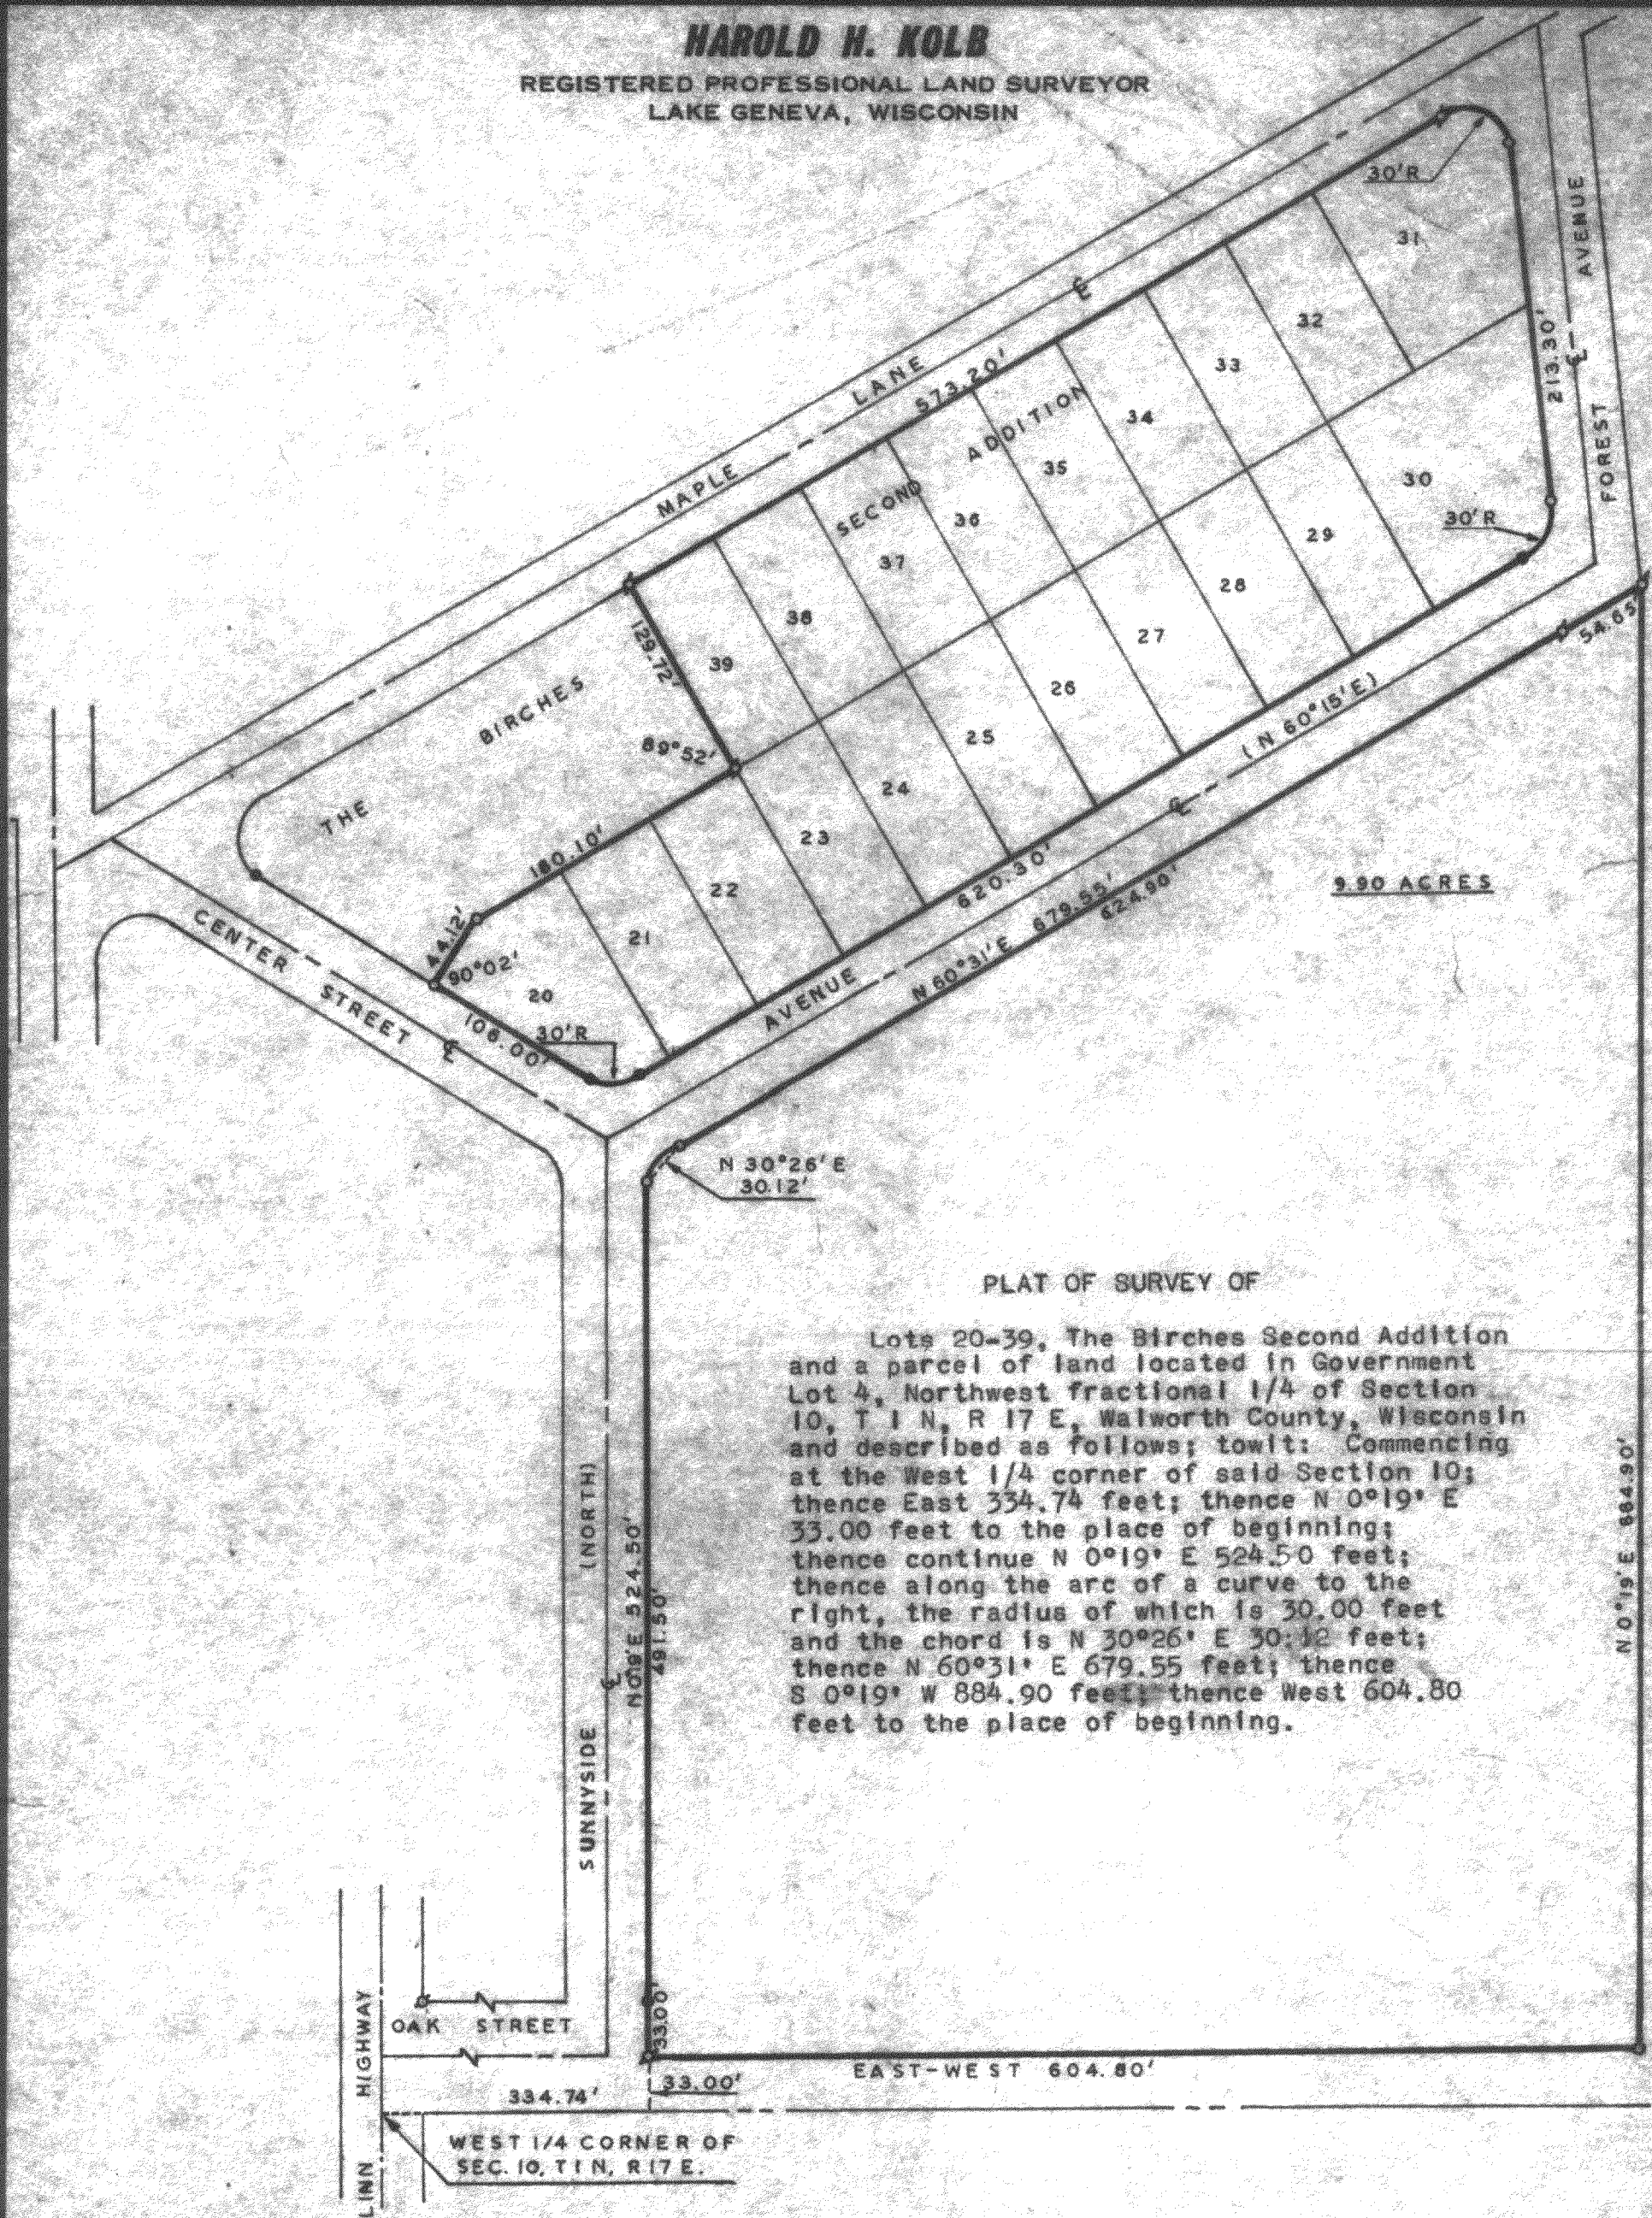

PLAT OF SURVEY OF

Lots 20-39, The Birches Second Addition
and a parcel of land located in Government
Lot 4, Northwest fractional 1/4 of Section
10, T 1 N, R 17 E, Walworth County, Wisconsin
and described as follows; to-wit: Commencing
at the West 1/4 corner of said Section 10;
thence East 334.74 feet; thence N 0°19' E
33.00 feet to the place of beginning;
thence continue N 0°19' E 524.50 feet;
thence along the arc of a curve to the
right, the radius of which is 30.00 feet
and the chord is N 30°26' E 30.12 feet;
thence N 60°31' E 679.55 feet; thence
S 0°19' W 884.90 feet; thence West 604.80
feet to the place of beginning.

- N**
- SCALE: 1" = 100'
- LEGEND**
- - IRON PIPE FOUND
 - ◊ - IRON PIPE PLACED
 - - CONCRETE MONUMENT FOUND
 - x - SPIKE
 - () - RECORDED AS

I, HAROLD H. KOLB, DO HEREBY CERTIFY THAT I HAVE
SURVEYED THE PROPERTY HEREON DESCRIBED ACCORDING
TO THE OFFICIAL RECORDS, AND THAT THE PLAT HEREON
IS A CORRECT REPRESENTATION OF THE LOT LINES.

Harold H. Kolb
HAROLD H. KOLB
WISCONSIN REGISTERED LAND SURVEYOR, S-187
DATE November 22, 1965

L-10-7A

117-126