PREPARED FOR :
HUMMEL CONSTRUCTION
N1958 COUNTY O
DELAVAN, WI 53115

KROTT SURVEYING, INC.
N3705 WILLOW BEND LANE
LAKE GENEVA, WI 53147
(262)- 248-3697

PLAT OF SURVEY

-OF-

LOT 10 IN BLOCK 1 OF TRINKE ESTATES, ACCORDING TO THE PLAT THEREOF RECORDED IN VOLUME 12 OF PLATS ON PAGE 49, LOCATED IN GOVERNMENT LOT 1, WHICH LOT IS THE SE 1/4 AND THE NE 1/4 OF SECTION 10, T1N, R17E, TOWN OF LINN, WALWORTH COUNTY, WISCONSIN.

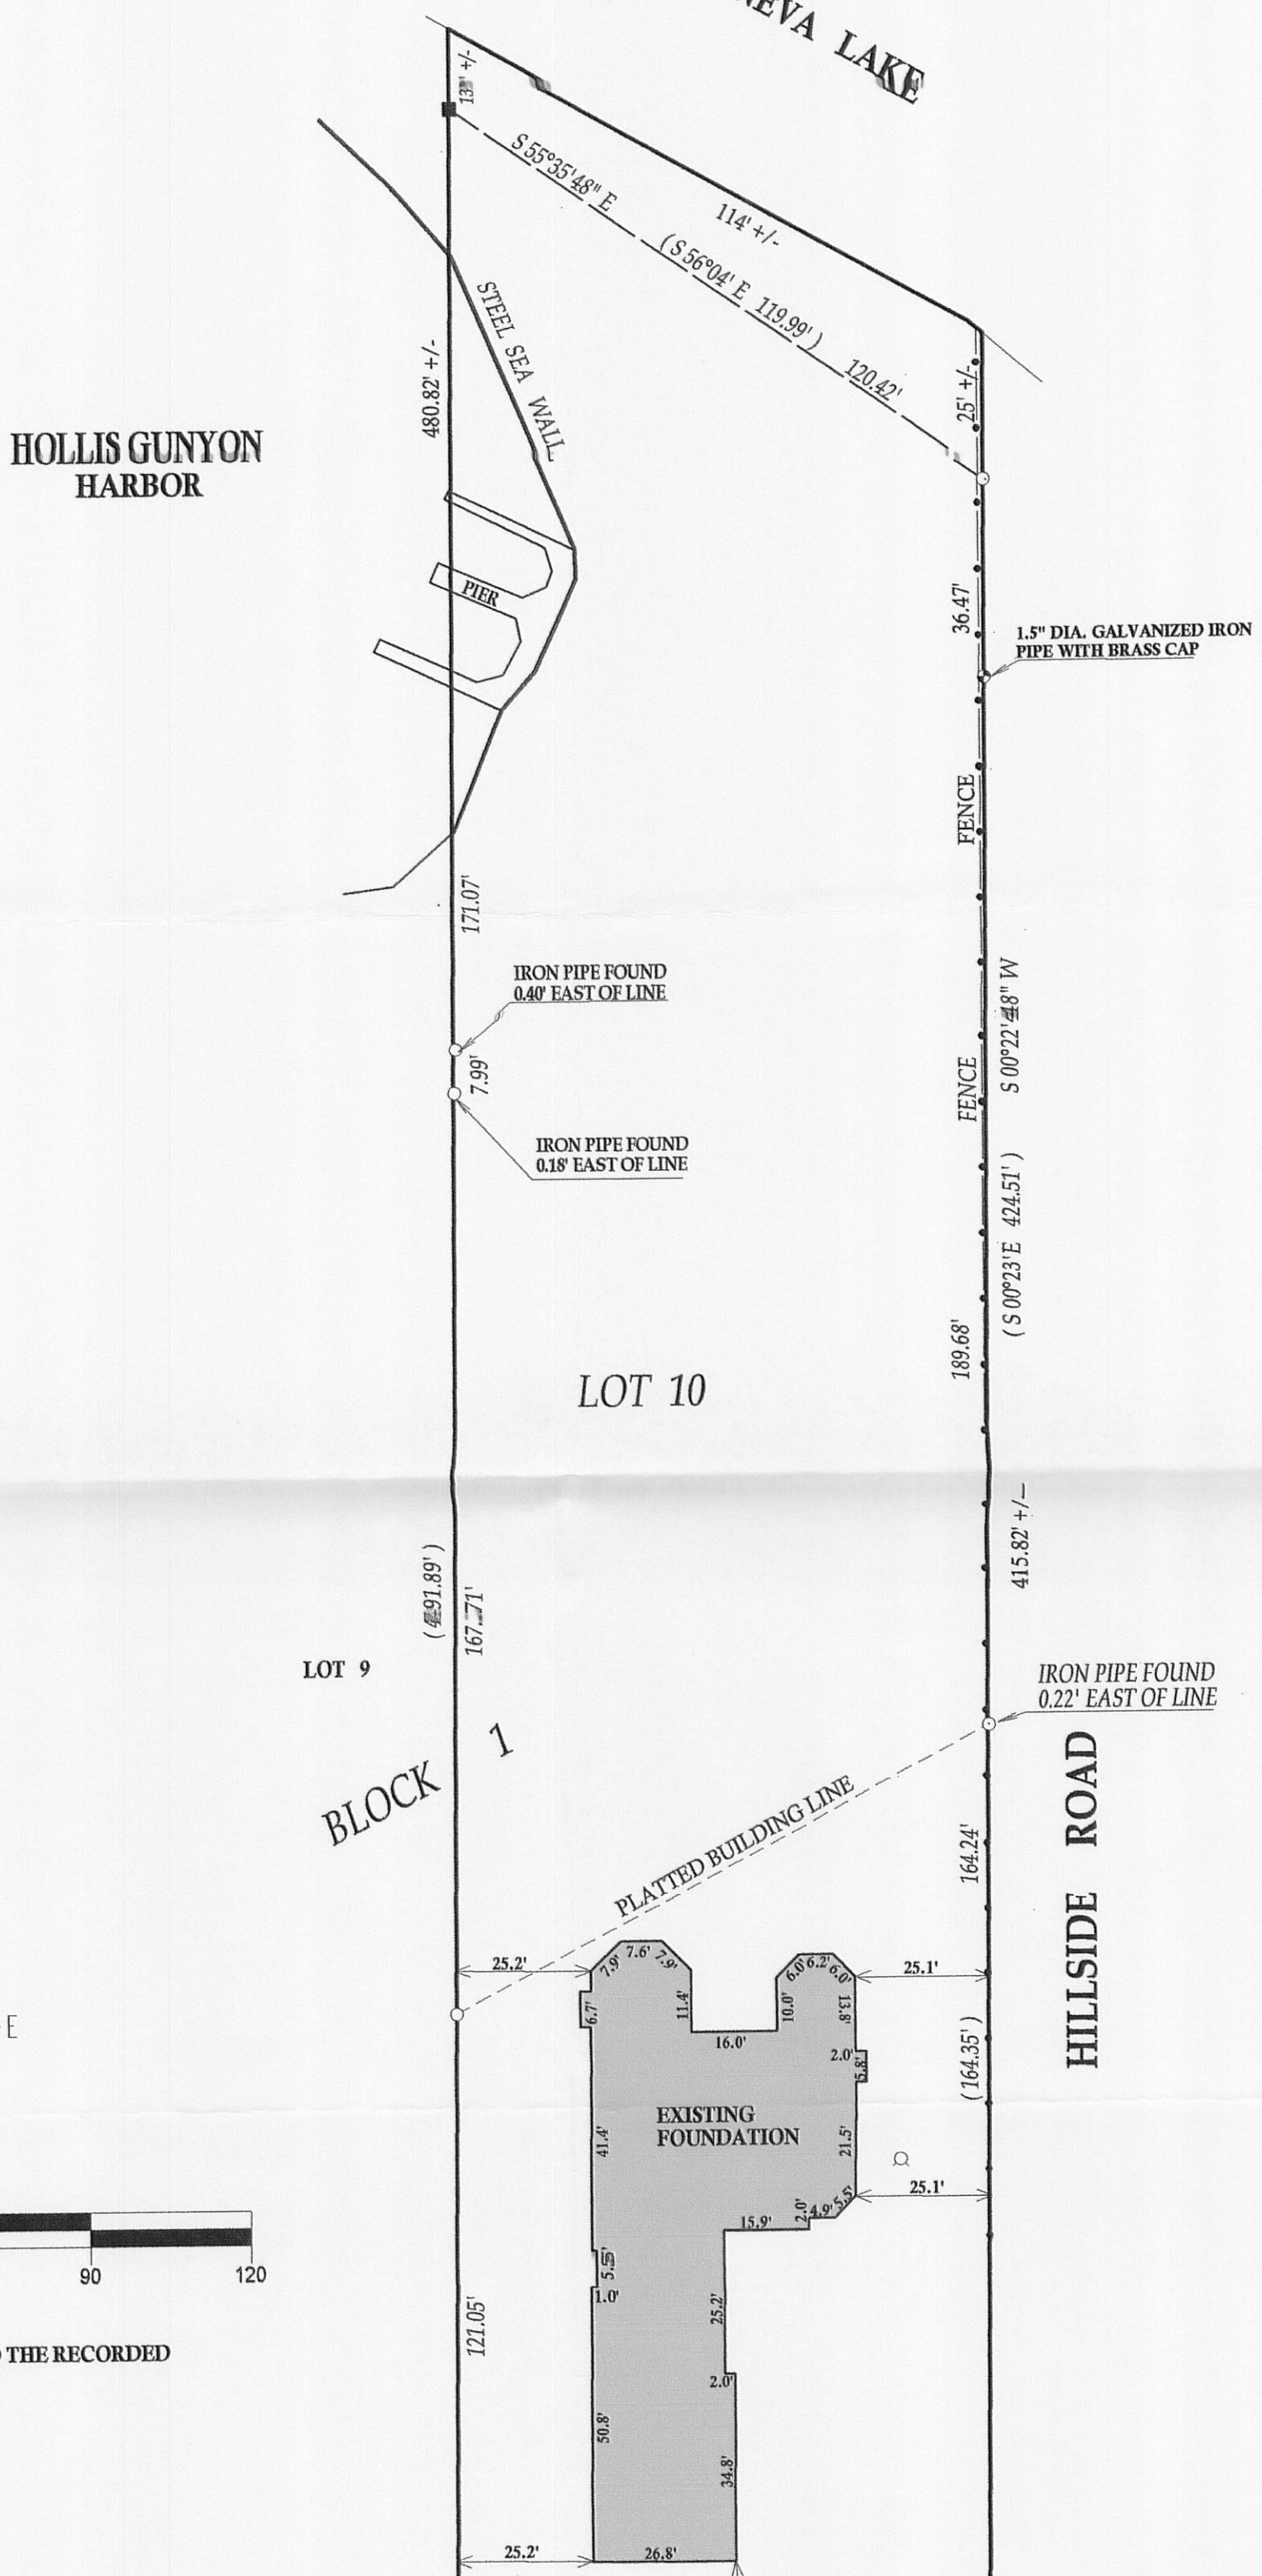

SCALE 1" = 30'

BEARINGS REFERENCED TO THE RECORDED PLAT OF TRINKE ESTATES

LEGEND

- ○ FOUND IRON PIPE
- □ FOUND IRON BAR
- ⌾ WELL
- (xx) RECORDED AS

RECEIVED
JUL - 6 2011
By

I have surveyed the above-described property and the above map is a true representation thereof and shows the size and location of the property, its exterior boundaries, the location and dimensions of all structures thereon, fences apparent easements and roadways and visible encroachments. if any.

This survey is made for the exclusive use of the present owners of the property, and also those who puchase, mortgage,or insure the title therto within one (1) year from date hereof; and as to them I warrant the accuracy of said survey map.

WISCONSIN
JOHN P.
KROTT
S-2258
LAKE GENEVA
WIS.
LAND SURVEYOR

DATE OF LAST REVISION 4 / 29 / 2011
DATED THIS 29th, DAY OF DECEMBER, 2010

JOHN KROTT S - 2258
Wisconsin Registered Land Surveyor
(original if signed in red)

JOB # 03-404 AB
TAX ID # ITE 00010

117 - 3318