HAROLD H. KOLB

REGISTERED PROFESSIONAL LAND SURVEYOR
LAKE GENEVA, WISCONSIN

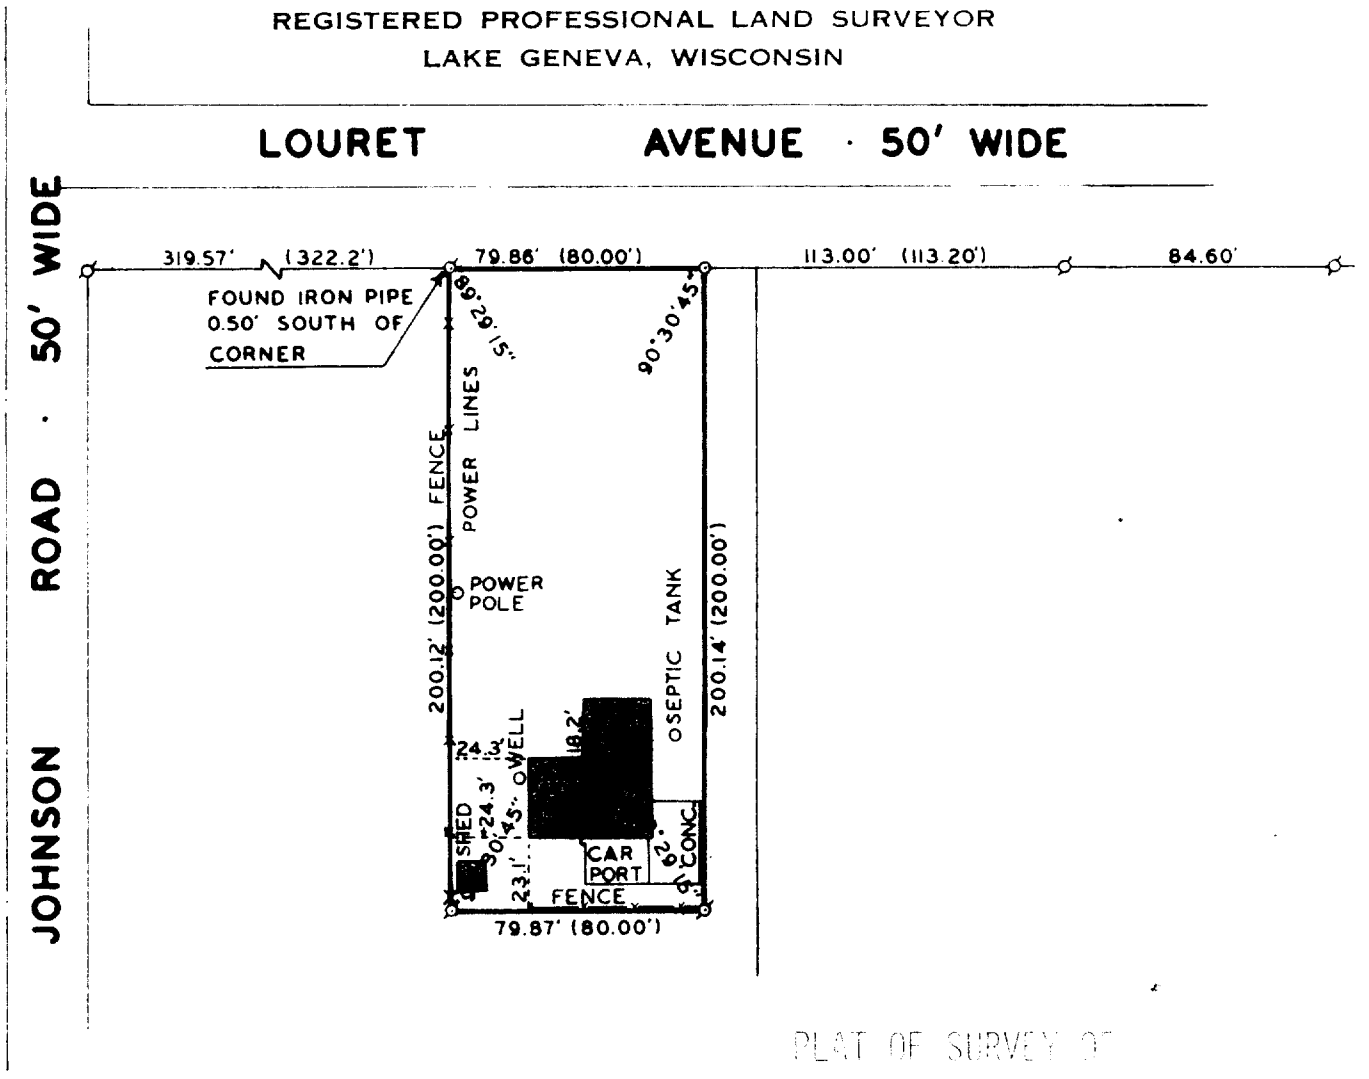

PLAT OF SURVEY OF

A PARCEL OF LAND LOCATED IN BLOCK [illegible], ROWENA PARK, SECTION 5, T1[illegible], R12E, WALWORTH COUNTY, WISCONSIN, AS PER PLAT THEREOF RECORDED IN VOLUME [illegible], PAGE [illegible] OF RECORDS.

BEARINGS ARE BASED ON THE EAST LINE OF THE [illegible]

ACCURACY: [illegible] THAN ONE PART IN [illegible]

N

SCALE · 1"=60'

LEGEND

- ϕ — IRON PIPE FOUND
- O — IRON PIPE PLACED
- ● — CONCRETE MONUMENT
- x — SPIKE
- ( ) — AS PLATTED

I, HAROLD H. KOLB, DO HEREBY CERTIFY THAT I HAVE SURVEYED THE PROPERTY HEREON DESCRIBED ACCORDING TO THE OFFICIAL RECORDS AND THAT THE PLAT HEREON IS A CORRECT REPRESENTATION OF THE LOT LINES

HAROLD H. KOLB
WISCONSIN REGISTERED LAND SURVEYOR, S-187

DATE _____
Revised Date: July 23, 1976

117-525

BRUNING 40-105 1M 6-71