KOLB LAND CONSULTING, INC.

LAND SURVEYING · SUBDIVIDING · LAND PLANNING

LAKE GENEVA, WISCONSIN 53147 WHITEWATER, WISCONSIN 53190

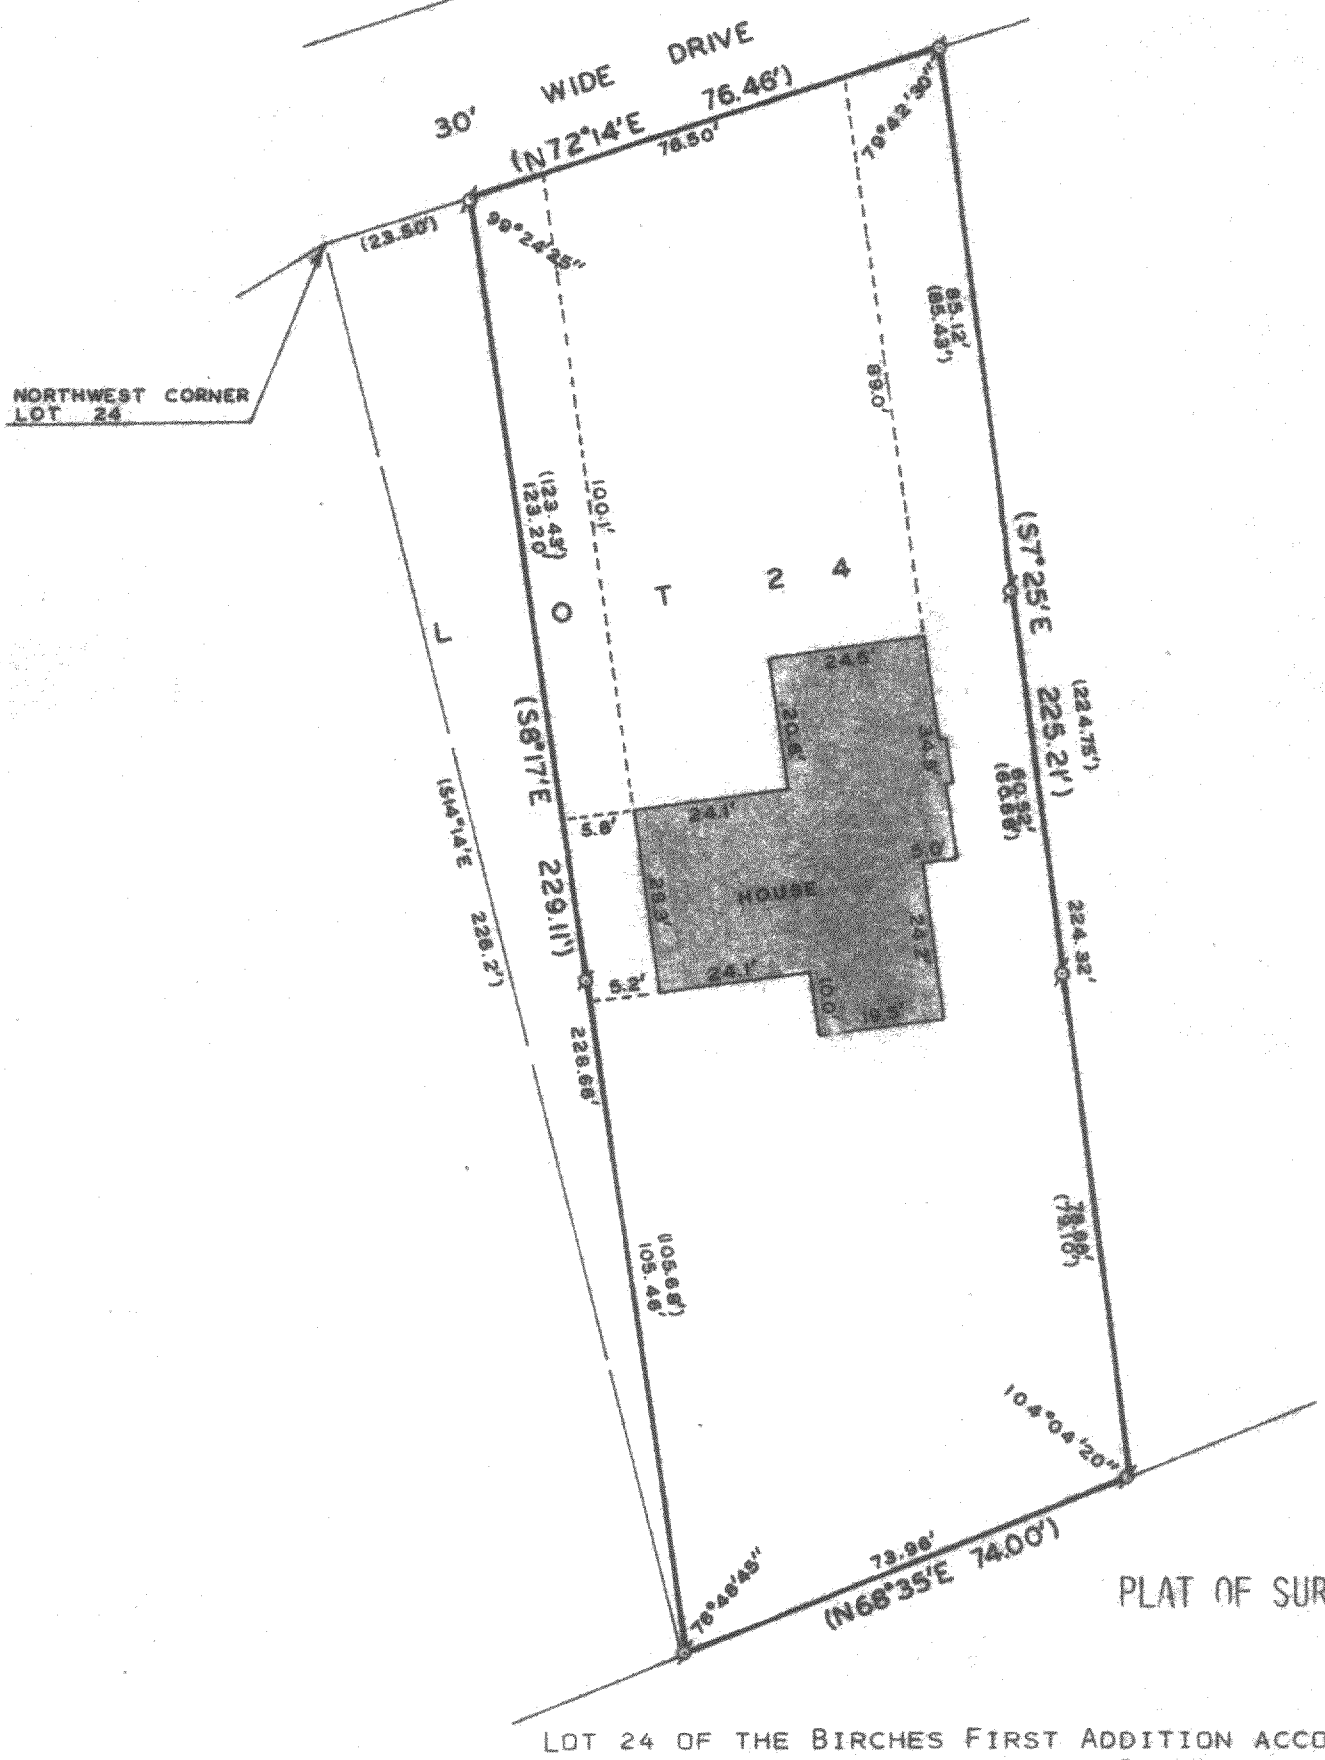

PLAT OF SURVEY OF

LOT 24 OF THE BIRCHES FIRST ADDITION ACCORDING TO THE PLAT HEREOF RECORDED IN THE OFFICE OF THE REGISTER OF DEEDS FOR WALWORTH COUNTY, WISCONSIN, EXCEPTING THEREFROM THAT PART THEREOF DESCRIBED AS FOLLOWS, TO-WIT: COMMENCING AT THE NORTHEAST CORNER OF SAID LOT 24; THENCE SOUTH 72°14' WEST 76.46 FEET TO THE PLACE OF BEGINNING; THENCE SOUTH 8°17' EAST 229.11 FEET TO THE SOUTHWEST CORNER OF SAID LOT 24; THENCE NORTH 14°14' WEST ALONG THE LOT LINE 226.2 FEET TO THE NORTHWEST CORNER OF SAID LOT 24; THENCE NORTH 72°14' EAST 23.50 FEET TO THE PLACE OF BEGINNING.

ORDERED BY: ATTORNEY RICHARD H. CAIN
P.O. BOX 351
FONTANA, WI 53125

FOR: JOSEPH & BEVERLY KIZIOR

SCALE: 1" = 30'

LEGEND
ø - IRON PIPE FOUND
o - IRON PIPE PLACED
() - AS PLATTED

WISCONSIN HAROLD H. KOLB S-187 LAKE GENEVA, WIS. LAND SURVEYOR

I, HAROLD H. KOLB, DO HEREBY CERTIFY THAT I HAVE SURVEYED THE PROPERTY HEREON DESCRIBED ACCORDING TO THE OFFICIAL RECORDS, AND THAT THE PLAT HEREON IS A CORRECT REPRESNTATION OF THE LOT LINES TO THE BEST OF MY KNOWLEDGE AND BELIEF.

Harold H. Kolb

HAROLD H. KOLB
WISCONSIN REGISTERED LAND SURVEYOR, S-187

DATE Oct. 9, 1979

IBA1-15

117-628K