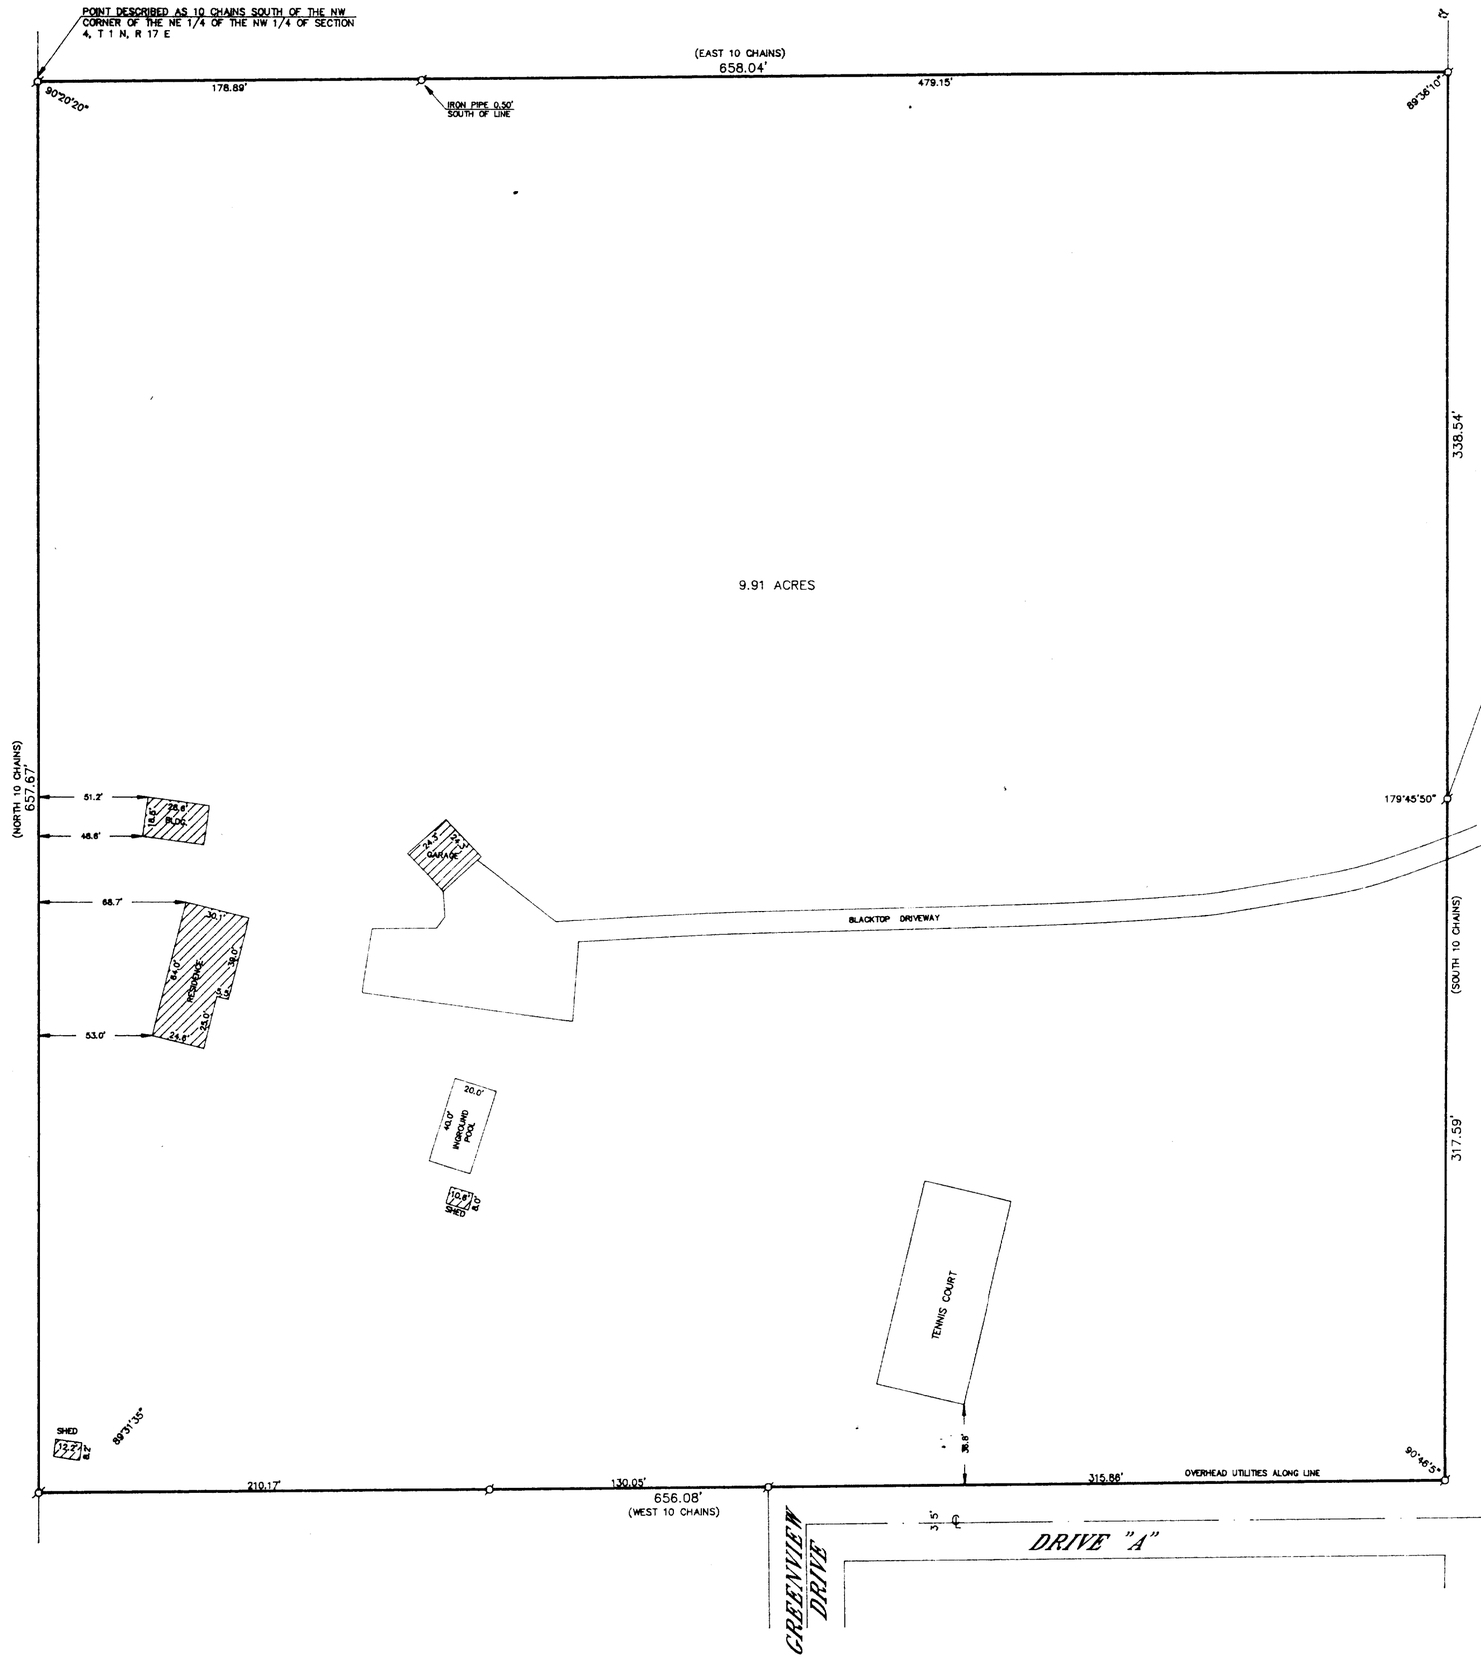


WALWORTH COUNTY
SURVEYING & MAPPING
727 HENRY STREET
LAKE GENEVA, WISCONSIN
414-248-0505

PLAT OF SURVEY OF

A PARCEL OF LAND RECORDED AND DESCRIBED AS FOLLOWS: COMMENCE AT A POINT 10 CHAINS SOUTH OF THE NW CORNER OF THE NE 1/4 OF THE NW 1/4 OF SECTION 4, IN T 1 N, R 17 E, OF THE 4TH P.M., BEING IN THE TOWN OF LINN IN THE COUNTY OF WALWORTH AND STATE OF WISCONSIN; RUN THENCE EAST PARALLEL WITH THE NORTH LINE OF SAID SECTION, 10 CHAINS; THENCE SOUTH 10 CHAINS; THENCE WEST 10 CHAINS TO THE WEST LINE OF THE SAID QUARTER QUARTER SECTION; THENCE NORTH 10 CHAINS TO THE PLACE OF BEGINNING.

ORDERED BY: LAKESHORE REAL ESTATE
101 BROAD STREET
LAKE GENEVA, WISCONSIN
53147

ASSUMED

RECEIVED
JAN 2 1991

GRAPHIC SCALE

50 0 25 50 100 200

(IN FEET)
1 inch = 50 ft.

⌀ – IRON PIPE FOUND
o – IRON PIPE PLACED
( ) – RECORDED AS

I HEREBY CERTIFY THAT I HAVE SURVEYED THE ABOVE DESCRIBED PROPERTY AND THAT THE ABOVE MAP IS A TRUE REPRESENTATION THEREOF AND SHOWS THE SIZE AND LOCATION OF THE PROPERTY, ITS EXTERIOR BOUNDARIES, THE LOCATION OF ALL VISIBLE STRUCTURES AND DIMENSIONS OF ALL PRINCIPAL BUILDINGS THEREON, BOUNDARY FENCES, APPARENT EASEMENTS, ROADWAYS AND VISIBLE ENCROACHMENTS, IF ANY, TO THE BEST OF MY KNOWLEDGE AND BELIEF.

THIS SURVEY IS MADE FOR THE USE OF THE PRESENT OWNERS OF THE PROPERTY AND ALSO THOSE WHO PURCHASE, MORTGAGE OR GUARANTEE THE TITLE THERETO WITHIN ONE (1) YEAR FROM DATE HEREOF.

Robert M. Baerenwald
ROBERT M. BAERENWALD
WISCONSIN REGISTERED LAND SURVEYOR, S-1508

DATE Aug. 14, 1990 *JOB NO. 2834*

NOTE: THIS IS NOT A CERTIFIED COPY UNLESS SEALED.

Survey # 117 - 1011

TAX KEY # IL 400006