
# DUNHAM SURVEYING, S.C.

*SURVEYING & SUBDIVIDING*
DELAVAN, WISCONSIN 53115

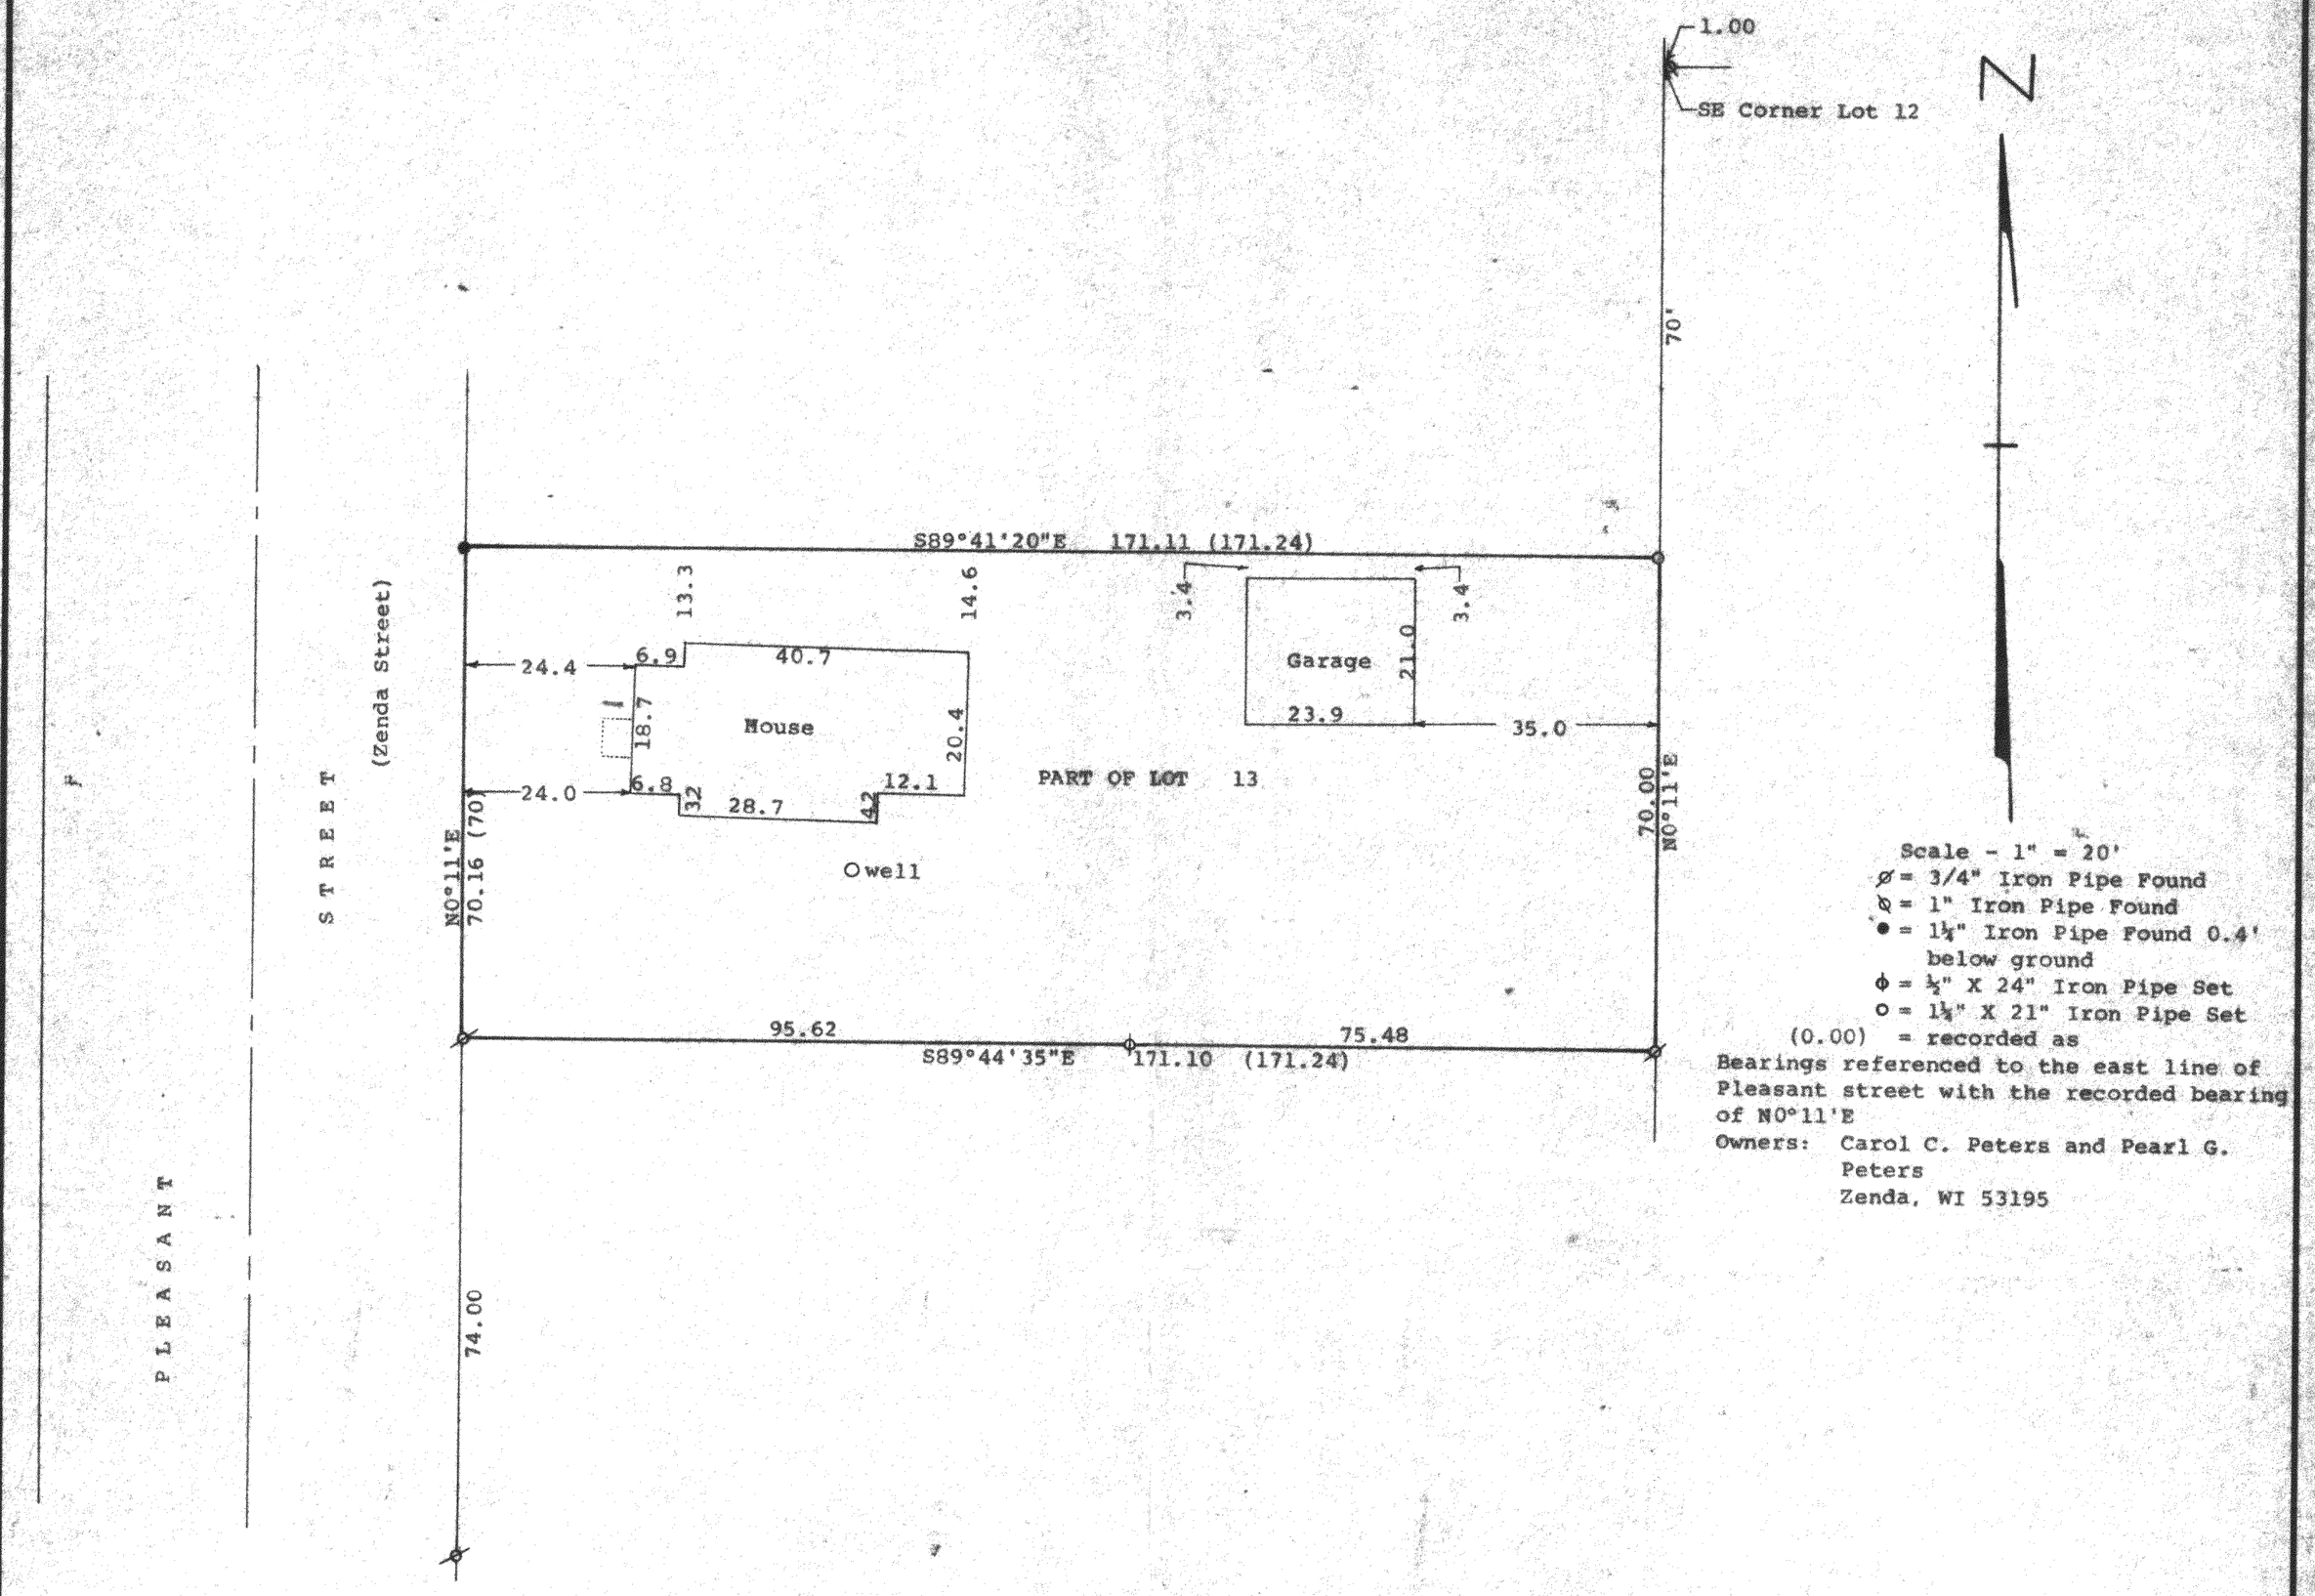


Scale - 1" = 20'
⌀ = 3/4" Iron Pipe Found
⌀ = 1" Iron Pipe Found
● = 1¼" Iron Pipe Found 0.4' below ground
ϕ = ½" X 24" Iron Pipe Set
○ = 1¼" X 21" Iron Pipe Set
(0.00) = recorded as
Bearings referenced to the east line of Pleasant street with the recorded bearing of N0°11'E
Owners: Carol C. Peters and Pearl G. Peters
Zenda, WI 53195

STATE OF WISCONSIN)
COUNTY OF WALWORTH) SS

I, George T. Dunham, Surveyor, certify that I have surveyed the property described as follows:

The South 70 feet to the west 171.24 feet of Lot 13 in Block 1 of Kuebker's Addition to the Village of Zenda, Section 28, T 1 N, R 17 E, Walworth County, Wisconsin,

and that the plat shown hereon is a correct representation thereof and shows the size and location of the property, its exterior boundaries, the location of all visible structures and dimensions of all principal buildings thereon, boundary fences, apparent easements, roadways and visible encroachments, if any, and that I have surveyed the property hereon described, according to the official records, to the best of my knowledge and belief.

September 17, 1991

George T. Dunham, Surveyor

WISCONSIN
GEORGE T. DUNHAM
S-306
DELAVAN WIS.
LAND SURVEYOR

RECEIVED
JAN 14 1992

GMB 1020

117-1132

IZK-3