
WALWORTH COUNTY
SURVEYING & MAPPING
727 HENRY STREET
LAKE GENEVA, WISCONSIN
414-248-0505

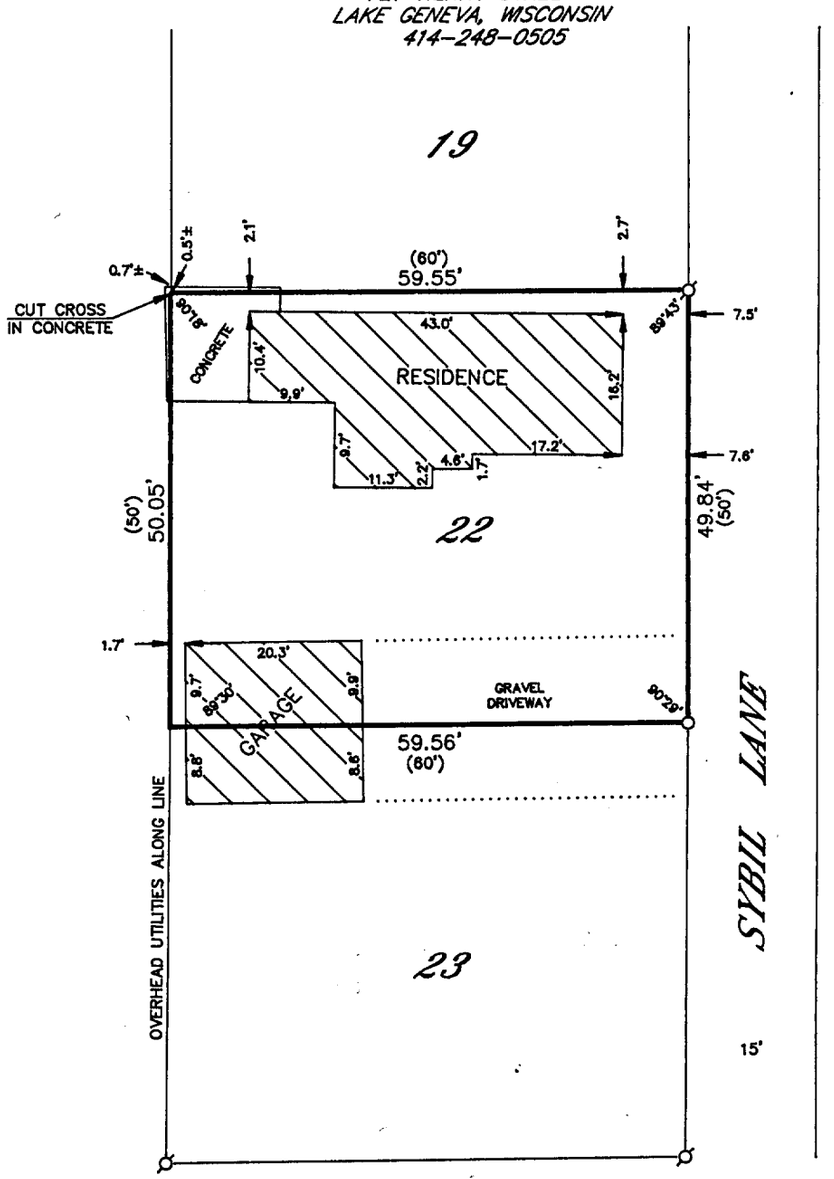

PLAT OF SURVEY OF

LOT 22 OF CAMP SYBIL, LOCATED IN SECTION 18, T 1 N, R 17 E, WALWORTH COUNTY, WISCONSIN.

ORDERED BY: BAZOS & KRAMER, P.C.
1140 NORTH MCLEAN BOULEVARD
SUITE 1
ELGIN, ILLINOIS
60123

RECEIVED
JAN 16 1992
dy

SCALE IN FEET
0 20 40

LEGEND
- ○-IRON PIPE FOUND
- ⊠-IRON ROD FOUND
- ■-CONCRETE MONUMENT FOUND
- ○-IRON PIPE PLACED
- ()-RECORDED AS

I HEREBY CERTIFY THAT I HAVE SURVEYED THE ABOVE DESCRIBED PROPERTY AND THAT THE ABOVE MAP IS A TRUE REPRESENTATION THEREOF AND SHOWS THE SIZE AND LOCATION OF THE PROPERTY, ITS EXTERIOR BOUNDARIES, THE LOCATION OF ALL VISIBLE STRUCTURES AND DIMENSIONS OF ALL PRINCIPAL BUILDINGS THEREON, BOUNDARY FENCES, APPARENT EASEMENTS, ROADWAYS AND VISIBLE ENCROACHMENTS, IF ANY, TO THE BEST OF MY KNOWLEDGE AND BELIEF.

THIS SURVEY IS MADE FOR THE USE OF THE PRESENT OWNERS OF THE PROPERTY AND ALSO THOSE WHO PURCHASE, MORTGAGE OR GUARANTEE THE TITLE THERETO WITHIN ONE (1) YEAR FROM DATE HEREOF.

Robert M. Baerenwald

ROBERT M. BAERENWALD
WISCONSIN REGISTERED LAND SURVEYOR, S-1508

Nov. 13 1990
DATE JOB NO. 2728

NOTE: THIS IS NOT A CERTIFIED COPY UNLESS SEALED.

117-1186

ICA-21