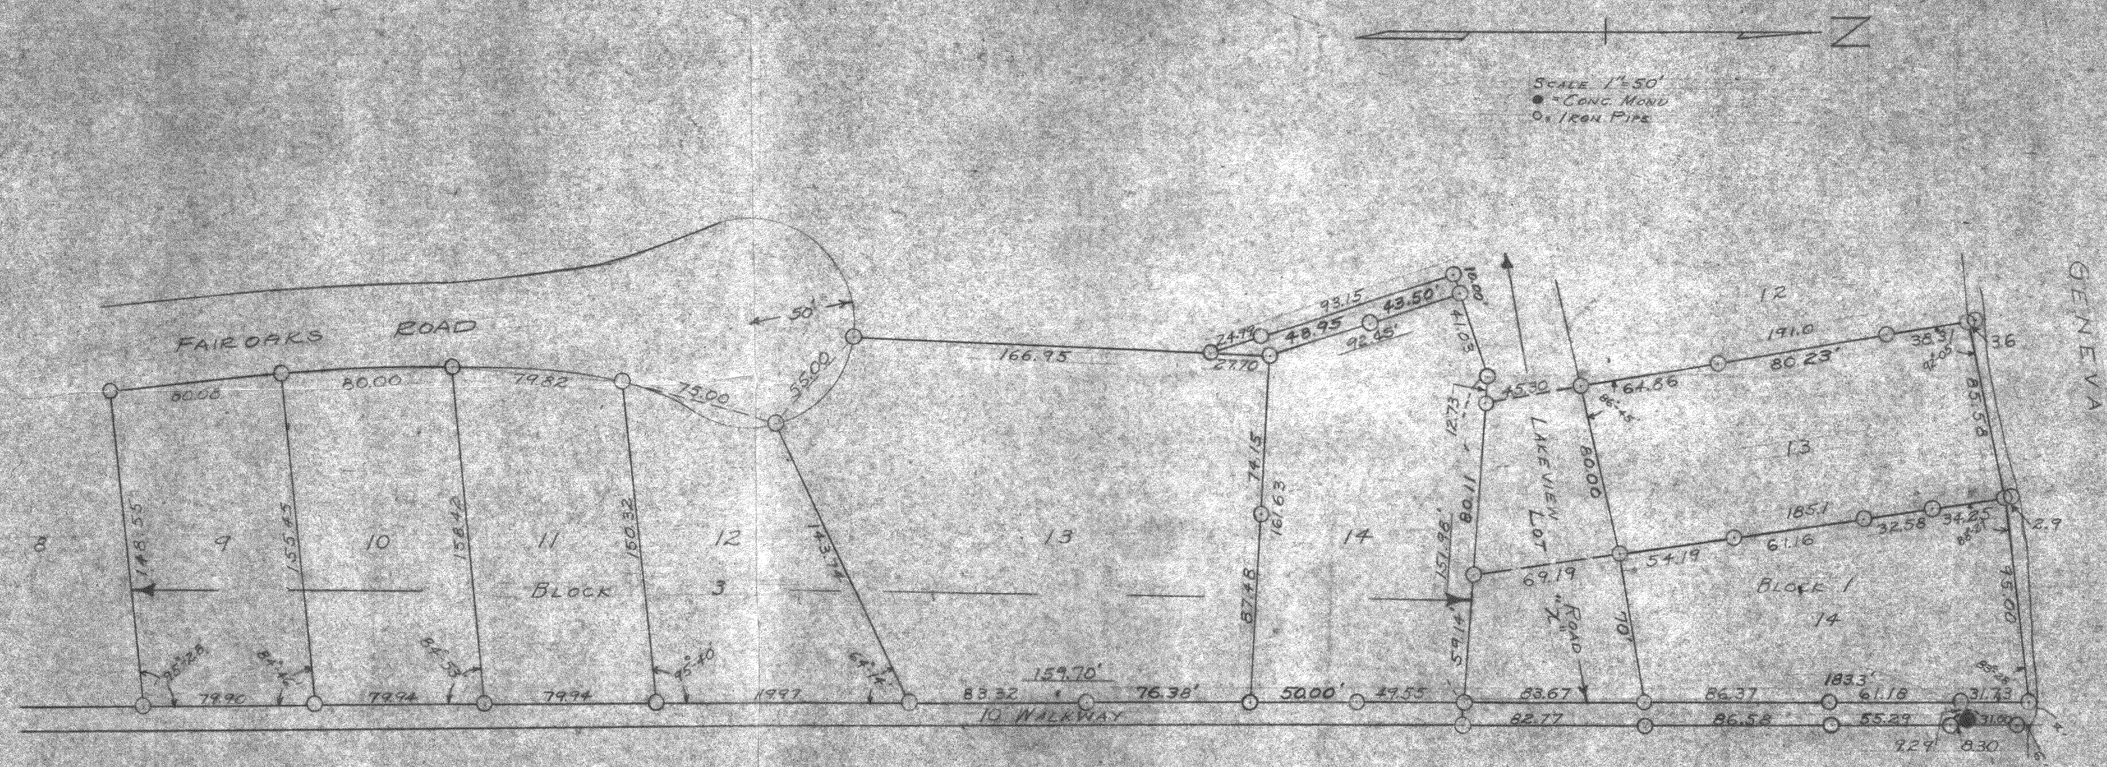

PLAT OF SURVEY OF LOTS 9 TO 14 INCLUSIVE, BLOCK 3 AND LOTS 13 AND 14, BLOCK 1, WOODDALE ADDITION, LOCATED IN SECTION 9, T1N R17E OF WALWORTH COUNTY, WISCONSIN AND OTHER LAND.
MAY 1952

Lloyd L. Jensen
COUNTY SURVEYOR

IW-18A
IW 18B

IW-29
" -31

117-121.1