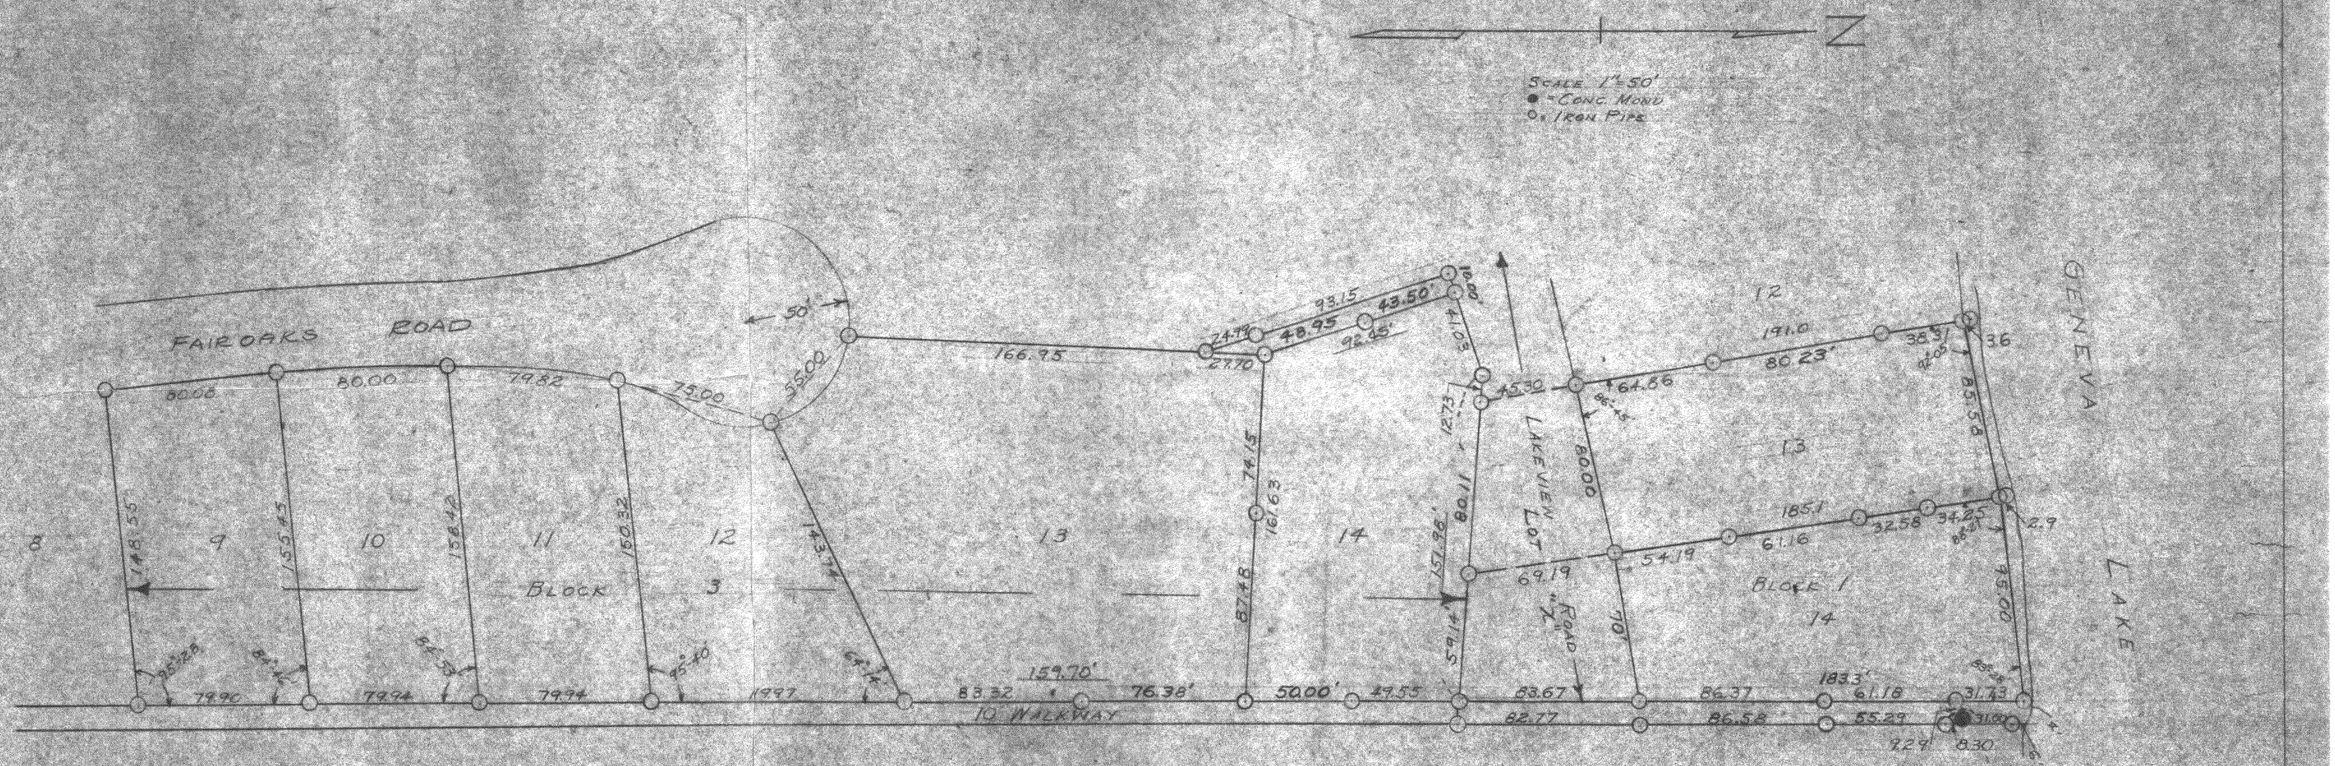


Plat of Survey of Lots 9 to 14 inclusive, Block 3 and Lots 13 and 14, Block 1, Wooddale Addition, located in Section 9, T1N R17E of Walworth County, Wisconsin and other land.
May 1952.

Lloyd L. Jensen
County Surveyor

IW-18A
IW 18B

IW-29
" -31

117-121.1