
KOLB LAND CONSULTING, INC.

LAND SURVEYING · SUBDIVIDING · LAND PLANNING

929 WILLIAMS STREET LAKE GENEVA, WISCONSIN 53147 414-248-3697

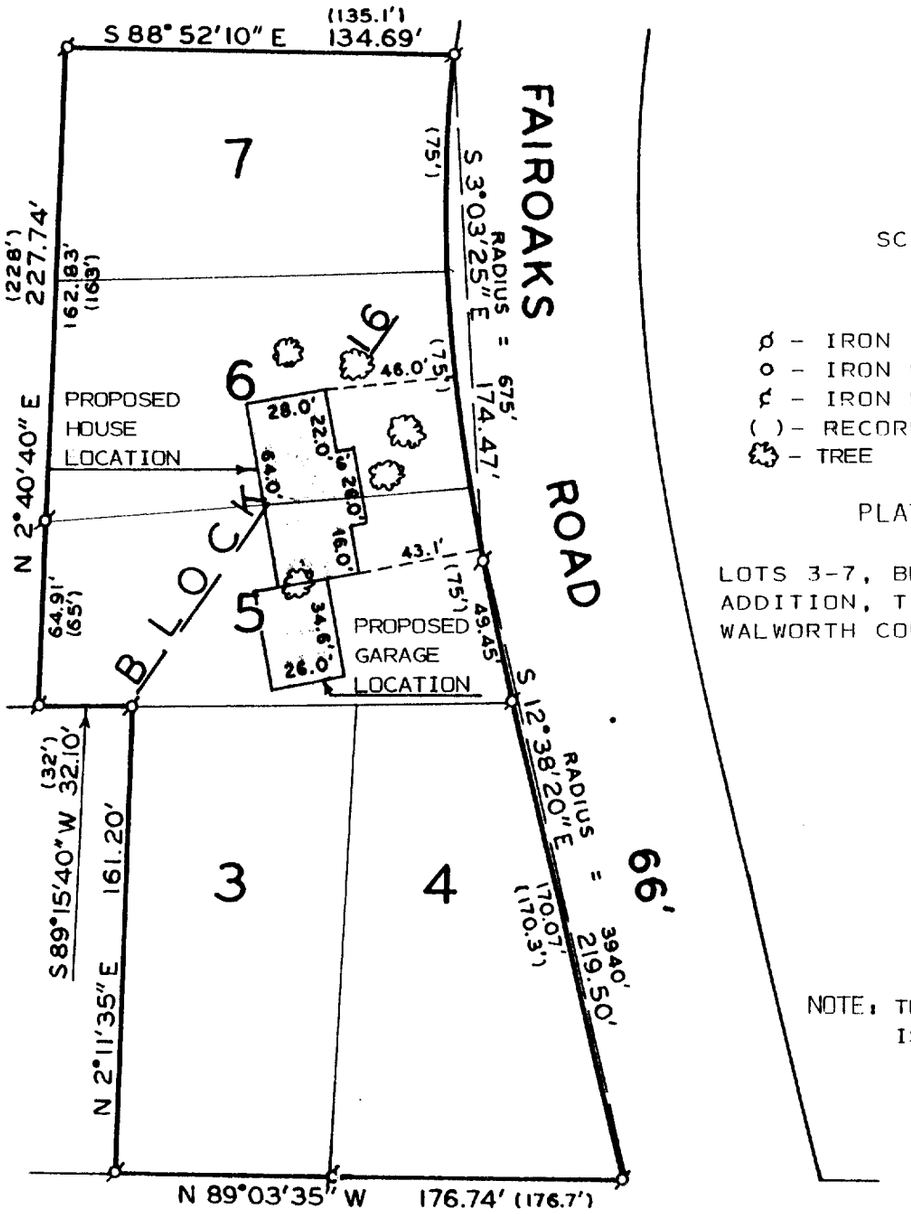

SCALE : 1" = 60'

LEGEND

- ø - IRON PIPE FOUND
- o - IRON PIPE SET
- ℄ - IRON PIN FOUND
- ( ) - RECORDED AS
- TREE

PLAT OF SURVEY OF

LOTS 3-7, BLOCK 16, WOODDALE ADDITION, T 1 N, R 17 E, WALWORTH COUNTY, WISCONSIN.

NOTE: THE EAST LINE OF BLOCK 17 IS ASSUMED DUE NORTH-SOUTH.

9/26/91

ORDERED BY: JAMES BETHKE
801 NORTHHAMPTON
WOODSTOCK, IL. 60098

HAROLD H. KOLB

RECEIVED
MAR 1 2 1992

I, HAROLD H. KOLB, DO HEREBY CERTIFY THAT I HAVE SURVEYED THE PROPERTY HEREON DESCRIBED ACCORDING TO THE OFFICIAL RECORDS, AND THAT THE PLAT HEREON IS A CORRECT REPRESENTATION OF THE LOT LINES TO THE BEST OF MY KNOWLEDGE AND BELIEF. SURVEY NOT VALID UNLESS SURVEYOR'S SIGNATURE IS IN RED.

HAROLD H. KOLB

WISCONSIN REGISTERED LAND SURVEYOR, S- 187

DATE NOVEMBER 18, 1988

REVISED SEPT. 25, 1990


REVISED

1-17-220

KOLB LAND CONSULTING, INC.

LAND SURVEYING · SUBDIVIDING · LAND PLANNING

929 WILLIAMS STREET LAKE GENEVA, WISCONSIN 53147 414-248-3697

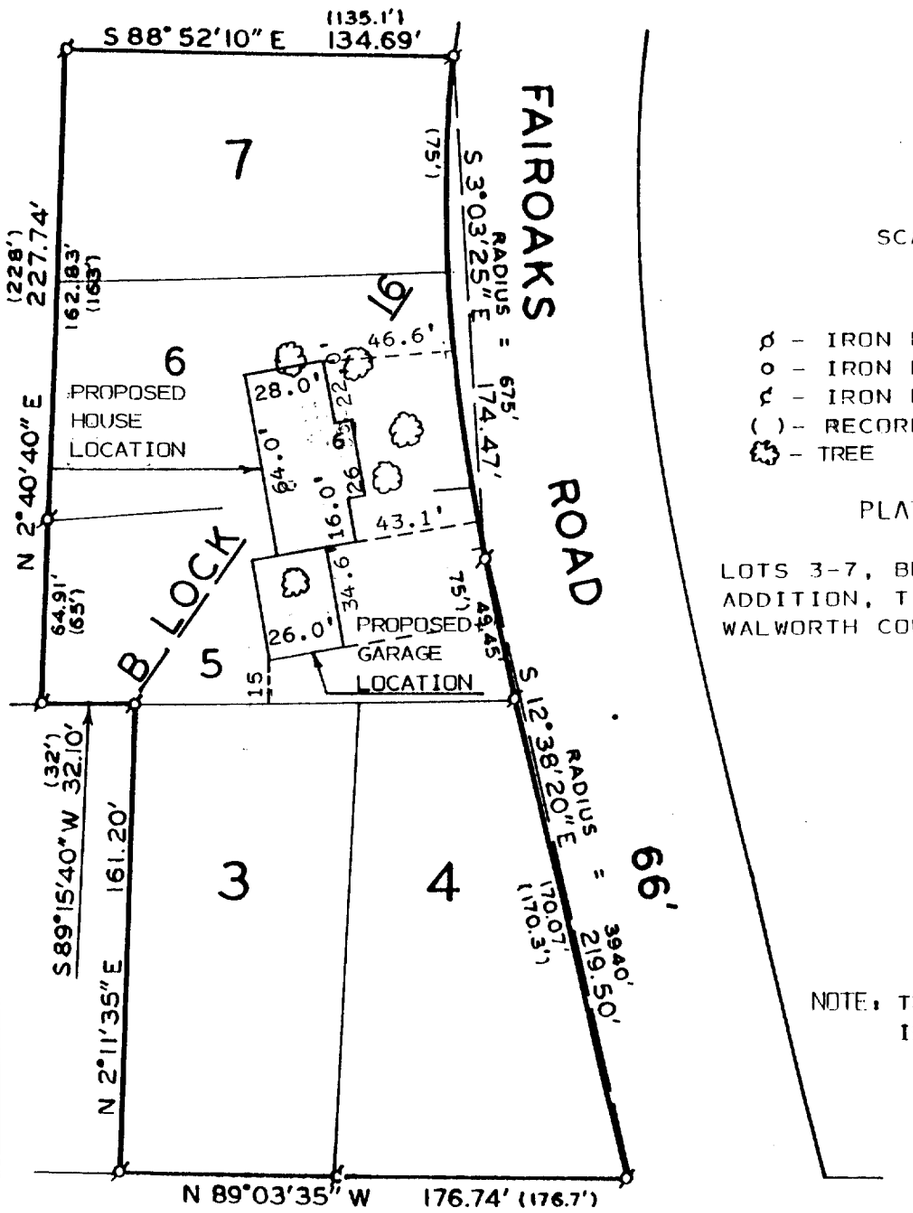

SCALE : 1" = 60'

LEGEND

- ø - IRON PIPE FOUND
- o - IRON PIPE SET
- ⊄ - IRON PIN FOUND
- ( ) - RECORDED AS
- TREE

PLAT OF SURVEY OF

LOTS 3-7, BLOCK 16, WOODDALE ADDITION, T 1 N, R 17 E, WALWORTH COUNTY, WISCONSIN.

NOTE: THE EAST LINE OF BLOCK 17 IS ASSUMED DUE NORTH-SOUTH.

9/26/91

ORDERED BY: JAMES BETHKE
801 NORTHHAMPTON
WOODSTOCK, IL. 60098

HAROLD H. KOLB

RECEIVED
MAR 1 2 1992

I, HAROLD H. KOLB, DO HEREBY CERTIFY THAT I HAVE SURVEYED THE PROPERTY HEREON DESCRIBED ACCORDING TO THE OFFICIAL RECORDS, AND THAT THE PLAT HEREON IS A CORRECT REPRESENTATION OF THE LOT LINES TO THE BEST OF MY KNOWLEDGE AND BELIEF. SURVEY NOT VALID UNLESS SURVEYOR'S SIGNATURE IS IN RED.

HAROLD H. KOLB

WISCONSIN REGISTERED LAND SURVEYOR, S- 187

DATE NOVEMBER 18, 1988

REVISED SEPT.25, 1990

REVISED OCTOBER 11, 1991

117-1220

1-17-220 IW-80A