
KOLB LAND CONSULTING, INC.
LAND SURVEYING · SUBDIVIDING · LAND PLANNING
929 WILLIAMS STREET LAKE GENEVA, WISCONSIN 53147 414-248-3697

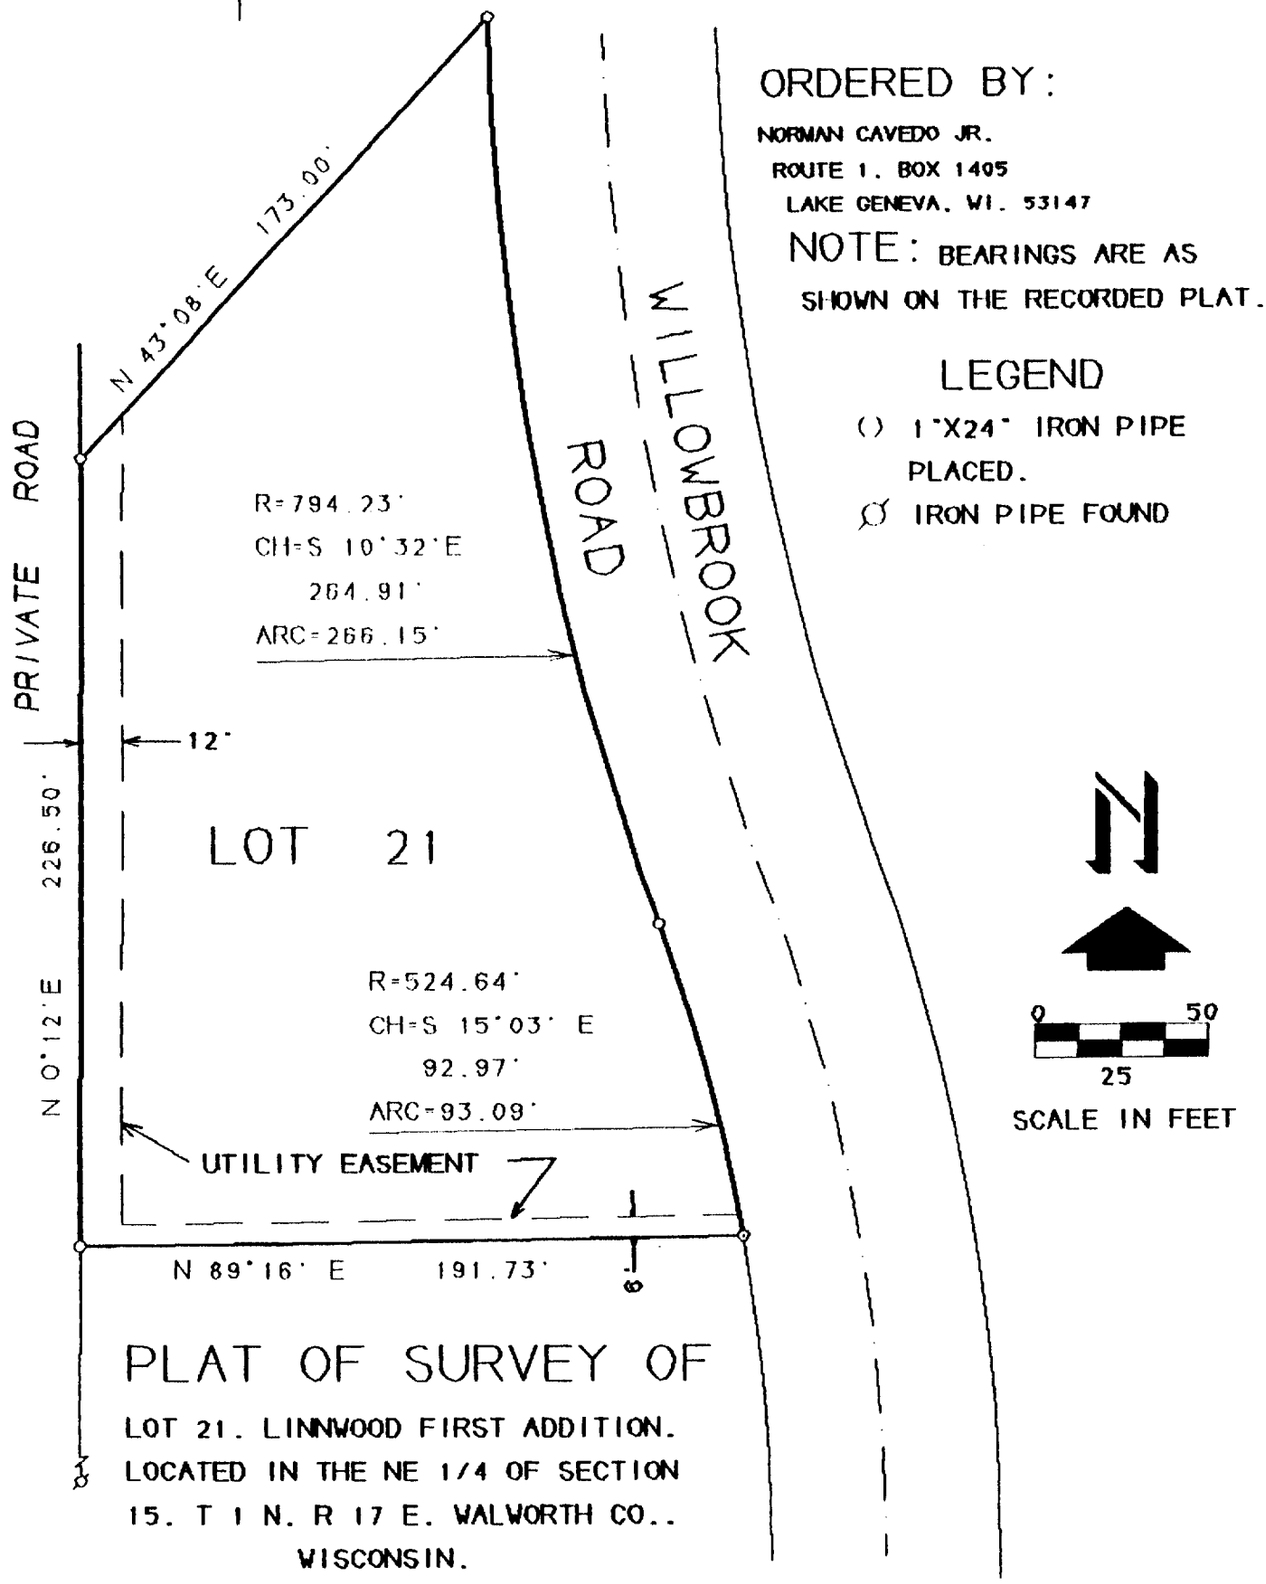

ORDERED BY:

NORMAN CAVEDO JR.
ROUTE 1, BOX 1405
LAKE GENEVA, WI. 53147

NOTE: BEARINGS ARE AS SHOWN ON THE RECORDED PLAT.

LEGEND

() 1"X24" IRON PIPE PLACED.

Ø IRON PIPE FOUND

PLAT OF SURVEY OF

LOT 21, LINNWOOD FIRST ADDITION, LOCATED IN THE NE 1/4 OF SECTION 15, T 1 N, R 17 E, WALWORTH CO., WISCONSIN.

RECEIVED
MAR 25 1993

I, HAROLD H. KOLB, DO HEREBY CERTIFY THAT I HAVE SURVEYED THE PROPERTY HEREON DESCRIBED ACCORDING TO THE OFFICAL RECORDS, AND THAT THE PLAT HEREON IS A CORRECT REPRESENTATION OF THE LOT LINES TO THE BEST OF MY KNOWLEDGE AND BELIEF.

NOTE: SURVEY IS NOT VALID UNLESS SURVEYOR'S SIGNATURE IS IN RED.

HAORLD H. KOLB
WISCONSIN REGISTERED LAND SURVEYOR, S-187

DATE: JUNE 20, 1981

ILKlm-6