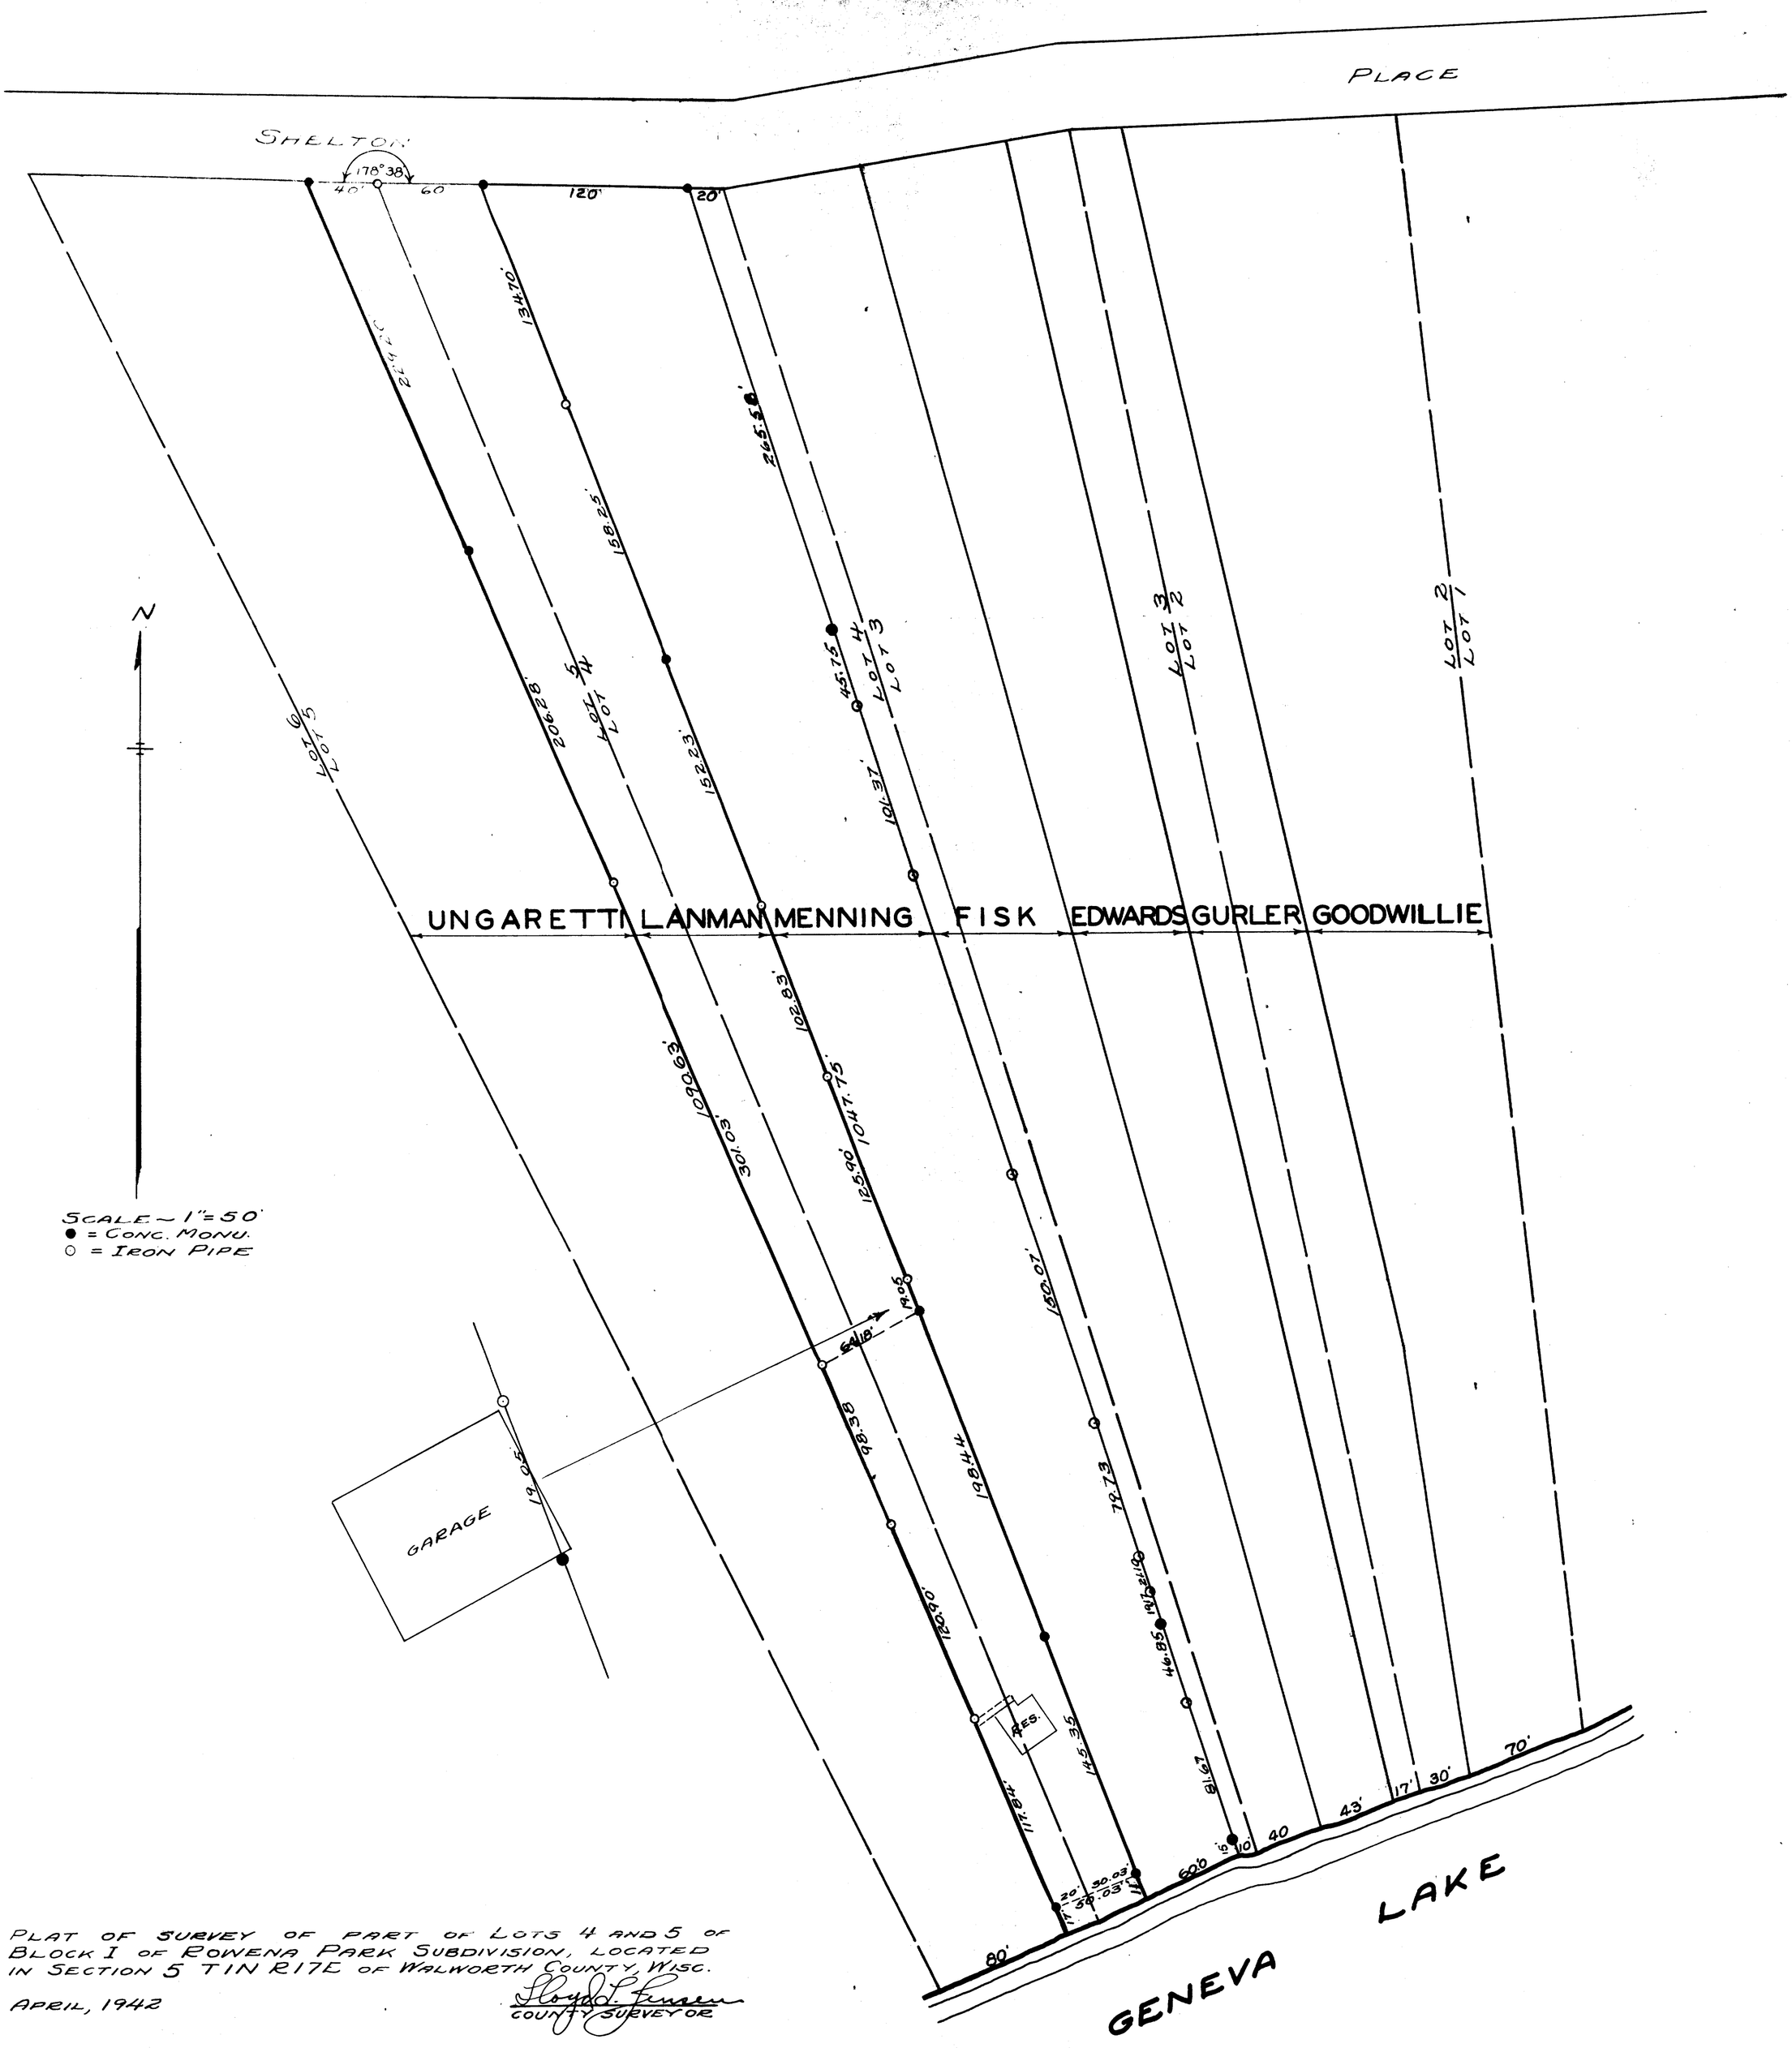


PLAT OF SURVEY OF PART OF LOTS 4 AND 5 OF BLOCK I OF ROWENA PARK SUBDIVISION, LOCATED IN SECTION 5 T1N R17E OF WALWORTH COUNTY, WISC.

APRIL, 1942

Lloyd L. Linnan
COUNTY SURVEYOR

117-13

IRP- 6