
PLAT OF SURVEY

SANITARY SEWER EASEMENT
FOR
LOT 8 OF LORAMOOR SUBDIVISION
SEC. 11, T. 17 E., R. 17 E.
LINN TOWNSHIP, WALWORTH COUNTY, WI.

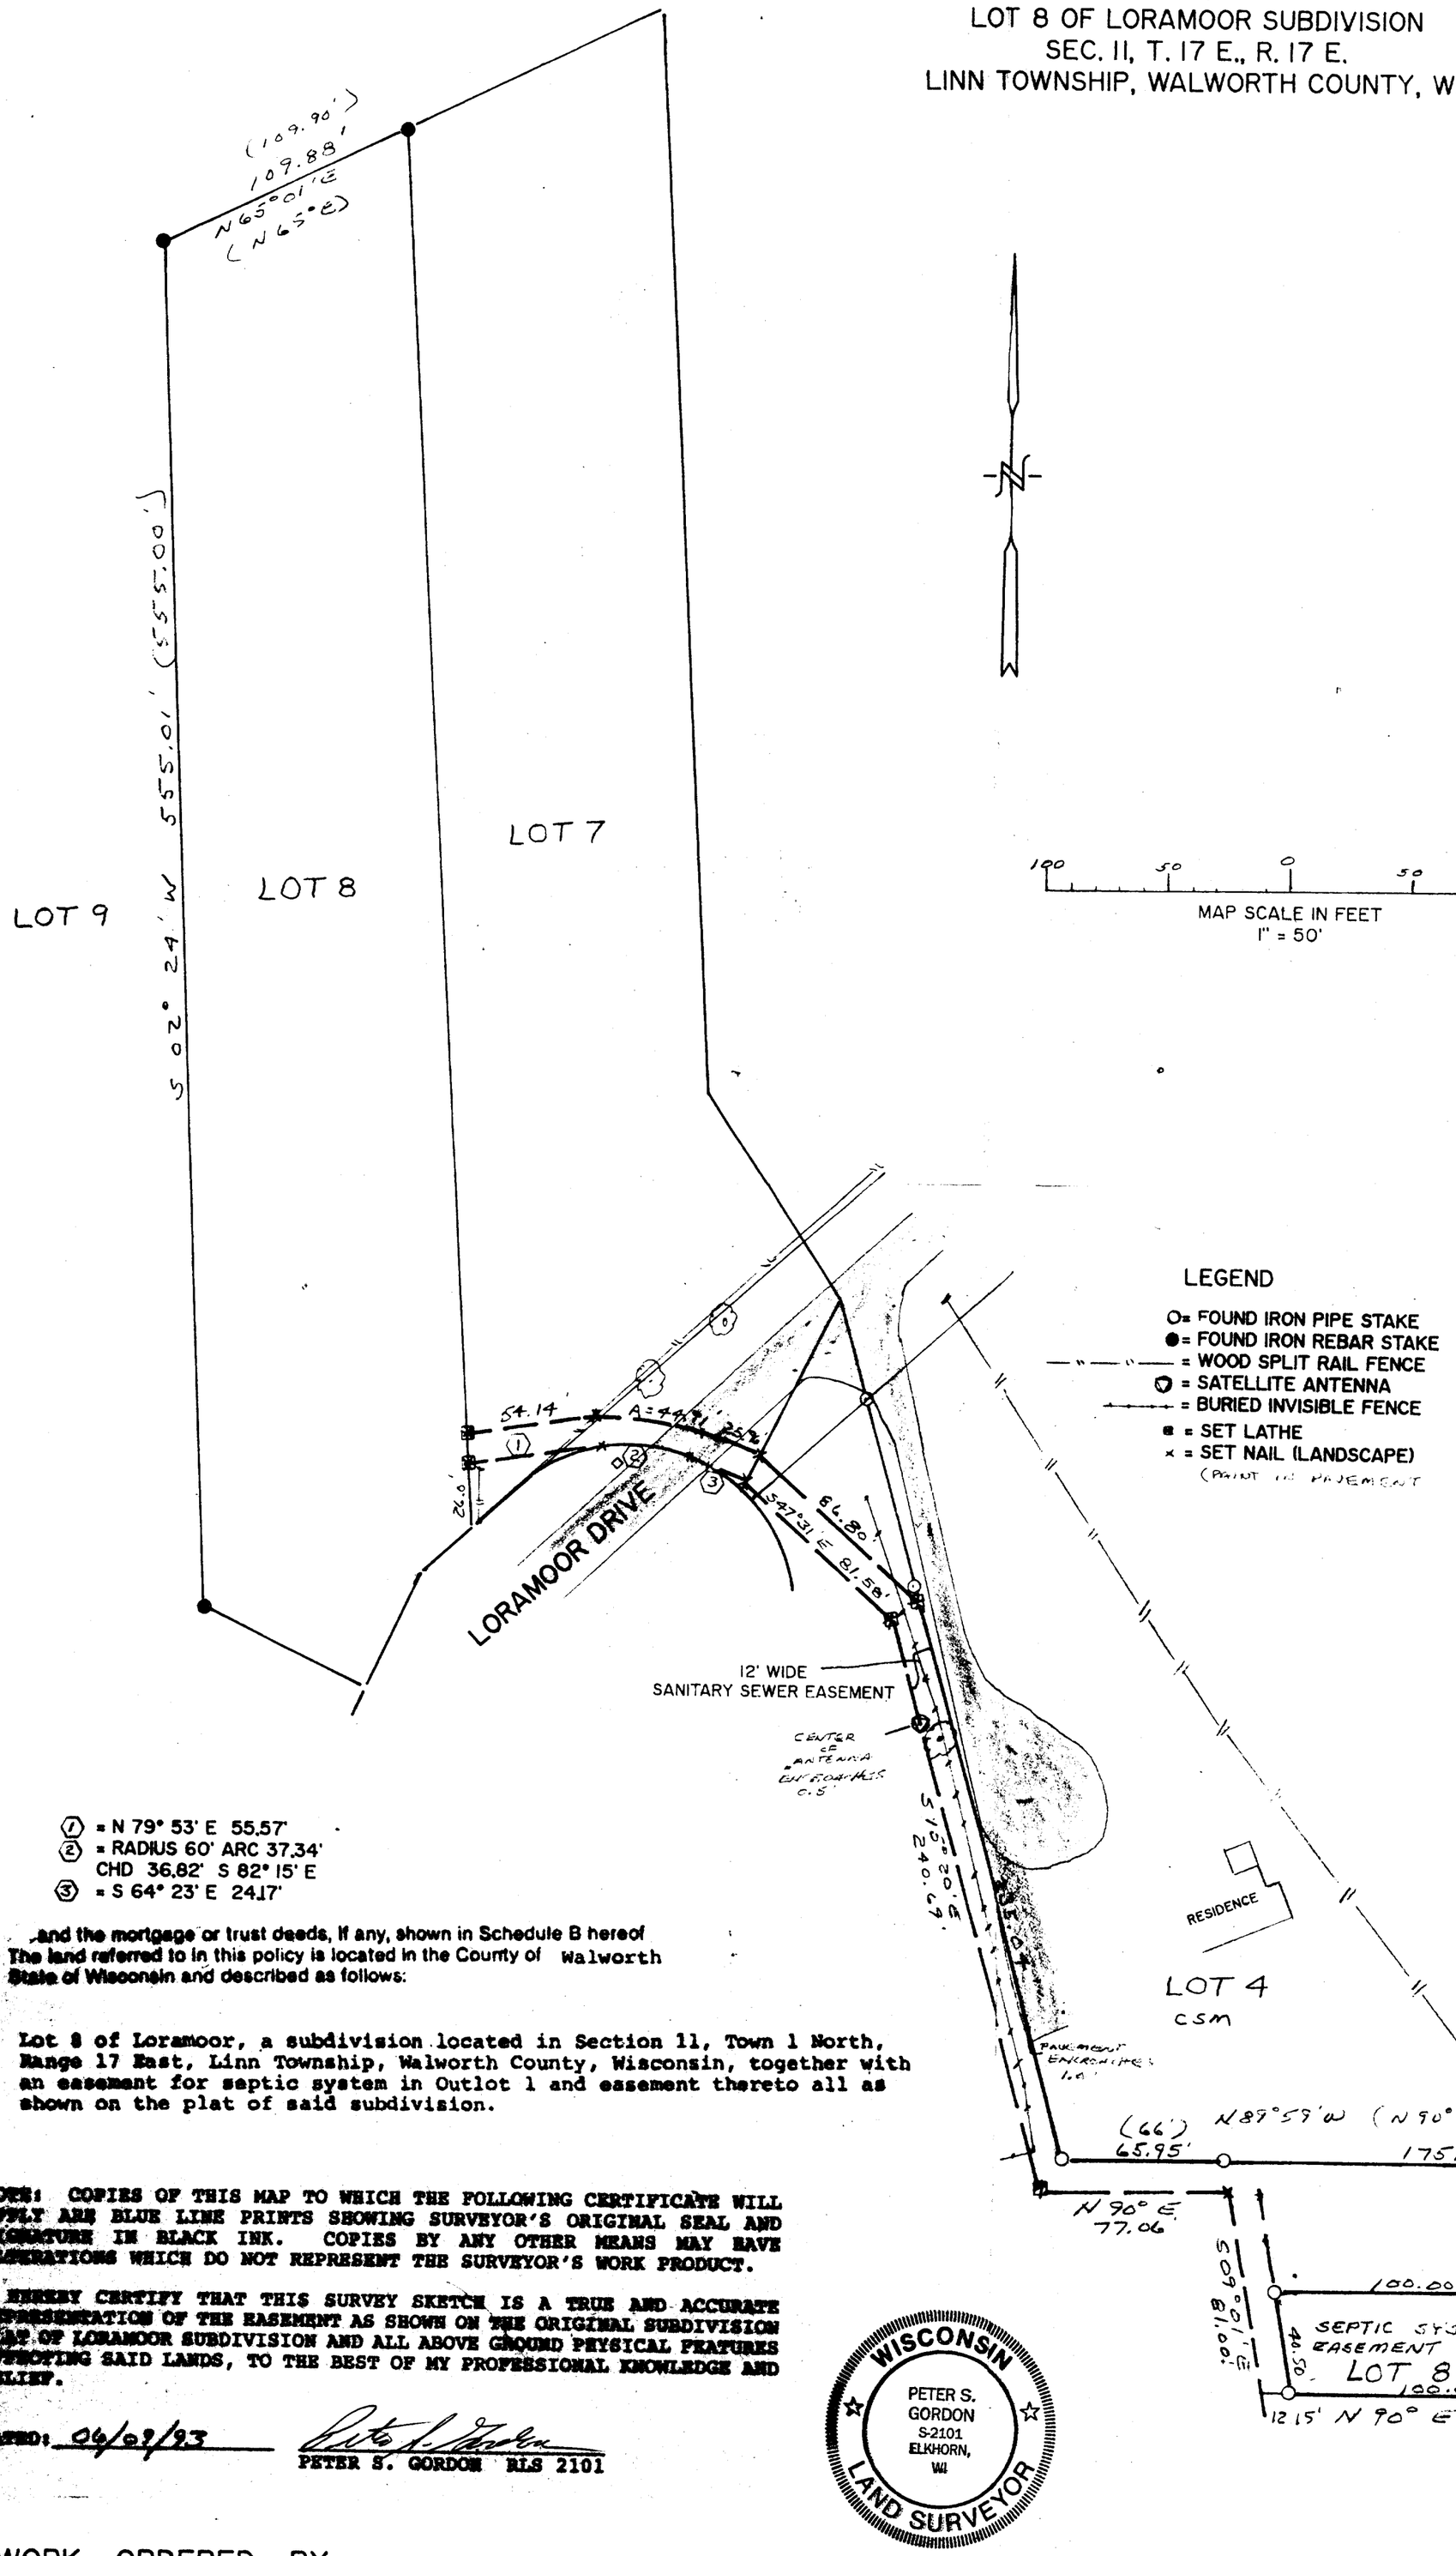

① = N 79° 53' E 55.57'
② = RADIUS 60' ARC 37.34'
CHD 36.82' S 82° 15' E
③ = S 64° 23' E 24.17'

and the mortgage or trust deeds, if any, shown in Schedule B hereof

5. The land referred to in this policy is located in the County of Walworth State of Wisconsin and described as follows:

Lot 8 of Loramoor, a subdivision located in Section 11, Town 1 North, Range 17 East, Linn Township, Walworth County, Wisconsin, together with an easement for septic system in Outlot 1 and easement thereto all as shown on the plat of said subdivision.

NOTE: COPIES OF THIS MAP TO WHICH THE FOLLOWING CERTIFICATE WILL APPLY ARE BLUE LINE PRINTS SHOWING SURVEYOR'S ORIGINAL SEAL AND SIGNATURE IN BLACK INK. COPIES BY ANY OTHER MEANS MAY HAVE ALTERATIONS WHICH DO NOT REPRESENT THE SURVEYOR'S WORK PRODUCT.

I HEREBY CERTIFY THAT THIS SURVEY SKETCH IS A TRUE AND ACCURATE REPRESENTATION OF THE EASEMENT AS SHOWN ON THE ORIGINAL SUBDIVISION PLAT OF LORAMOOR SUBDIVISION AND ALL ABOVE GROUND PHYSICAL FEATURES AFFECTING SAID LANDS, TO THE BEST OF MY PROFESSIONAL KNOWLEDGE AND BELIEF.

DATED: 06/08/93

PETER S. GORDON RLS 2101

WISCONSIN
PETER S. GORDON
S-2101
ELKHORN, WI
LAND SURVEYOR

WORK ORDERED BY: DAVID SCHILTZ

ILWL-8

RECEIVED
JUN 21 1993

FARRIS, HANSEN & ASSOCIATES, INC.
Engineering, Architecture, Surveying
7 Ridgway Court P.O. Box 437
ELKHORN, WISCONSIN 53121
Office: (414) 723-2098
Fax: (414) 723-5886

REVISIONS

PROJECT NO 3846
DATE 06/08/93
SHEET NO. 1 OF 1

117-1320