
KOLB LAND CONSULTING, INC.

LAND SURVEYING · SUBDIVIDING · LAND PLANNING

929 WILLIAMS STREET LAKE GENEVA, WISCONSIN 53147 414 248-3697

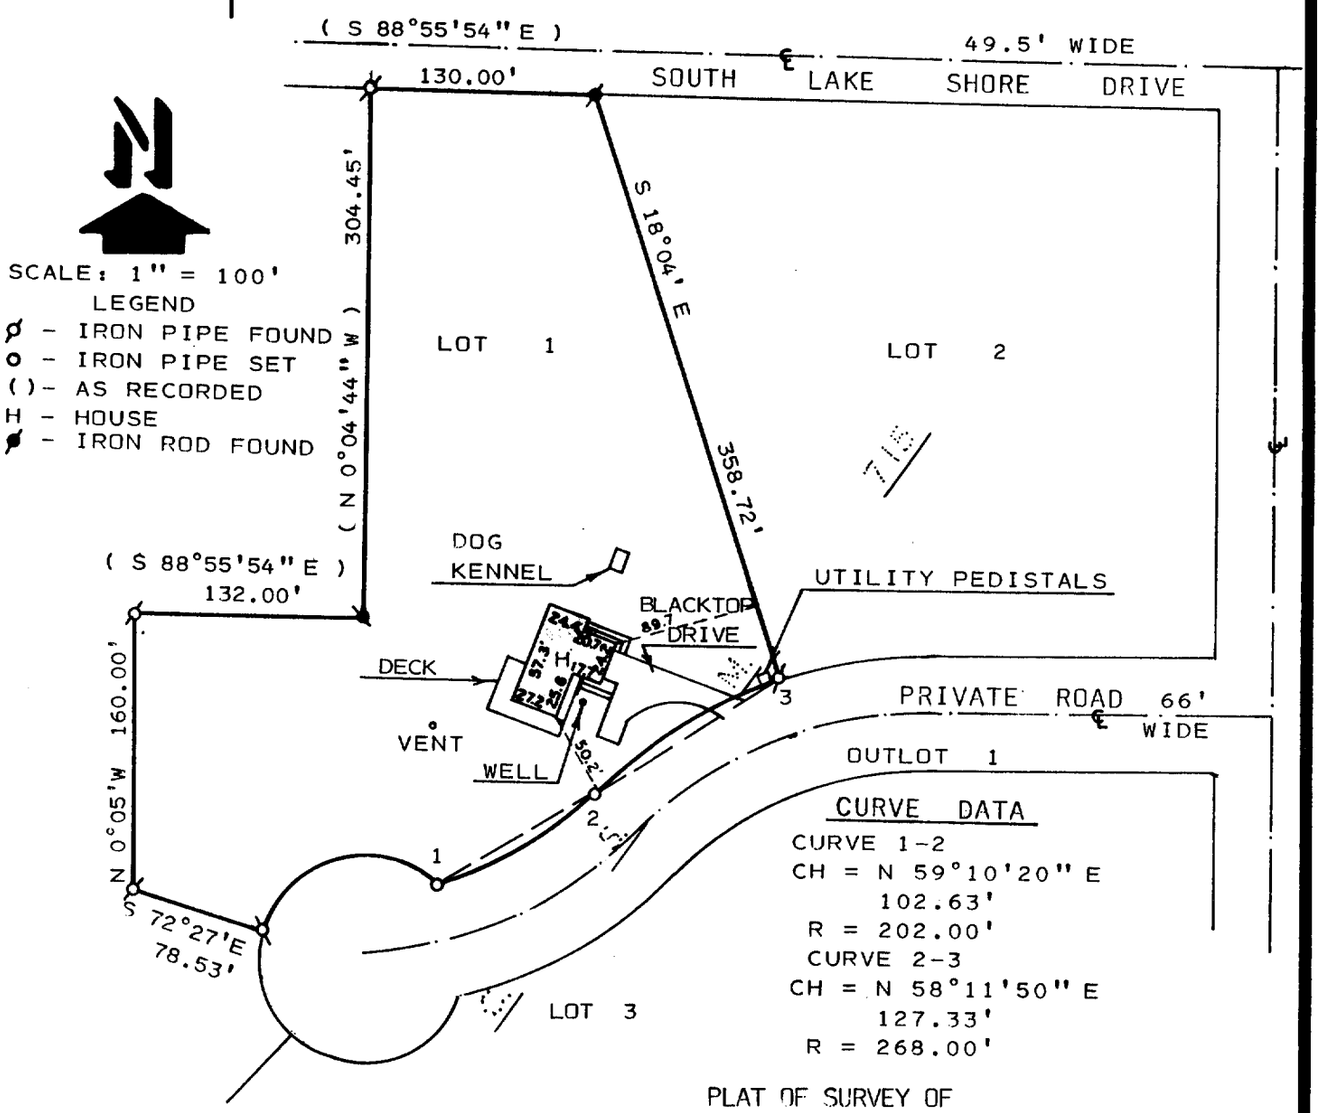

SCALE: 1" = 100'

LEGEND

- ⌀ - IRON PIPE FOUND
- o - IRON PIPE SET
- ( ) - AS RECORDED
- H - HOUSE
- ⌀ - IRON ROD FOUND

CURVE DATA

CURVE 1-2
CH = N 59°10'20" E
102.63'
R = 202.00'
CURVE 2-3
CH = N 58°11'50" E
127.33'
R = 268.00'


PLAT OF SURVEY OF

LOT 1 OF CERTIFIED SURVEY MAP NO. 715 LOCATED IN THE SOUTHEAST 1/4 OF SECTION 18, T1N, R17E, TOWN OF LINN, WALWORTH COUNTY, WISCONSIN.

ORDERED BY: THE RAULAND AGENCY
118 KENOSHA
WALWORTH, WI.53184

NOTE: BEARINGS ARE ASSUMED AS SHOWN ON RECORDED C.S.M. #715.

I HEREBY CERTIFY THAT I HAVE SURVEYED THE ABOVE DESCRIBED PROPERTY AND THAT THE ABOVE MAP IS A TRUE REPRESENTATION THEREOF AND SHOWS THE SIZE AND LOCATION OF THE PROPERTY, ITS EXTERIOR BOUNDARIES, THE LOCATION OF ALL VISIBLE STRUCTURES AND DIMENSIONS OF ALL PRINCIPAL BUILDINGS THEREON, BOUNDARY FENCES, APPARENT EASEMENTS, ROADWAYS AND VISIBLE ENCROACHMENTS, IF ANY, TO THE BEST OF MY KNOWLEDGE AND BELIEF.
THIS SURVEY IS MADE FOR THE USE OF THE PRESENT OWNERS OF THE PROPERTY AND ALSO THOSE WHO PURCHASE, MORTGAGE OR GUARANTEE THE TITLE THERETO WITHIN ONE (1) YEAR FROM DATE HEREOF.
SURVEY NOT VALID UNLESS SURVEYOR'S SIGNATURE IS IN RED.

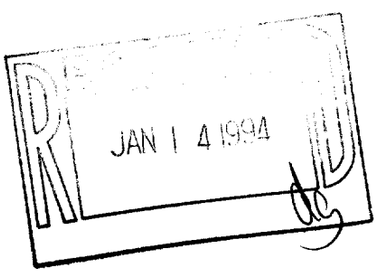

HAROLD H. KOLB

WISCONSIN REGISTERED LAND SURVEYOR, S-187

DATE NOVEMBER 30, 1993

REVISED

REVISED

1-17-146

IA-715-1

117-1382