
KOLB LAND CONSULTING, INC.

LAND SURVEYING · SUBDIVIDING · LAND PLANNING

929 WILLIAMS STREET LAKE GENEVA, WISCONSIN 53147 414-248-3697

NOTE: BEARINGS ARE REFERENCED TO THE WISCONSIN COORDINATE SYSTEM, SOUTH ZONE.

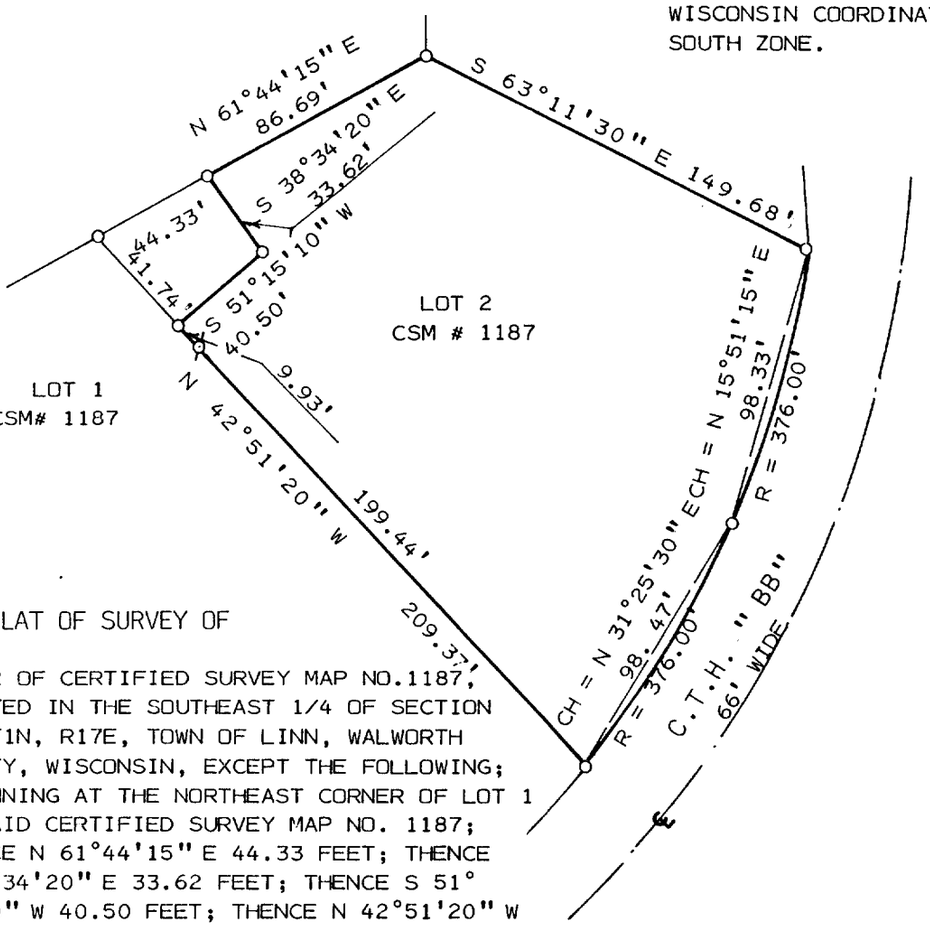

PLAT OF SURVEY OF

LOT 2 OF CERTIFIED SURVEY MAP NO.1187, LOCATED IN THE SOUTHEAST 1/4 OF SECTION 11, T1N, R17E, TOWN OF LINN, WALWORTH COUNTY, WISCONSIN, EXCEPT THE FOLLOWING; BEGINNING AT THE NORTHEAST CORNER OF LOT 1 OF SAID CERTIFIED SURVEY MAP NO. 1187; THENCE N 61°44'15" E 44.33 FEET; THENCE S 38°34'20" E 33.62 FEET; THENCE S 51° 15'10" W 40.50 FEET; THENCE N 42°51'20" W 41.74 FEET TO THE PLACE OF BEGINNING. CONTAINING 0.04 ACRES.

ORDERED BY: TOM JACOBS
RT. 1 BOX 26
LAKE GENEVA, WI. 53147

NOTE: THIS IS A LOT LINE ADJUSTMENT.

SCALE: 1" = 60'

LEGEND

ø - IRON PIPE FOUND

o - IRON PIPE SET

I HEREBY CERTIFY THAT I HAVE SURVEYED THE ABOVE DESCRIBED PROPERTY AND THAT THE ABOVE MAP IS A TRUE REPRESENTATION THEREOF AND SHOWS THE SIZE AND LOCATION OF THE PROPERTY, ITS EXTERIOR BOUNDARIES, THE LOCATION OF ALL VISIBLE STRUCTURES AND DIMENSIONS OF ALL PRINCIPAL BUILDINGS THEREON, BOUNDARY FENCES, APPARENT EASEMENTS, ROADWAYS AND VISIBLE ENCROACHMENTS, IF ANY, TO THE BEST OF MY KNOWLEDGE AND BELIEF.
THIS SURVEY IS MADE FOR THE USE OF THE PRESENT OWNERS OF THE PROPERTY AND ALSO THOSE WHO PURCHASE, MORTGAGE OR GUARANTEE THE TITLE THERETO WITHIN ONE (1) YEAR FROM DATE HEREOF.
SURVEY NOT VALID UNLESS SURVEYOR'S SIGNATURE IS IN RED.

RECEIVED
JAN 1 4 2004

HAROLD H. KOLB

WISCONSIN REGISTERED LAND SURVEYOR, S-187

DATE _____

REVISED _____

REVISED _____

IA-1187-2


1-17-29 117-1384

KOLB LAND CONSULTING, INC.

LAND SURVEYING · SUBDIVIDING · LAND PLANNING

929 WILLIAMS STREET LAKE GENEVA, WISCONSIN 53147 414-248-3697

NOTE: BEARINGS ARE REFERENCED TO THE WISCONSIN COORDINATE SYSTEM, SOUTH ZONE.

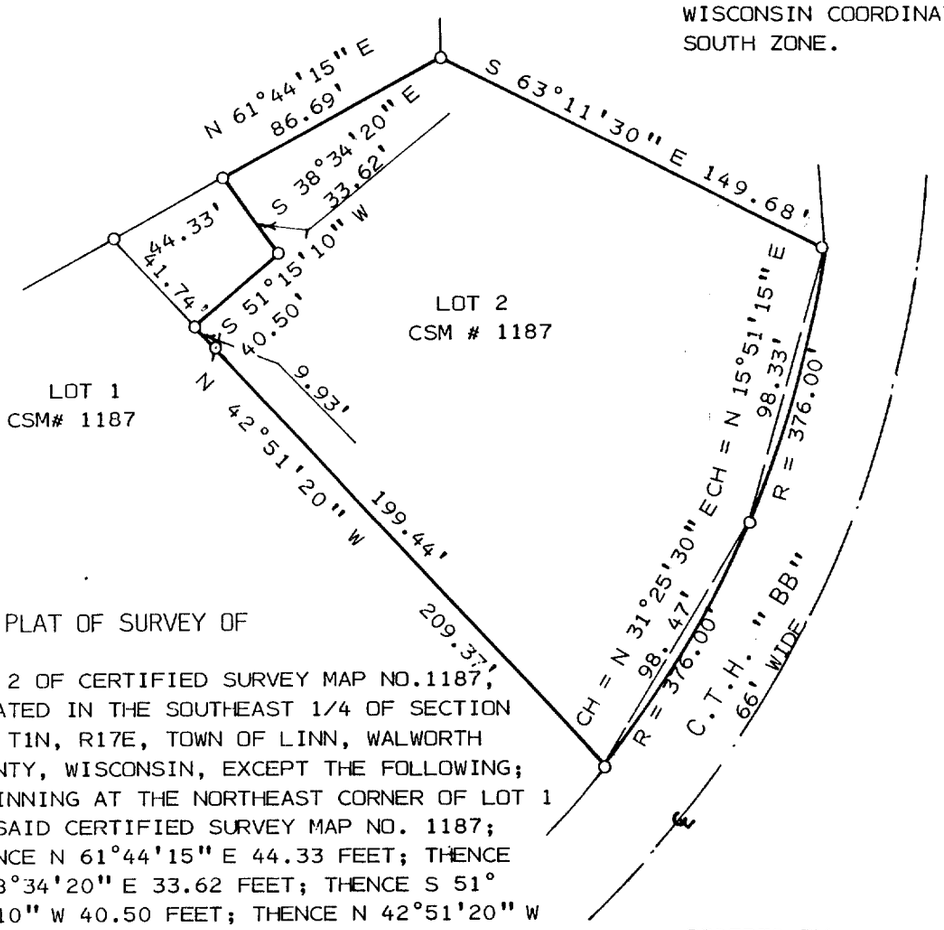

PLAT OF SURVEY OF

LOT 2 OF CERTIFIED SURVEY MAP NO.1187, LOCATED IN THE SOUTHEAST 1/4 OF SECTION 11, T1N, R17E, TOWN OF LINN, WALWORTH COUNTY, WISCONSIN, EXCEPT THE FOLLOWING; BEGINNING AT THE NORTHEAST CORNER OF LOT 1 OF SAID CERTIFIED SURVEY MAP NO. 1187; THENCE N 61°44'15" E 44.33 FEET; THENCE S 38°34'20" E 33.62 FEET; THENCE S 51° 15'10" W 40.50 FEET; THENCE N 42°51'20" W 41.74 FEET TO THE PLACE OF BEGINNING. CONTAINING 0.04 ACRES.

ORDERED BY: TOM JACOBS
RT. 1 BOX 26
LAKE GENEVA, WI. 53147

NOTE: THIS IS A LOT LINE ADJUSTMENT.

SCALE: 1" = 60'

LEGEND

ø - IRON PIPE FOUND

o - IRON PIPE SET

RECEIVED
JAN [illegible]

I HEREBY CERTIFY THAT I HAVE SURVEYED THE ABOVE DESCRIBED PROPERTY AND THAT THE ABOVE MAP IS A TRUE REPRESENTATION THEREOF AND SHOWS THE SIZE AND LOCATION OF THE PROPERTY, ITS EXTERIOR BOUNDARIES, THE LOCATION OF ALL VISIBLE STRUCTURES AND DIMENSIONS OF ALL PRINCIPAL BUILDINGS THEREON, BOUNDARY FENCES, APPARENT EASEMENTS, ROADWAYS AND VISIBLE ENCROACHMENTS, IF ANY, TO THE BEST OF MY KNOWLEDGE AND BELIEF.
THIS SURVEY IS MADE FOR THE USE OF THE PRESENT OWNERS OF THE PROPERTY AND ALSO THOSE WHO PURCHASE, MORTGAGE OR GUARANTEE THE TITLE THERETO WITHIN ONE (1) YEAR FROM DATE HEREOF.
SURVEY NOT VALID UNLESS SURVEYOR'S SIGNATURE IS IN RED.

HAROLD H. KOLB

WISCONSIN REGISTERED LAND SURVEYOR, S-187

DATE SEPTEMBER 2, 1992

REVISED

REVISED

1-17-29