
KOLB LAND CONSULTING, INC.

LAND SURVEYING · SUBDIVIDING · LAND PLANNING

929 WILLIAMS STREET LAKE GENEVA, WISCONSIN 53147 414 248 3697

ORDERED BY: JOHN ENGERMAN,
ENGERMAN CONTRACTING
ROUTE 1, BOX 1412
LAKE GENEVA, WI.
53417

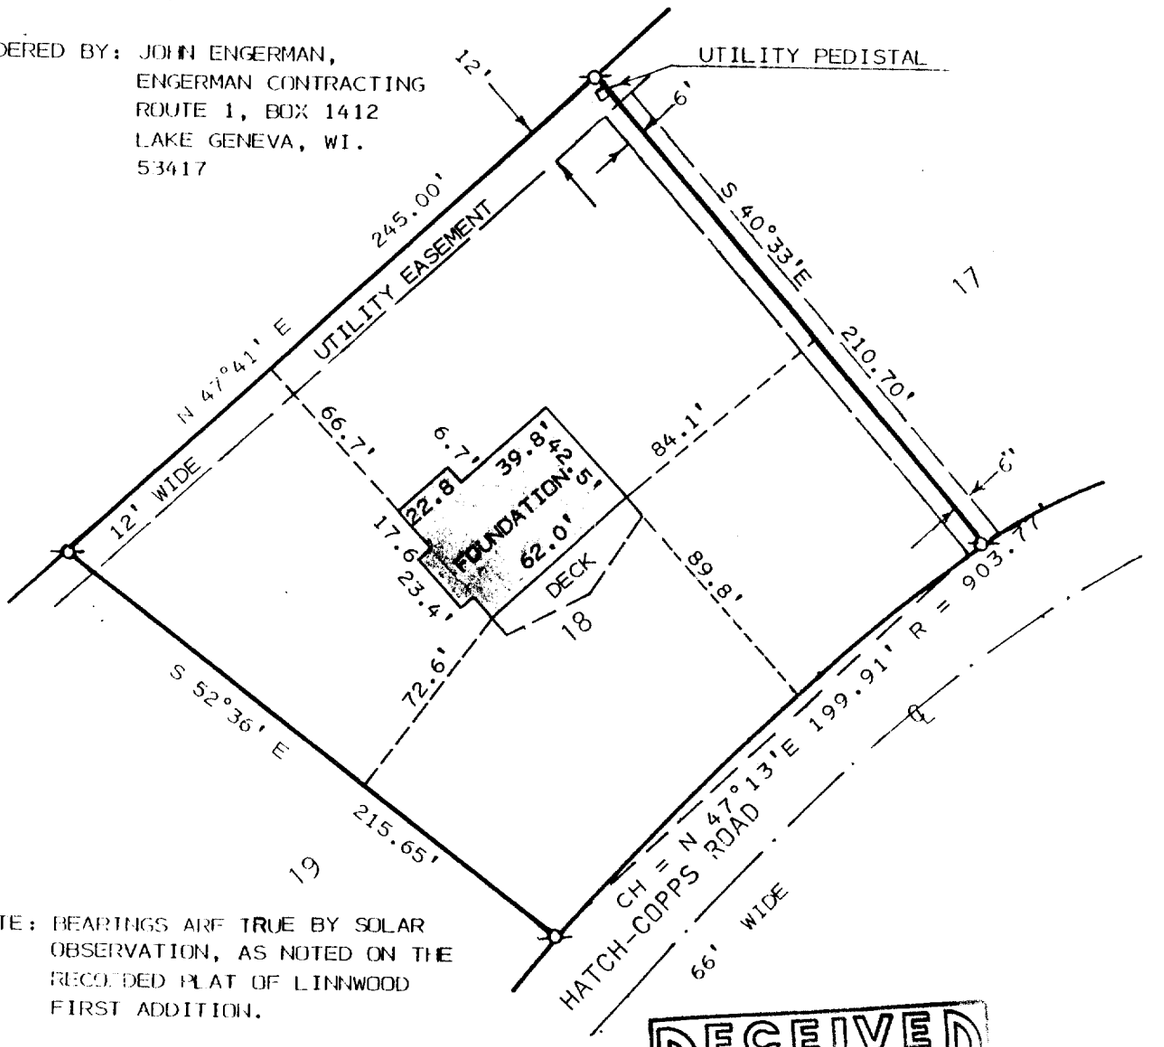

NOTE: BEARINGS ARE TRUE BY SOLAR OBSERVATION, AS NOTED ON THE RECORDED PLAT OF LINNWOOD FIRST ADDITION.

PLAT OF SURVEY OF


LOT 18 OF LINNWOOD 1ST ADDITION
A SUBDIVISION LOCATED IN THE
NORTHEAST 1/4 OF SECTION 15, T1N,
R17E, TOWN OF LINN, WALWORTH
COUNTY, WISCONSIN.



SCALE 1" = 60'

LEGEND

ø — IRON PIPE FOUND

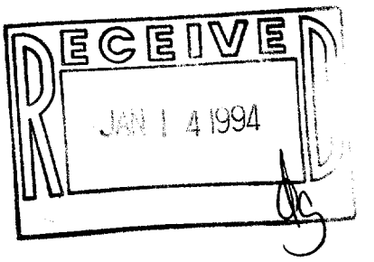

I HEREBY CERTIFY THAT I HAVE SURVEYED THE ABOVE DESCRIBED PROPERTY AND THAT THE ABOVE MAP IS A TRUE REPRESENTATION THEREOF AND SHOWS THE SIZE AND LOCATION OF THE PROPERTY, ITS EXTERIOR BOUNDARIES, THE LOCATION OF ALL VISIBLE STRUCTURES AND THE DIMENSIONS OF ALL PRINCIPAL BUILDINGS THEREON, BOUNDARY FENCES, APPARENT EASEMENTS, ROADWAYS AND VISIBLE ENCROACHMENTS, IF ANY TO THE BEST OF MY KNOWLEDSE AND BELIEF.
THIS SURVEY IS MADE FOR THE USE OF THE PRESENT OWNERS OF THE PROPERTY, AND ALSO THOSE WHO PURCHASE, MORGAGE, OR GUARANTEE THE TITLE THERETO WITHIN ONE (1) YEAR FROM DATE HEREOF. SURVEY NOT VALID UNLESS SURVEYOR'S SIGNATURE IS IN RED.

HAROLD H. KOLB

WISCONSIN REGISTERED LAND SURVEYOR, S 187

DATE FEBRUARY 26, 1993

REVISED JULY 2, 1993

REVISED

ICWA-3

1-17-327


117-1385

KOLB LAND CONSULTING, INC.

LAND SURVEYING · SUBDIVIDING · LAND PLANNING

929 WILLIAMS STREET LAKE GENEVA, WISCONSIN 53147 414 248-3697

ORDERED BY: JOHN ENGERMAN,
ENGERMAN CONTRACTING
ROUTE 1, BOX 1412
LAKE GENEVA, WI.
53417

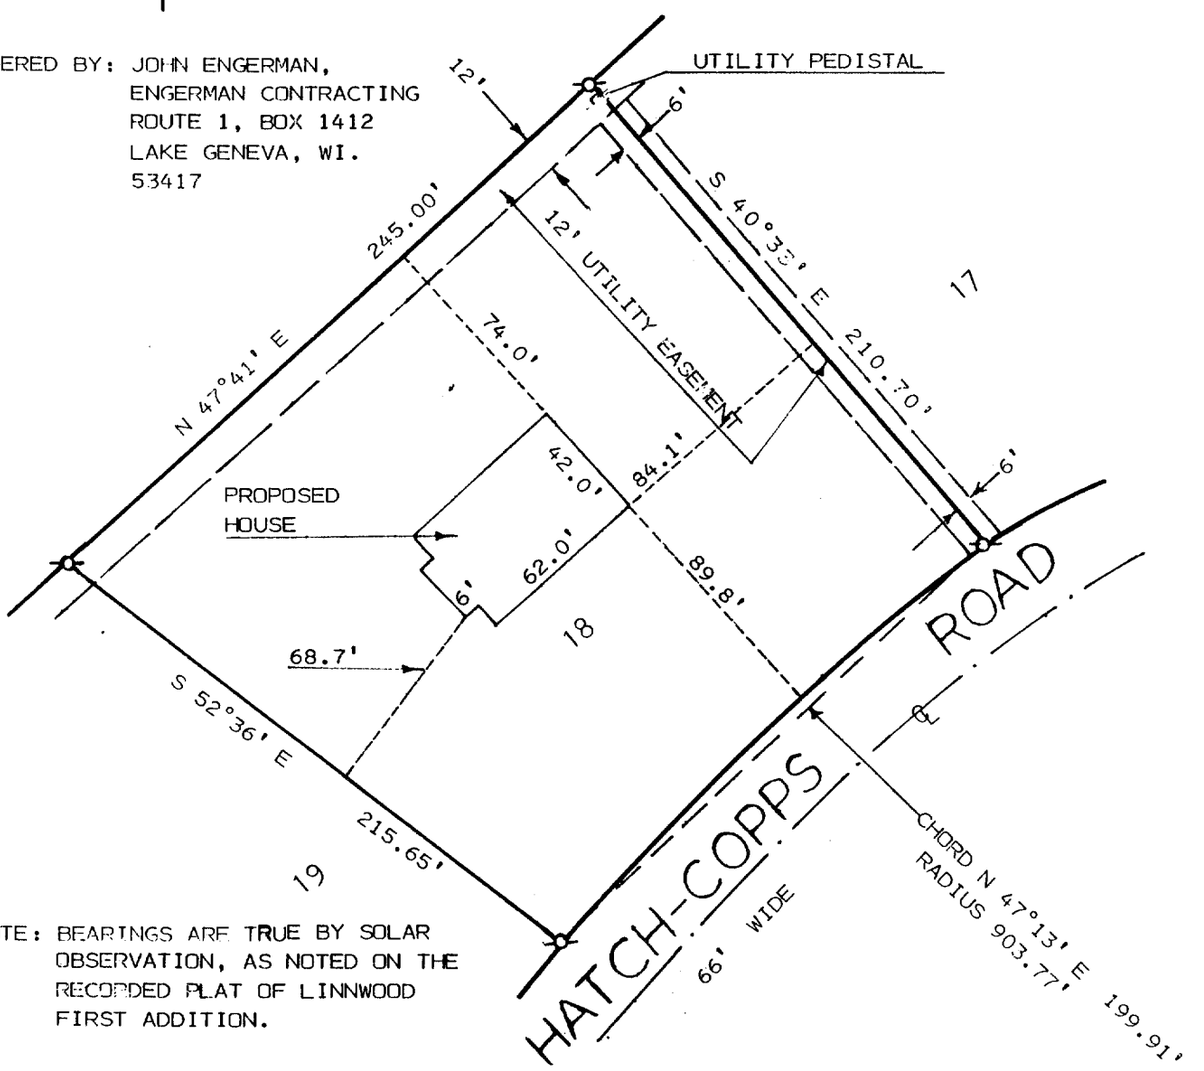

NOTE: BEARINGS ARE TRUE BY SOLAR OBSERVATION, AS NOTED ON THE RECORDED PLAT OF LINNWOOD FIRST ADDITION.

PLAT OF SURVEY OF

LOT 18 OF LINNWOOD 1ST ADDITION
A SUBDIVISION LOCATED IN THE
NORTHEAST 1/4 OF SECTION 15, T1N,
R17E, TOWN OF LINN, WALWORTH
COUNTY, WISCONSIN.

SCALE 1" = 60'

LEGEND

ø - IRON PIPE FOUND

RECEIVED

I HEREBY CERTIFY THAT I HAVE SURVEYED THE ABOVE DESCRIBED PROPERTY AND THAT THE ABOVE MAP IS A TRUE REPRESENTATION THEREOF AND SHOWS THE SIZE AND LOCATION OF THE PROPERTY, ITS EXTERIOR BOUNDARIES, THE LOCATION OF ALL VISIBLE STRUCTURES AND THE DIMENSIONS OF ALL PRINCIPAL BUILDINGS THEREON, BOUNDARY FENCES, APPARENT EASEMENTS, ROADWAYS AND VISIBLE ENCROACHMENTS, IF ANY TO THE BEST OF MY KNOWLEDSE AND BELIEF.
THIS SURVEY IS MADE FOR THE USE OF THE PRESENT OWNERS OF THE PROPERTY, AND ALSO THOSE WHO PURCHASE, MORGAGE, OR GUARANTEE THE TITLE THERETO WITHIN ONE (1) YEAR FRON DATE HEREOF. SURVEY NOT VALID UNLESS SURVEYOR'S SIGNATURE IS IN RED.

HAROLD H. KOLB

WISCONSIN REGISTERED LAND SURVEYOR, S-187

DATE FEBRUARY 26, 1993

REVISED

REVISED

1-17-327