
PLAT OF SURVEY

LOT 1 OF C.S.M. 1644

RECORDED IN VOLUME NO. 7 ON PAGE NO. 338, AS DOCUMENT NO. 156078 OF WALWORTH COUNTY CERTIFIED SURVEY MAPS
LOCATED IN THE SE 1/4 OF SECTION 15, TOWN 1 NORTH, RANGE 17 EAST, WALWORTH COUNTY, WISCONSIN

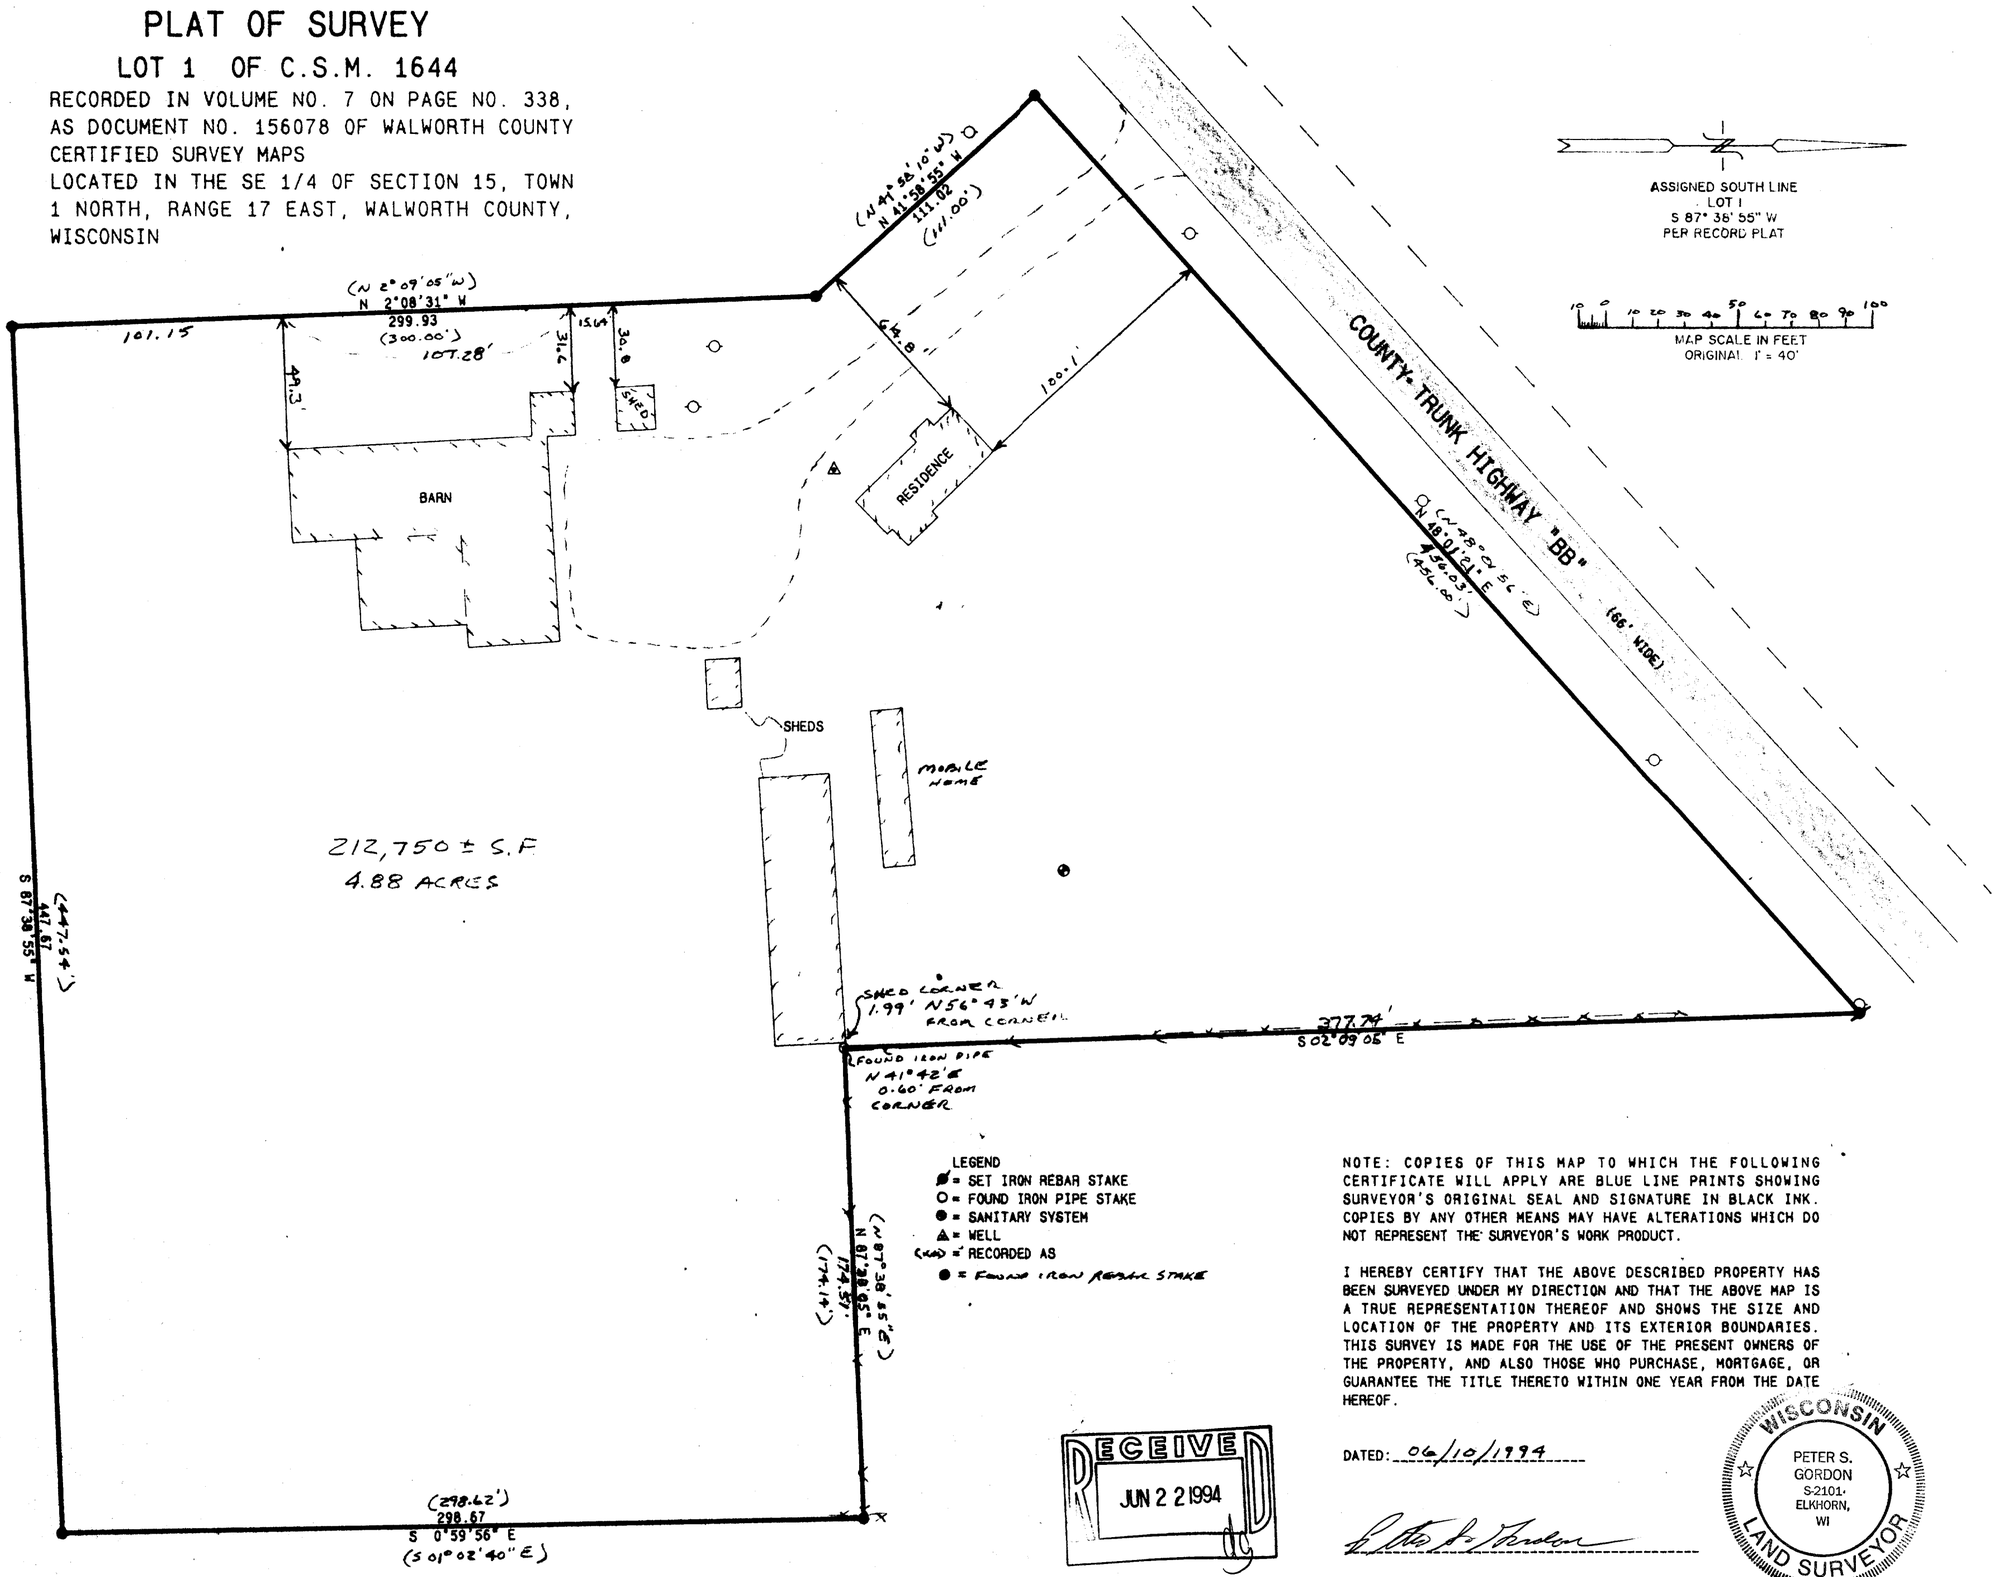

LEGEND
- ● = SET IRON REBAR STAKE
- O = FOUND IRON PIPE STAKE
- ● = SANITARY SYSTEM
- ▲ = WELL
- (XXX) = RECORDED AS
- ● = FOUND IRON REBAR STAKE

NOTE: COPIES OF THIS MAP TO WHICH THE FOLLOWING CERTIFICATE WILL APPLY ARE BLUE LINE PRINTS SHOWING SURVEYOR'S ORIGINAL SEAL AND SIGNATURE IN BLACK INK. COPIES BY ANY OTHER MEANS MAY HAVE ALTERATIONS WHICH DO NOT REPRESENT THE SURVEYOR'S WORK PRODUCT.

I HEREBY CERTIFY THAT THE ABOVE DESCRIBED PROPERTY HAS BEEN SURVEYED UNDER MY DIRECTION AND THAT THE ABOVE MAP IS A TRUE REPRESENTATION THEREOF AND SHOWS THE SIZE AND LOCATION OF THE PROPERTY AND ITS EXTERIOR BOUNDARIES. THIS SURVEY IS MADE FOR THE USE OF THE PRESENT OWNERS OF THE PROPERTY, AND ALSO THOSE WHO PURCHASE, MORTGAGE, OR GUARANTEE THE TITLE THERETO WITHIN ONE YEAR FROM THE DATE HEREOF.

DATED: 06/10/1994

PETER S. GORDON
S-2101
ELKHORN, WI
WISCONSIN LAND SURVEYOR

RECEIVED
JUN 2 2 1994

WORK ORDERED BY:
RENEE LILJEGREN
W 3449 C.T.H. BB
LAKE GENEVA, WI.

FARRIS, HANSEN & ASSOCIATES, INC.
Engineering, Architecture, Surveying
7 Ridgeway Court P.O. Box 437
ELKHORN, WISCONSIN 53121
Office: (414) 723-2098
Fax: (414) 723-5886

REVISIONS

PROJECT NO. 4098
DATE 06/10/94
SHEET NO. 1 of 1

IA-1644-1

117-1396