
PLAT OF SURVEY

LOTS 1,2,3,4 OF BLOCK 5
LAKE GENEVA TERRACE
SECTION 15, TOWN OF LINN
WALWORTH COUNTY, WISCONSIN

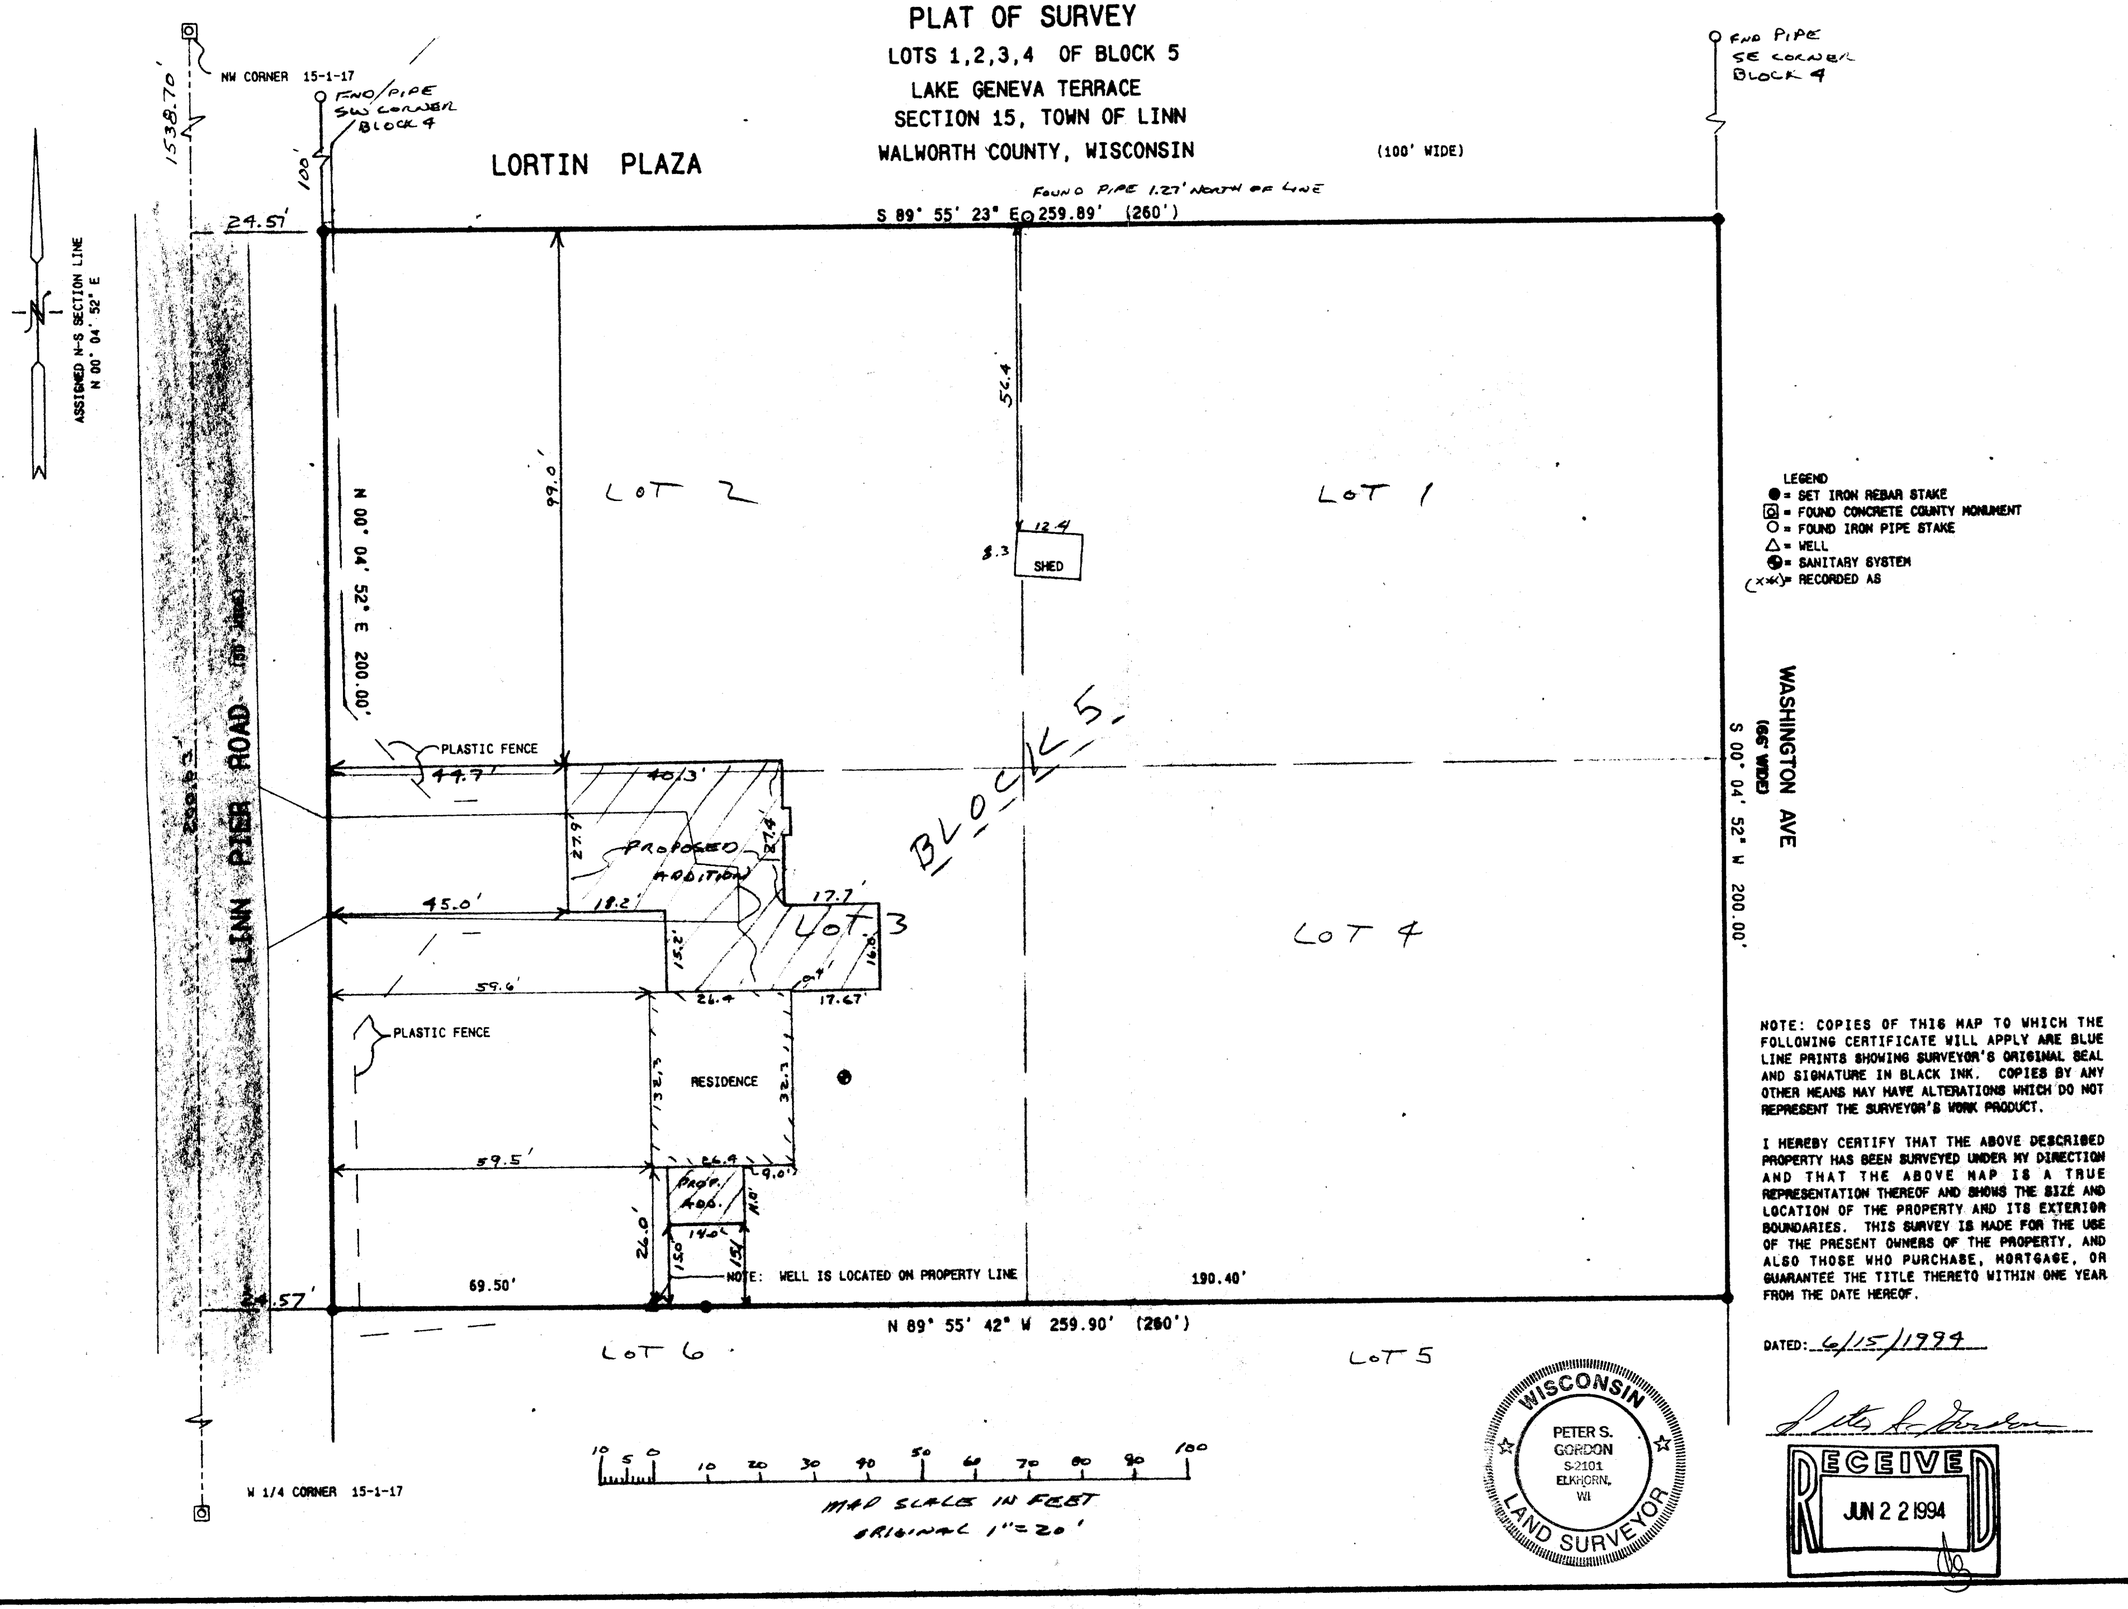

LEGEND
- ● = SET IRON REBAR STAKE
- ▣ = FOUND CONCRETE COUNTY MONUMENT
- ○ = FOUND IRON PIPE STAKE
- △ = WELL
- ⊕ = SANITARY SYSTEM
- (XX) = RECORDED AS

NOTE: COPIES OF THIS MAP TO WHICH THE FOLLOWING CERTIFICATE WILL APPLY ARE BLUE LINE PRINTS SHOWING SURVEYOR'S ORIGINAL SEAL AND SIGNATURE IN BLACK INK. COPIES BY ANY OTHER MEANS MAY HAVE ALTERATIONS WHICH DO NOT REPRESENT THE SURVEYOR'S WORK PRODUCT.

I HEREBY CERTIFY THAT THE ABOVE DESCRIBED PROPERTY HAS BEEN SURVEYED UNDER MY DIRECTION AND THAT THE ABOVE MAP IS A TRUE REPRESENTATION THEREOF AND SHOWS THE SIZE AND LOCATION OF THE PROPERTY AND ITS EXTERIOR BOUNDARIES. THIS SURVEY IS MADE FOR THE USE OF THE PRESENT OWNERS OF THE PROPERTY, AND ALSO THOSE WHO PURCHASE, MORTGAGE, OR GUARANTEE THE TITLE THERETO WITHIN ONE YEAR FROM THE DATE HEREOF.

DATED: 6/15/1994

PETER S. GORDON S-2101 ELKHORN, WI — WISCONSIN — LAND SURVEYOR

RECEIVED JUN 2 2 1994

WORK ORDERED BY:
MICHAEL PETERSON
1588 N. LINN ROAD
LAKE GENEVA, WISCONSIN

FARRIS, HANSEN & ASSOCIATES, INC.
Engineering, Architecture, Surveying
7 Ridgeway Court, P.O. Box 437
ELKHORN, WISCONSIN 53121
Office: (414) 723-2098
Fax: (414) 723-5866

REVISIONS

PROJECT NO. 4093
DATE 6/15/94
SHEET NO. 1 OF 1

117-1397

ILGT-19D