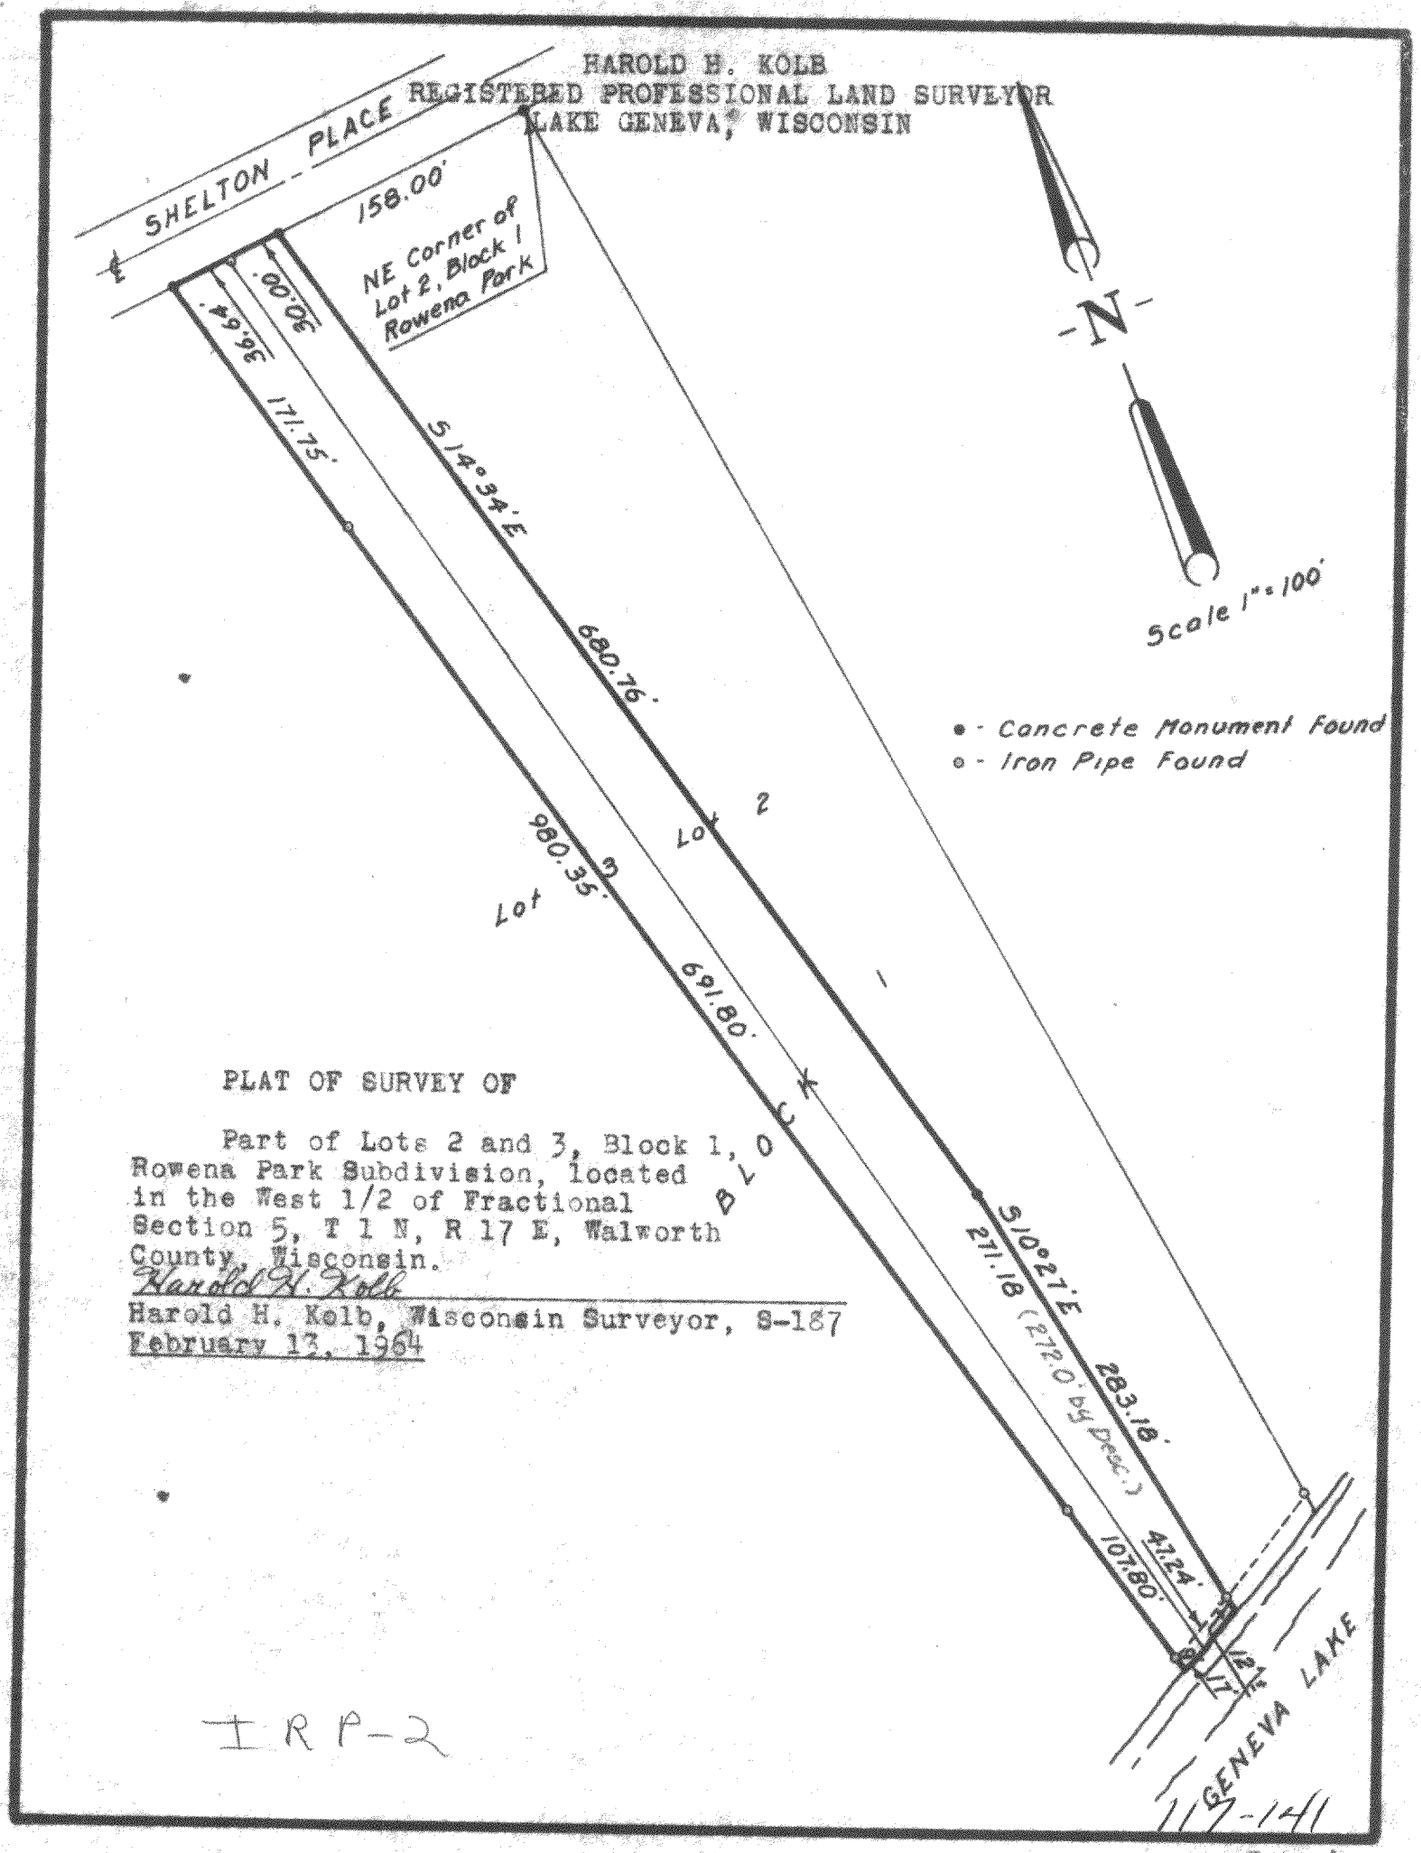


PLAT OF SURVEY OF

Part of Lots 2 and 3, Block 1, Rowena Park Subdivision, located in the West 1/2 of Fractional Section 5, T 1 N, R 17 E, Walworth County, Wisconsin.

Harold H. Kolb

Harold H. Kolb, Wisconsin Surveyor, S-187

February 13, 1964

I R P-2

119-141