
ABERNATHY and ASSOCIATES
Kenneth B. Abernathy Jr.
Wisconsin Registered Land Surveyor S-1594

W4056 Bray Road
Elkhorn, Wisconsin 53121
Phone (414) 723-4260 (office)
(414) 723-4813 (residence)

PLAT OF SURVEY

Lot 2 of Certified Survey Map Number 675, located in part of the Northeast 1/4 of Section 5, Town 1 North, Range 17 East, Town of Linn, Walworth County, Wisconsin.

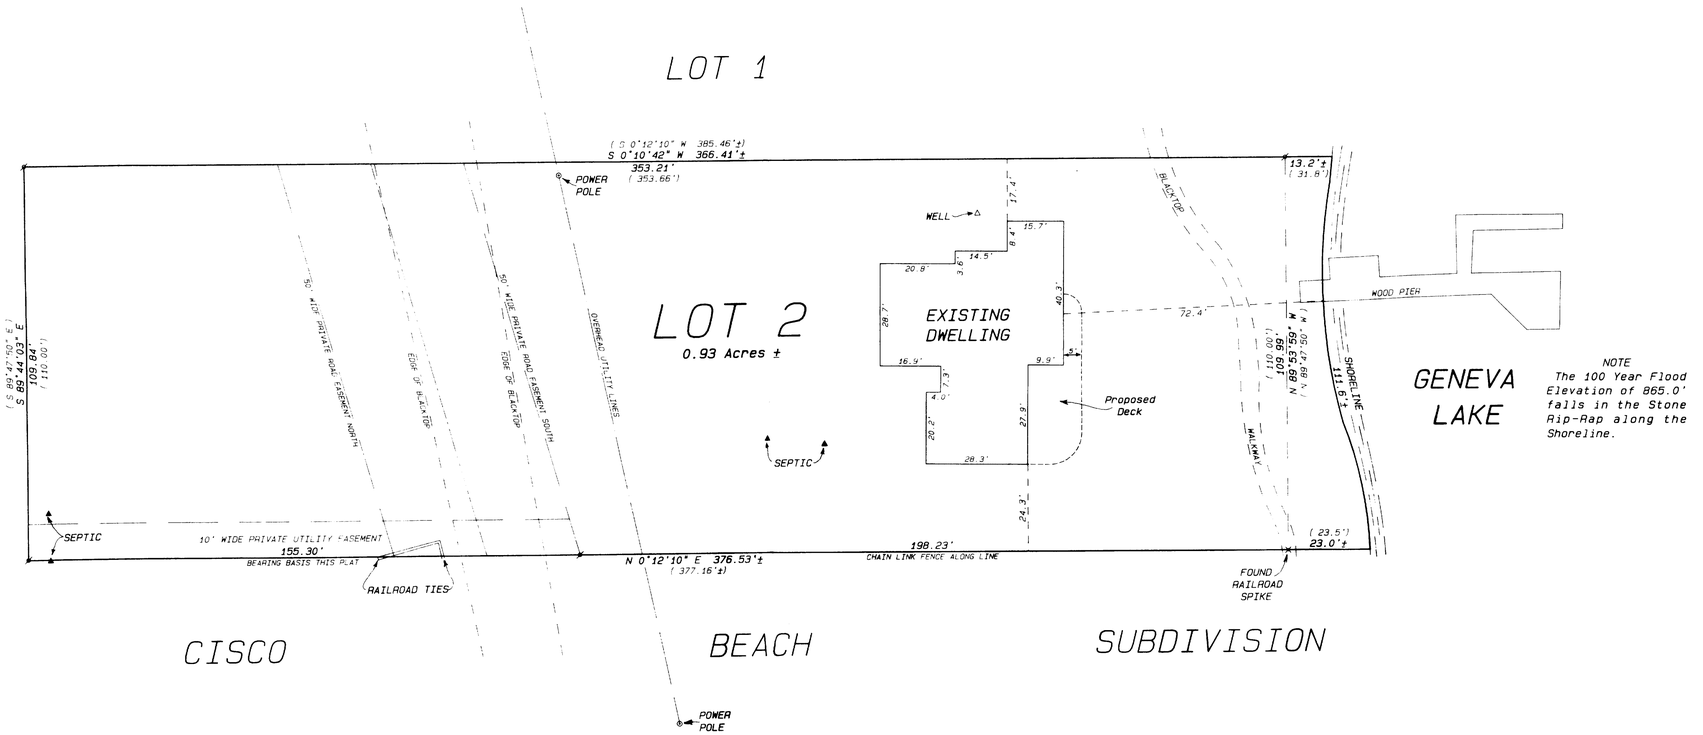

NOTE
The 100 Year Flood Elevation of 865.0' falls in the Stone Rip-Rap along the Shoreline.

Ordered by: Dale Castleman
B & J Tree & Landscape Service, Inc.
W3041 Kruger Road
Lake Geneva, Wisconsin 53546

Owners: Robert & Karol Karlblom
559 Westminster
Lake Forest, Illinois 60045

NOTE
Subject to easements recorded or unrecorded.

Legend

- FOUND IRON PIPE
- FOUND IRON ROD
- FOUND BRASS CAPPED MONUMENT
- FOUND CONCRETE MONUMENT
- CHISEL CUT IN CONCRETE
- SET IRON ROD 24" LONG, WEIGHING 1.5 LBS. LINEAL FT. 3/4" DIA.
- SET IRON ROD 30" LONG, WEIGHING 4.5 LBS. LINEAL FT. 1 1/4" DIA.
- (XXX) RECORDED AS DIMENSION
- EXISTING FENCE

WISCONSIN KENNETH B. ABERNATHY JR. S-1594 ELKHORN, WI LAND SURVEYOR

SCALE: 1" = 20 FEET

RECEIVED NOV 15 1994

I hereby certify that the above described property has been surveyed by me or under my direction and that the above map is a true representation thereof and shows the size and location of the property, its exterior boundaries, the location of all visible structures and dimensions of all principal buildings thereon, boundary fences, apparent easements, highways and visible encroachments, if any.
This survey is made for the use of the present owners of the property and also those who purchase, mortgage or guarantee the title thereto within one year from date hereof.

KENNETH B. ABERNATHY, JR.
WISCONSIN REGISTERED LAND SURVEYOR,
S-1594
Revised November 2, 1994
Date: October 17, 1994 Job No. 1994.922

117-1414