
ABELL
SURVEYING & MAPPING
DELAVAN, WISCONSIN 53115
414-728-6737

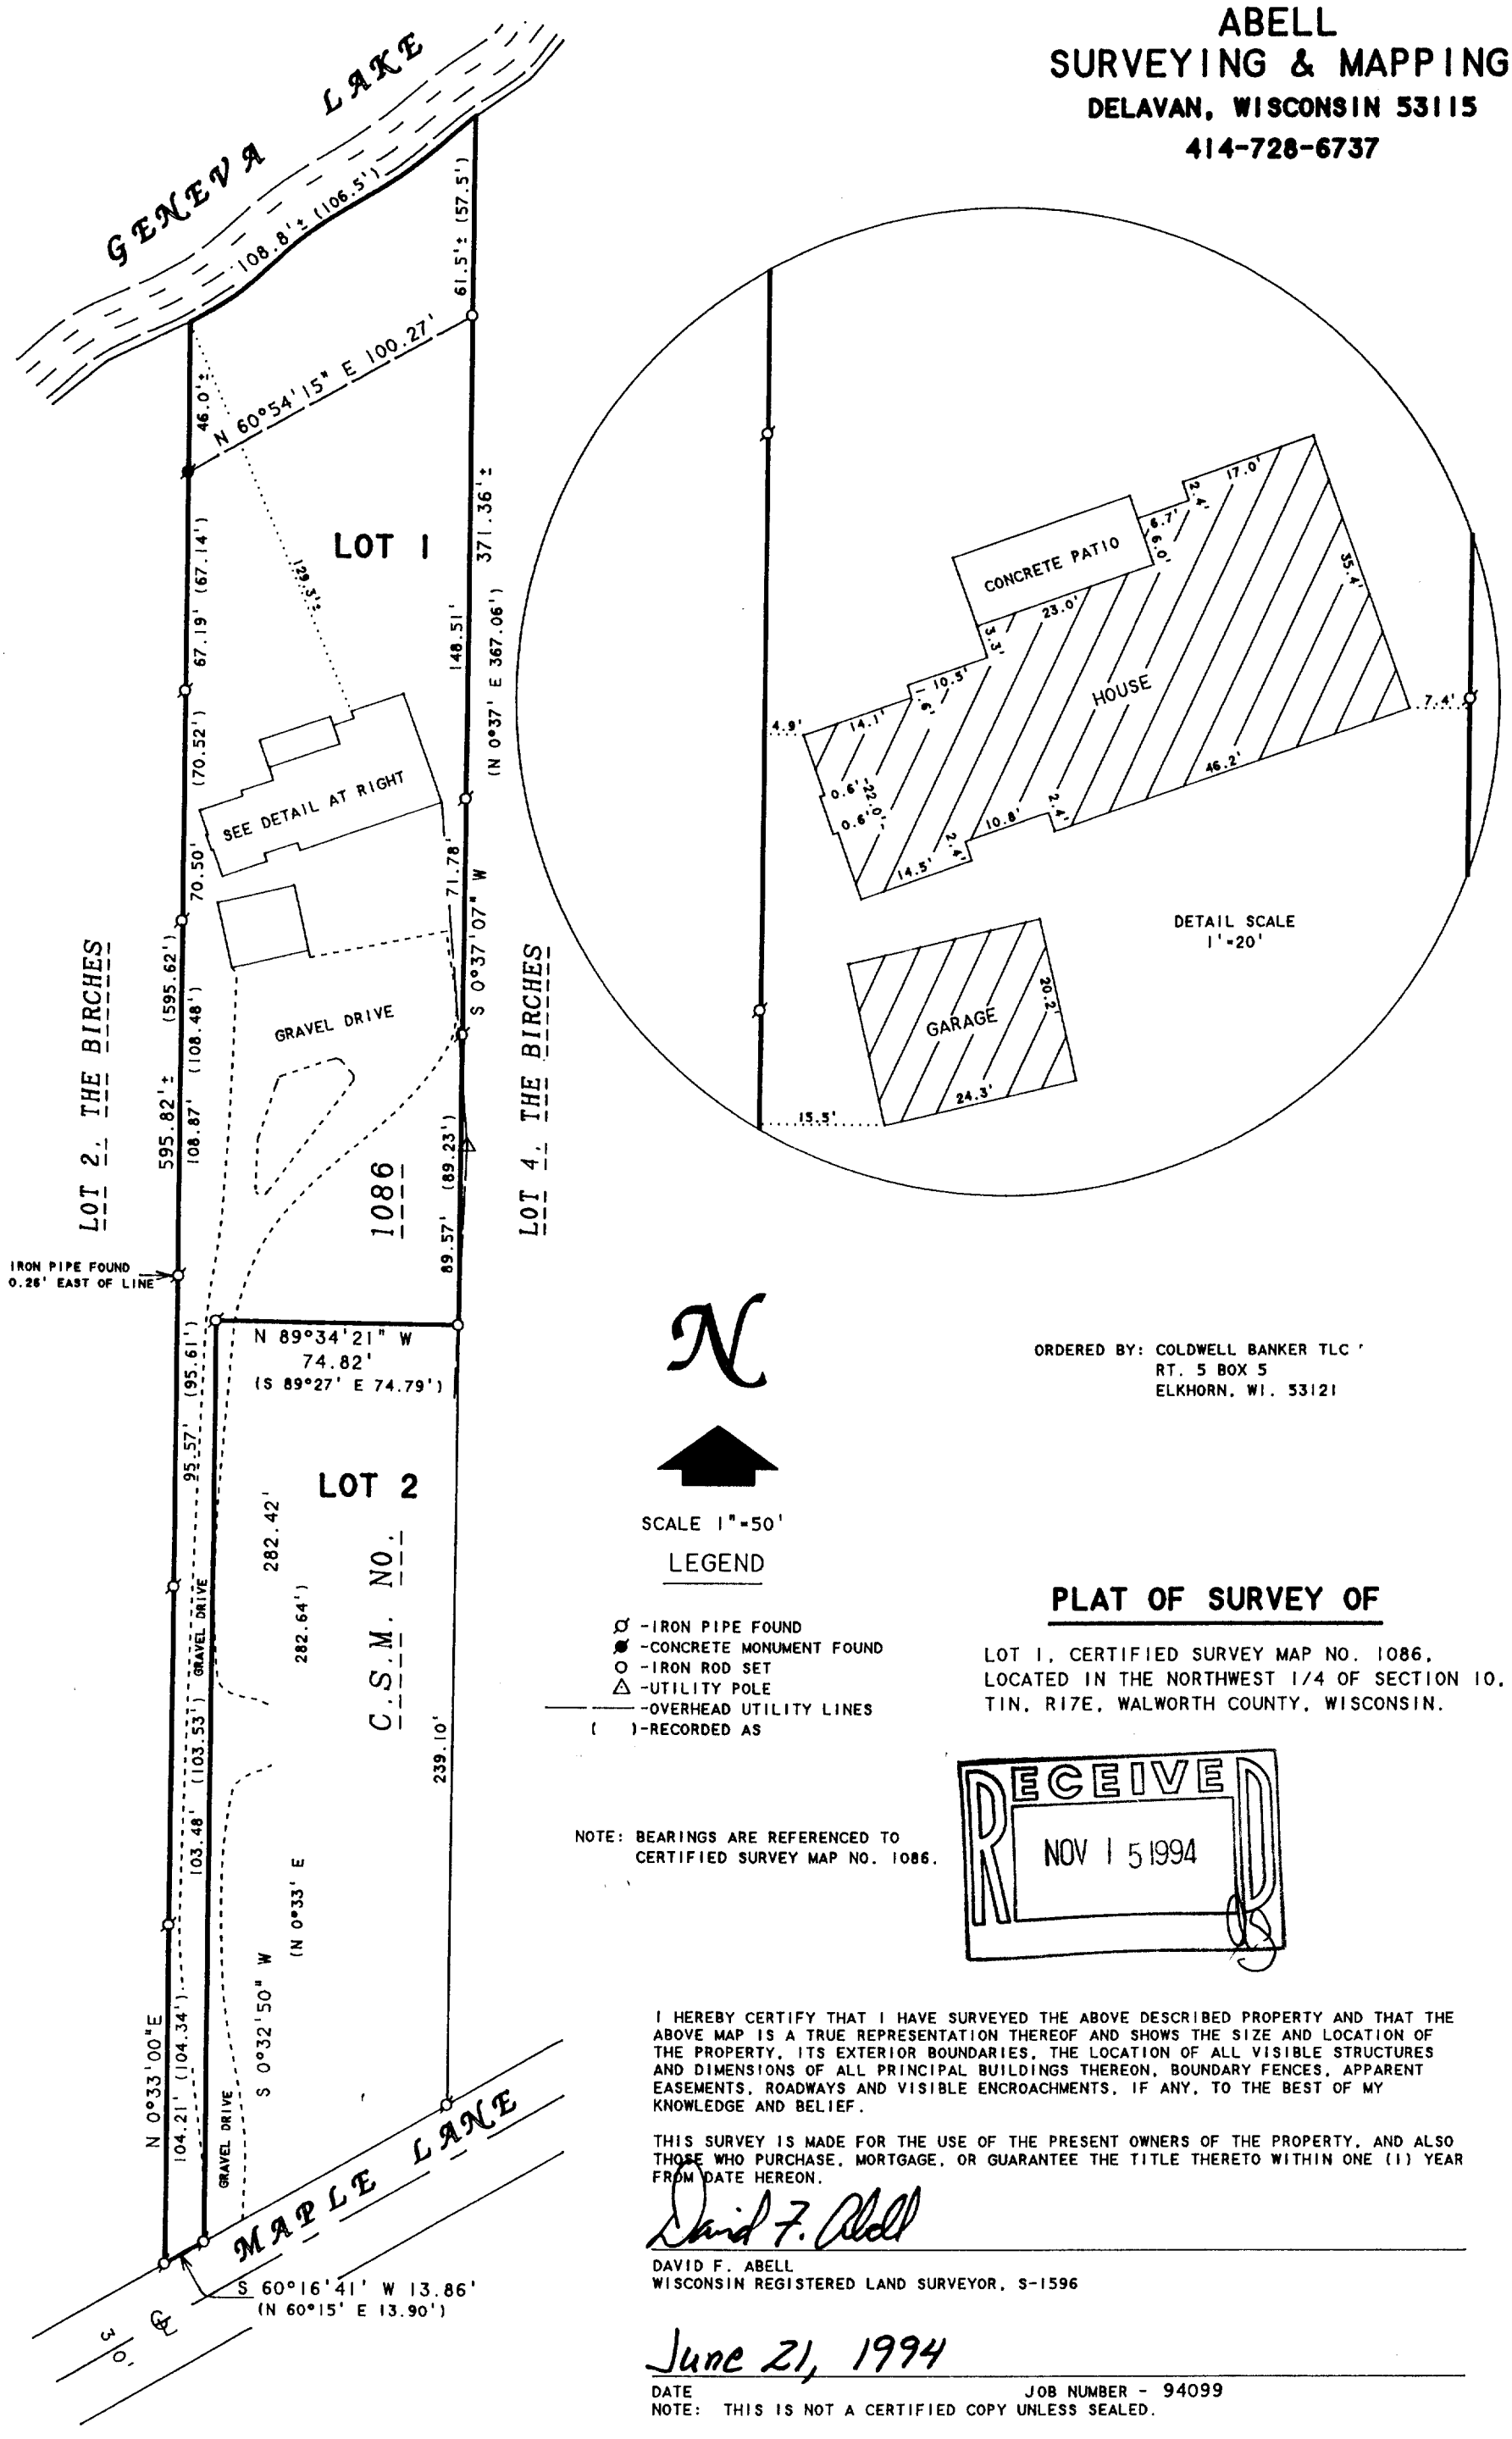

N

SCALE 1"=50'

LEGEND

- ⌀ -IRON PIPE FOUND
- ⌀ -CONCRETE MONUMENT FOUND
- ○ -IRON ROD SET
- △ -UTILITY POLE
- ——— -OVERHEAD UTILITY LINES
- ( )-RECORDED AS

NOTE: BEARINGS ARE REFERENCED TO CERTIFIED SURVEY MAP NO. 1086.

ORDERED BY: COLDWELL BANKER TLC
RT. 5 BOX 5
ELKHORN, WI. 53121

PLAT OF SURVEY OF

LOT 1, CERTIFIED SURVEY MAP NO. 1086, LOCATED IN THE NORTHWEST 1/4 OF SECTION 10, T1N, R17E, WALWORTH COUNTY, WISCONSIN.

RECEIVED
NOV 1 5 1994

I HEREBY CERTIFY THAT I HAVE SURVEYED THE ABOVE DESCRIBED PROPERTY AND THAT THE ABOVE MAP IS A TRUE REPRESENTATION THEREOF AND SHOWS THE SIZE AND LOCATION OF THE PROPERTY, ITS EXTERIOR BOUNDARIES, THE LOCATION OF ALL VISIBLE STRUCTURES AND DIMENSIONS OF ALL PRINCIPAL BUILDINGS THEREON, BOUNDARY FENCES, APPARENT EASEMENTS, ROADWAYS AND VISIBLE ENCROACHMENTS, IF ANY, TO THE BEST OF MY KNOWLEDGE AND BELIEF.

THIS SURVEY IS MADE FOR THE USE OF THE PRESENT OWNERS OF THE PROPERTY, AND ALSO THOSE WHO PURCHASE, MORTGAGE, OR GUARANTEE THE TITLE THERETO WITHIN ONE (1) YEAR FROM DATE HEREON.

David F. Abell

DAVID F. ABELL
WISCONSIN REGISTERED LAND SURVEYOR, S-1596

June 21, 1994

DATE JOB NUMBER - 94099

NOTE: THIS IS NOT A CERTIFIED COPY UNLESS SEALED.

IA-1086-1

117-1428