
KOLB LAND CONSULTING, INC.

LAND SURVEYING · SUBDIVIDING · LAND PLANNING

929 WILLIAMS STREET LAKE GENEVA, WISCONSIN 53147 414-248-3697

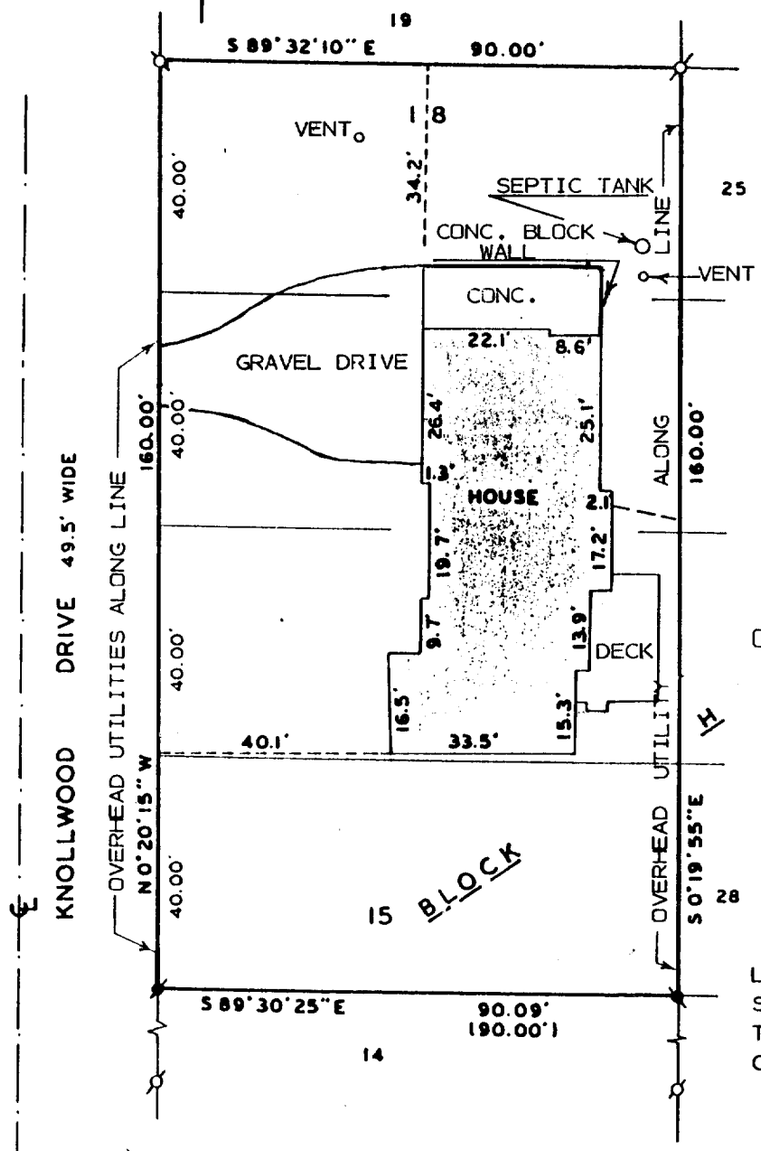

SCALE: 1" = 30'

LEGEND

- ⌀ – IRON ROD FOUND
- ⌀ – IRON PIPE FOUND
- ● – IRON ROD SET
- ( )– AS RECORDED
- ——— OVERHEAD UTILITY LINE

ORDERED BY: CENTURY 21
50 W. GENEVA STREET
WILLIAMS BAY, WI.53191

PLAT OF SURVEY OF

LOTS 15-18, BLOCK H OF CISCO BEACH SUBDIVISION LOCATED IN SECTION 5, T1N, R17E, TOWN OF LINN, WALWORTH COUNTY, WISCONSIN.

RECEIVED
MAY 12 1995

I HEREBY CERTIFY THAT I HAVE SURVEYED THE ABOVE DESCRIBED PROPERTY AND THAT THE ABOVE MAP IS A TRUE REPRESENTATION THEREOF AND SHOWS THE SIZE AND LOCATION OF THE PROPERTY, ITS EXTERIOR BOUNDARIES, THE LOCATION OF ALL VISIBLE STRUCTURES AND DIMENSIONS OF ALL PRINCIPAL BUILDINGS THEREON, BOUNDARY FENCES, APPARENT EASEMENTS, ROADWAYS AND VISIBLE ENCROACHMENTS, IF ANY, TO THE BEST OF MY KNOWLEDGE AND BELIEF.
THIS SURVEY IS MADE FOR THE USE OF THE PRESENT OWNERS OF THE PROPERTY AND ALSO THOSE WHO PURCHASE, MORTGAGE OR GUARANTEE THE TITLE THERETO WITHIN ONE (1) YEAR FROM DATE HEREOF.
SURVEY NOT VALID UNLESS SURVEYOR'S SIGNATURE IS IN RED.

HAROLD H. KOLB

WISCONSIN REGISTERED LAND SURVEYOR, S-187

DATE JANUARY 12, 1995

REVISED

REVISED

IC1-173

1-17-376 117-1482