
KOLB LAND CONSULTING, INC.

LAND SURVEYING · SUBDIVIDING · LAND PLANNING

929 WILLIAMS STREET LAKE GENEVA, WISCONSIN 53147 414-248-3697

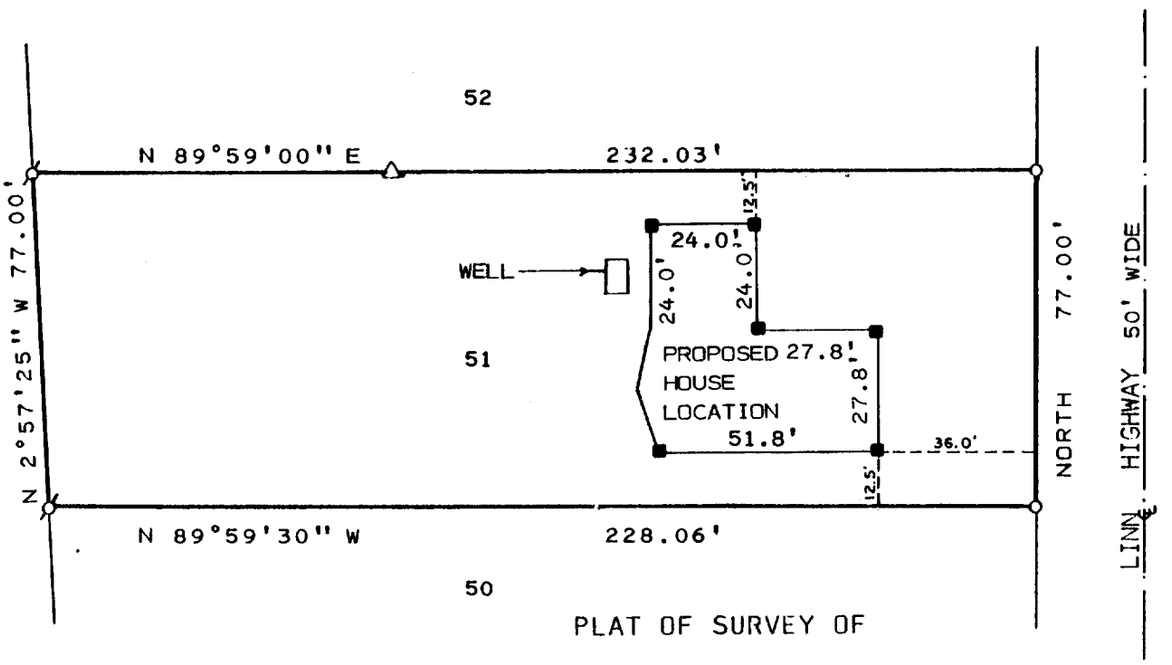


PLAT OF SURVEY OF

LOT 51 OF THE BIRCHES 1ST ADDITION, A SUBDIVISION LOCATED IN T1N, R17E, TOWN OF LINN, WALWORTH COUNTY, WISCONSIN.

NOTE: BEARINGS ARE ASSUMED AS SHOWN ON RECORDED SUBDIVISION PLAT.

ORDERED BY: MICHAELE SCURLOCK % 5-STAR HOMES
P.O. BOX 127
90 E. GENEVA SQUARE
LAKE GENEVA, WI. 53147

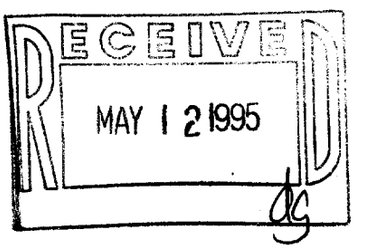

SCALE: 1" = 40'

LEGEND

- ø – IRON PIPE FOUND
- o – IRON PIPE SET
- Δ – UTILITY POLE
- ——— – OVERHEAD UTILITY LINES
- D – DECK
- ■ – SET WOOD STAKE

I, HAROLD H. KOLB, DO HEREBY CERTIFY THAT I HAVE SURVEYED THE PROPERTY HEREON DESCRIBED ACCORDING TO THE OFFICIAL RECORDS AND THAT THE PLAT HEREON IS A CORRECT REPRESENTATION OF THE LOT LINES TO THE BEST OF MY KNOWLEDGE AND BELIEF.
SURVEY NOT VALID UNLESS SURVEYOR'S SIGNATURE IS IN RED.

HAROLD H. KOLB
WISCONSIN REGISTERED LAND SURVEYOR, S-187
DATE AUGUST 8, 1994
REVISED SEPTEMBER 5, 1994
REVISED NOVEMBER 4, 1994
1-17-421


IBA1-36

117-1483

KOLB LAND CONSULTING, INC.

LAND SURVEYING · SUBDIVIDING · LAND PLANNING

929 WILLIAMS STREET LAKE GENEVA, WISCONSIN 53147 414-248-3697

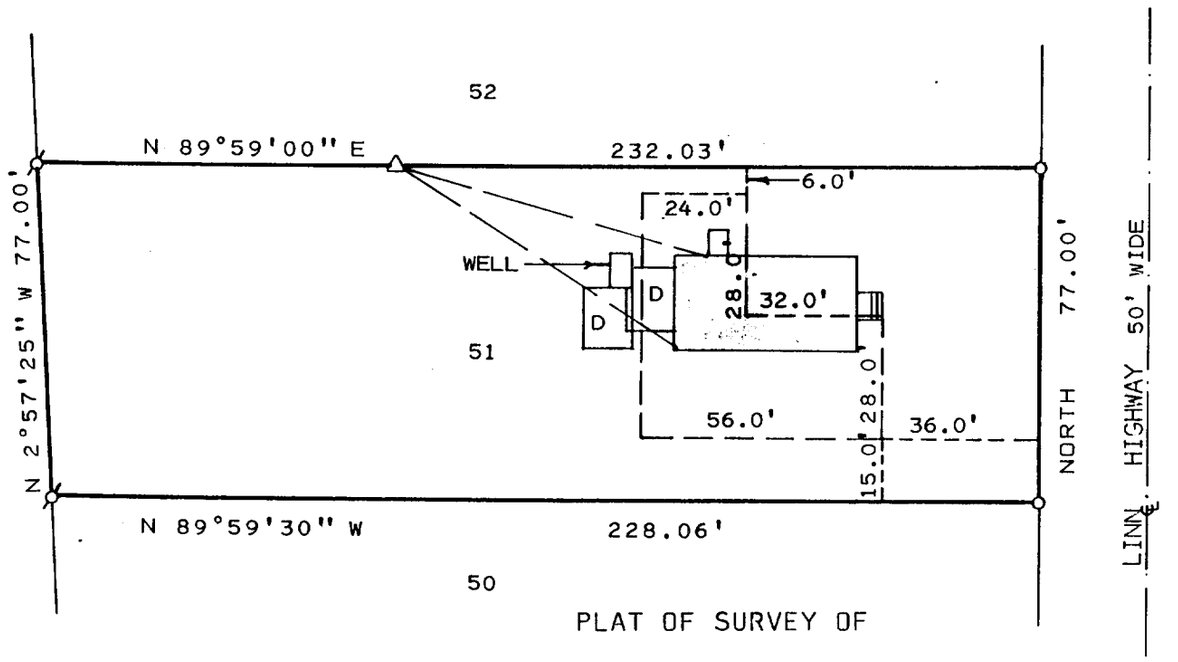


PLAT OF SURVEY OF

LOT 51 OF THE BIRCHES 1ST ADDITION, A SUBDIVISION LOCATED IN T1N, R17E, TOWN OF LINN, WALWORTH COUNTY, WISCONSIN.

NOTE: BEARINGS ARE ASSUMED AS SHOWN ON RECORDED SUBDIVISION PLAT.

ORDERED BY: MICHAELE SCURLOCK % 5-STAR HOMES
P.O. BOX 127
90 E. GENEVA SQUARE
LAKE GENEVA, WI. 53147

NOTE: DASHED LINES REPRESENT PROPOSED HOUSE LOCATION.
NOTE: SOLID LINES REPRESENT EXISTING HOUSE LOCATION.

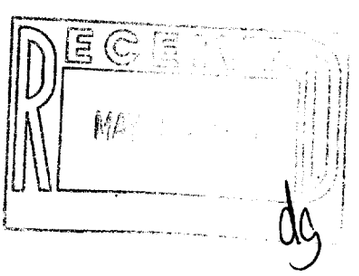



SCALE: 1" = 40'

LEGEND

- ø - IRON PIPE FOUND
- o - IRON PIPE SET
- Δ - UTILITY POLE
- ——— - OVERHEAD UTILITY LINES
- D - DECK

I, HAROLD H. KOLB, DO HEREBY CERTIFY THAT I HAVE SURVEYED THE PROPERTY HEREON DESCRIBED ACCORDING TO THE OFFICIAL RECORDS AND THAT THE PLAT HEREON IS A CORRECT REPRESENTATION OF THE LOT LINES TO THE BEST OF MY KNOWLEDGE AND BELIEF.
SURVEY NOT VALID UNLESS SURVEYOR'S SIGNATURE IS IN RED.

HAROLD H. KOLB
WISCONSIN REGISTERED LAND SURVEYOR, S-187
DATE AUGUST 8, 1994
REVISED
REVISED

1-17-421

IBA1-36

117-1483