
KOLB LAND CONSULTING, INC.

LAND SURVEYING · SUBDIVIDING · LAND PLANNING

929 WILLIAMS STREET LAKE GENEVA, WISCONSIN 53147 414-248-3697

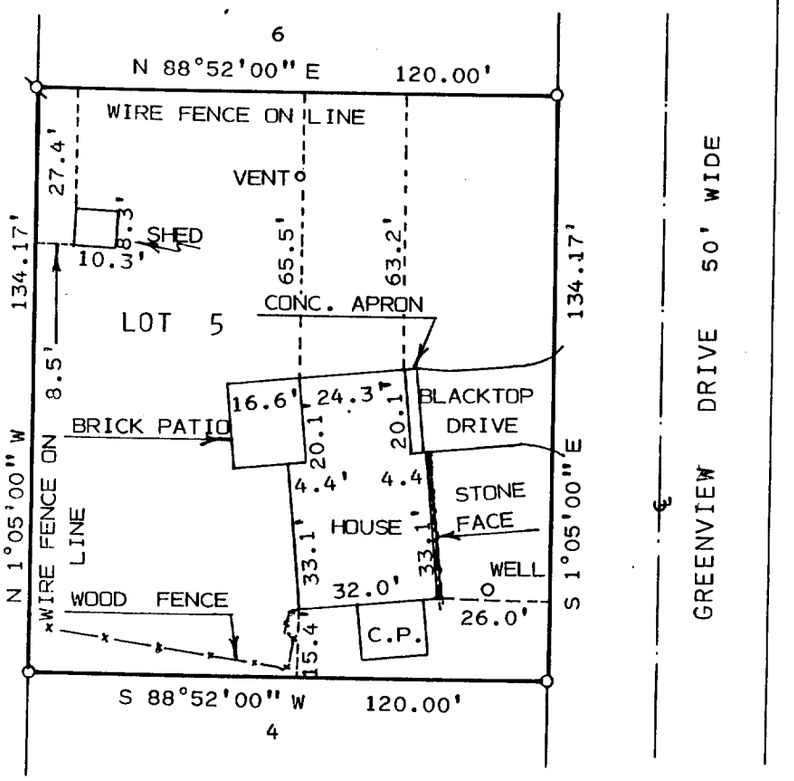


PLAT OF SURVEY OF

LOT 5 OF SUNSET HILLS SHORES SUBDIVISION, LOCATED IN T1N, R17E, TOWN OF LINN, WALWORTH COUNTY, WISCONSIN.

ORDERED BY: ED HEICHEL
1300 NATIONAL AVE.
ADDISON, IL. 60101

NOTE: BEARINGS ARE ASSUMED AS SHOWN ON SUBDIVISION PLAT.

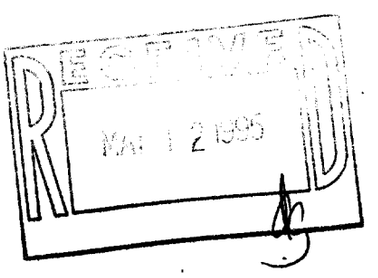

SCALE: 1" = 40'

LEGEND

ø - IRON PIPE FOUND

o - IRON PIPE SET

C.P.- CONCRETE PATIO

I, HAROLD H. KOLB, DO HEREBY CERTIFY THAT I HAVE SURVEYED THE PROPERTY HEREON DESCRIBED ACCORDING TO THE OFFICIAL RECORDS AND THAT THE PLAT HEREON IS A CORRECT REPRESENTATION OF THE LOT LINES AND THE PRINCIPAL LINES OF THE BUILDINGS, TO THE BEST OF MY KNOWLEDGE AND BELIEF.
SURVEY NOT VALID UNLESS SURVEYOR'S SIGNATURE IS IN RED.

HAROLD H. KOLB

WISCONSIN REGISTERED LAND SURVEYOR, S-137

DATE DECEMBER 6, 1994

REVISED _____

REVISED _____

ISHS-5

1-17/156

117-1486