
#146-66

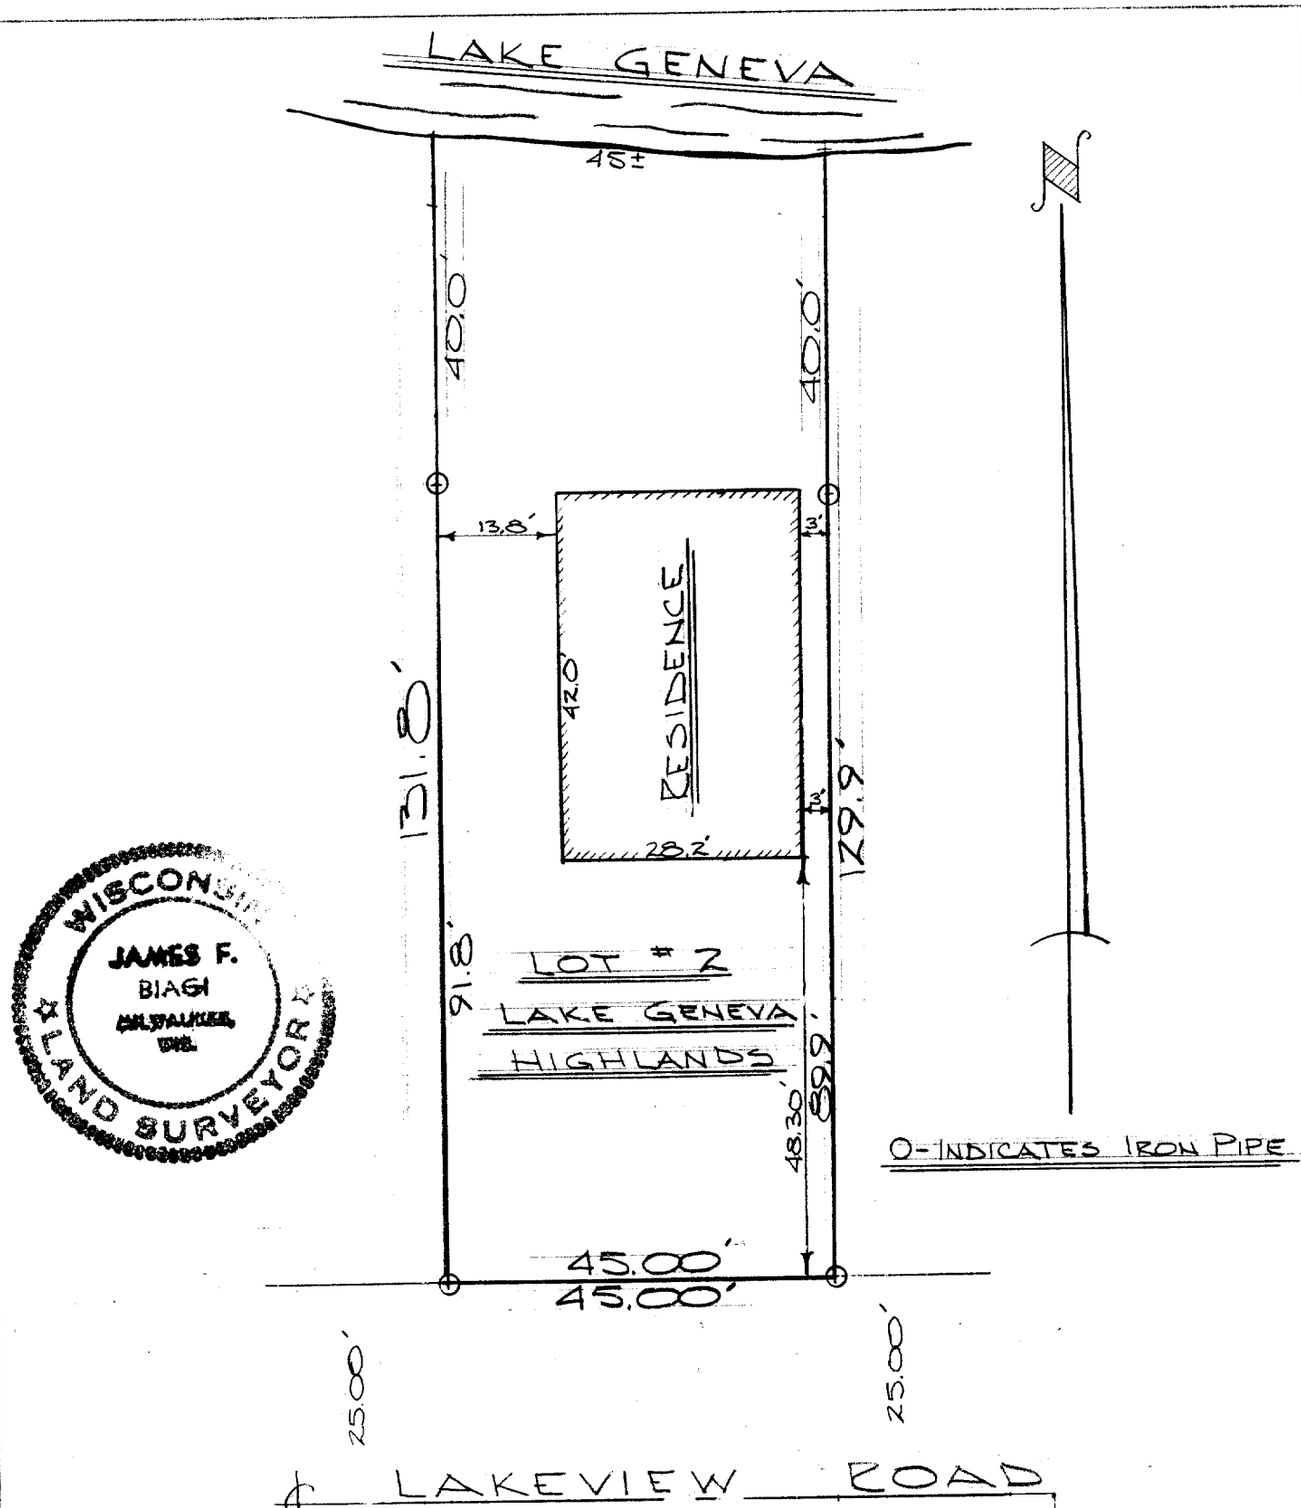


DESCRIPTION: Lot 2 of Lake Geneva Highlands Subdivision located in Section 8, T. 1 N., R. 17 E. Walworth County, Wisconsin.

CERTIFICATE: I, James F. Biagi, surveyor, do hereby certify that I have surveyed the property hereon described and that the location of the improvements are as shown.
Sept. 8, 1966.

James F. Biagi RLS 272

117-14 B

ILGH-2