
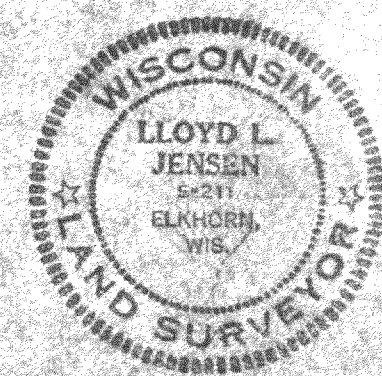


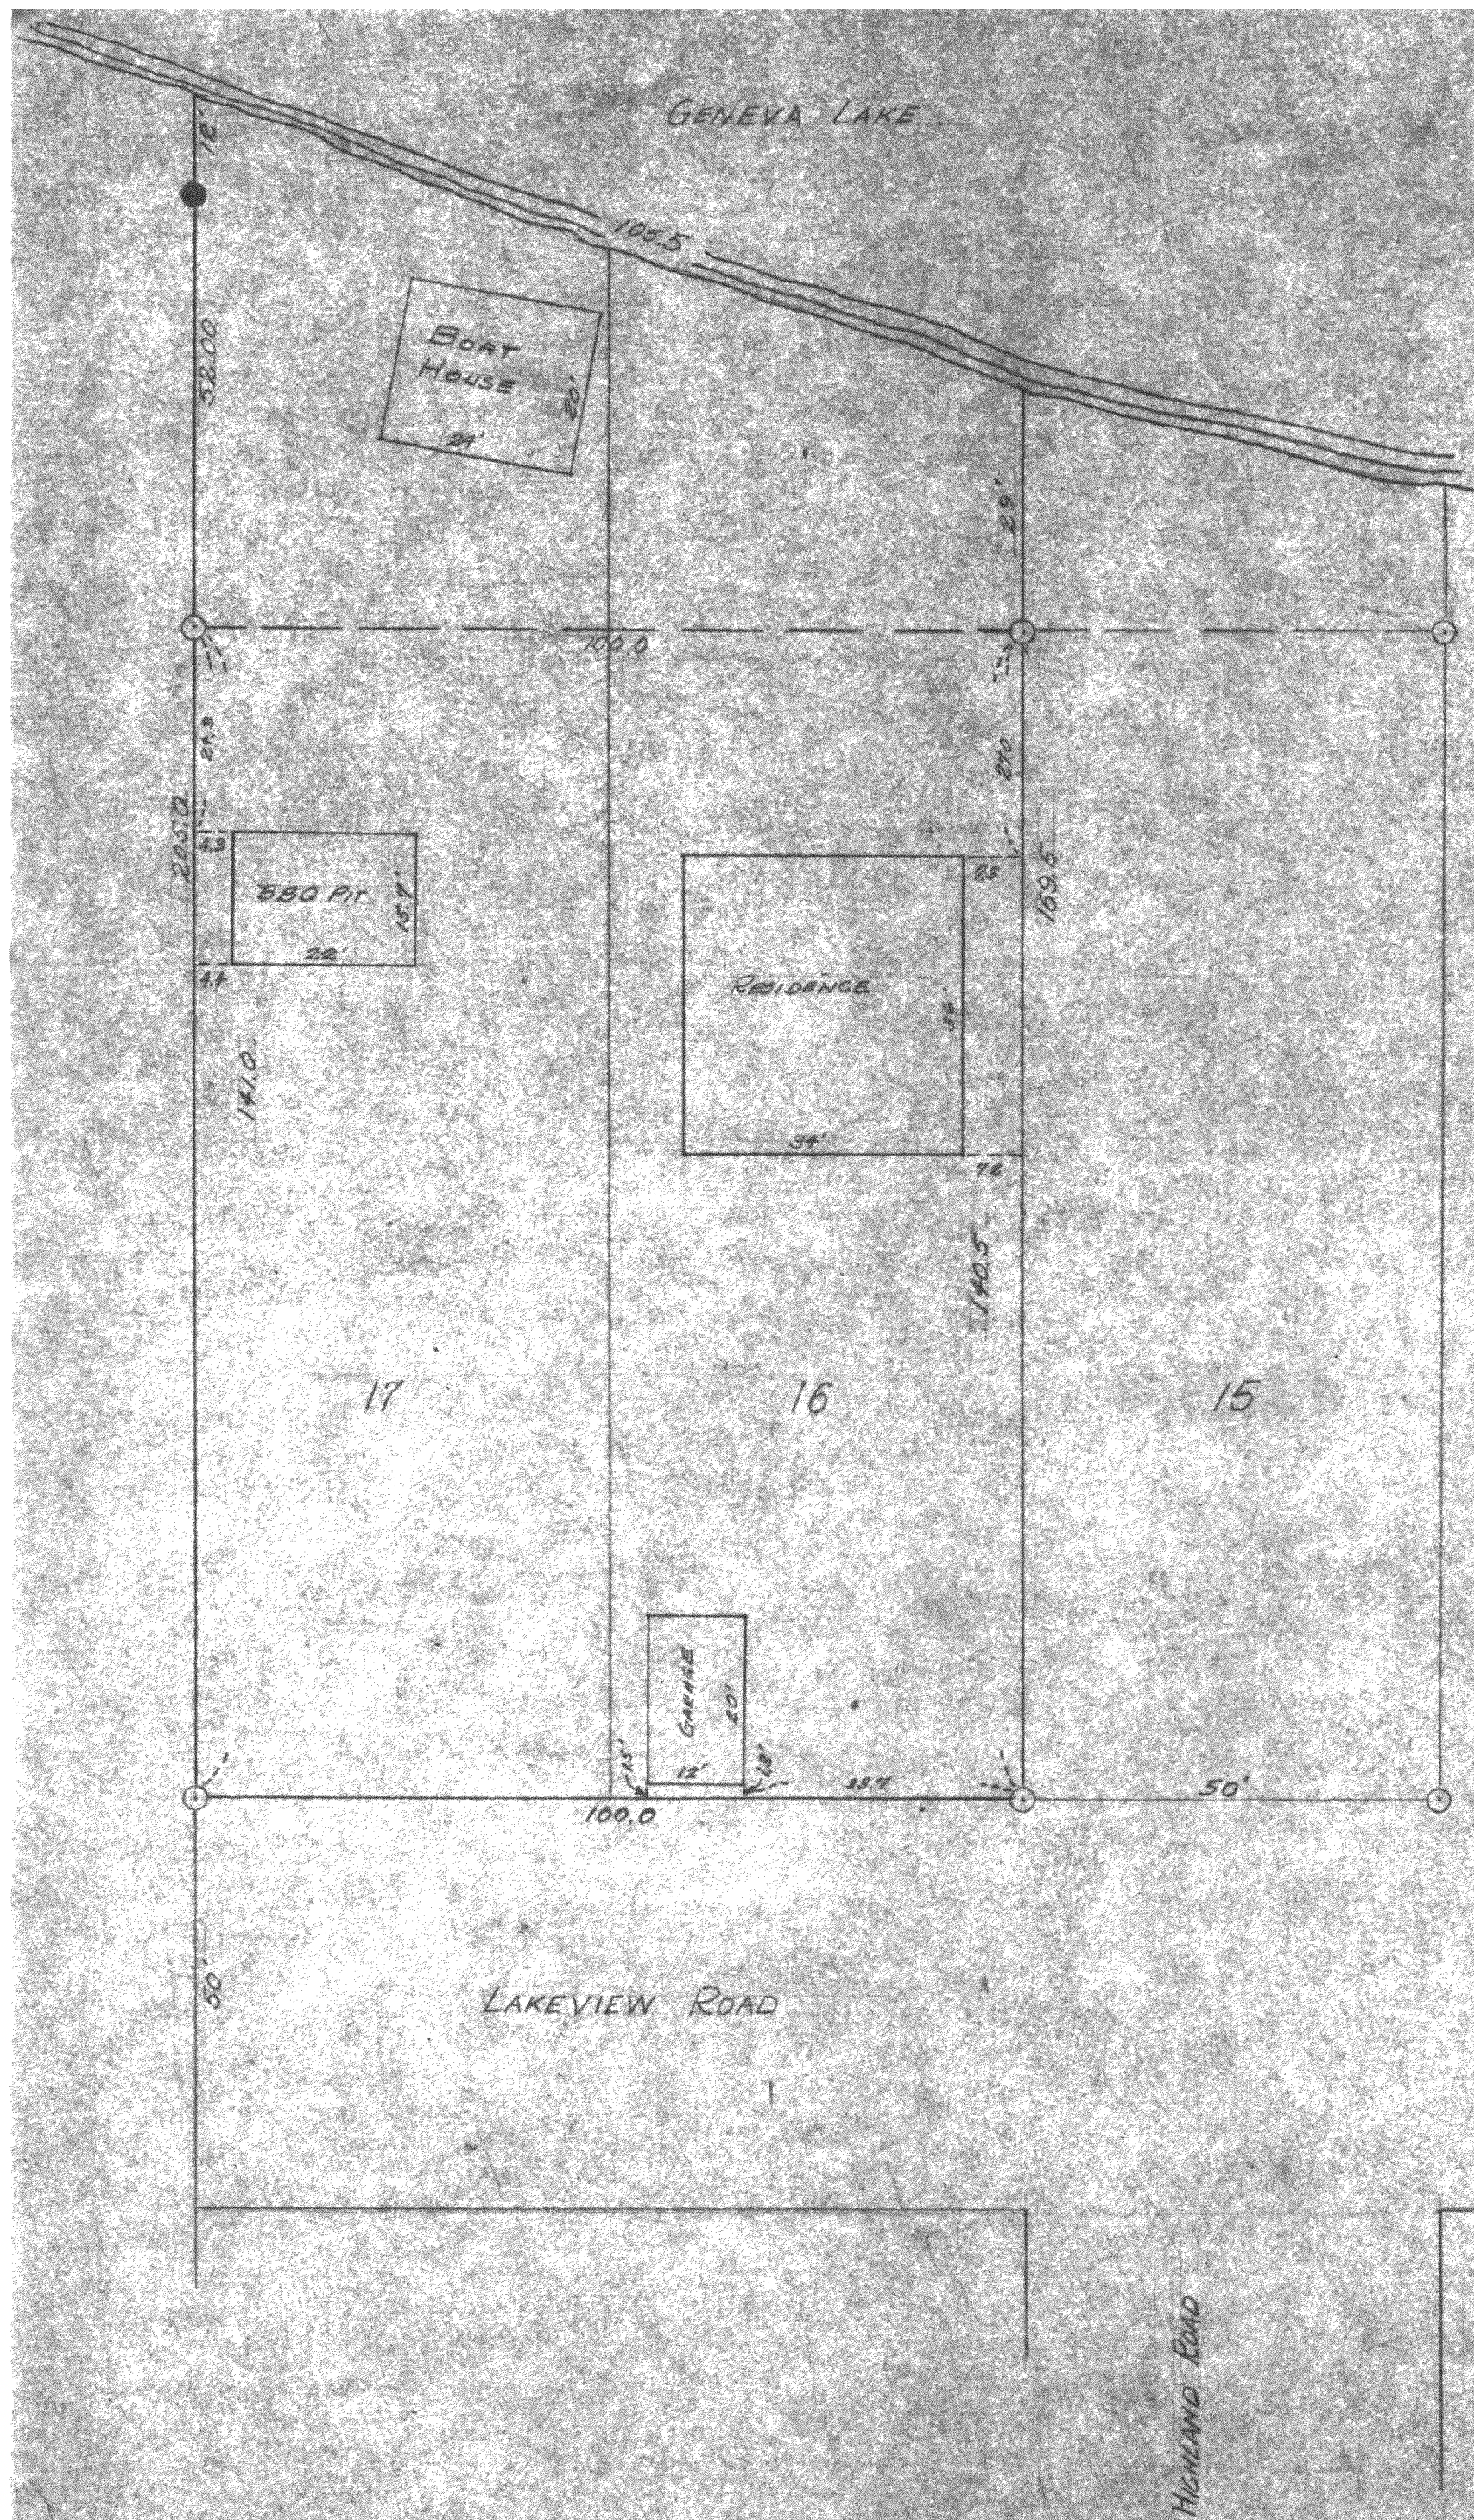

PLAT OF SURVEY
 OF
 LOTS 16 AND 17
 OF
 LAKE GENEVA HIGHLANDS
 LOCATED IN
 T1N R17E WALWORTH COUNTY, WISCONSIN

Lloyd L. Jensen
 SURVEYOR

SCALE 1" = 20'

DATE AUGUST 1956

TLGH-16
 11 16A

117-150.1