
HAROLD H. KOLB

REGISTERED PROFESSIONAL LAND SURVEYOR
LAKE GENEVA, WISCONSIN

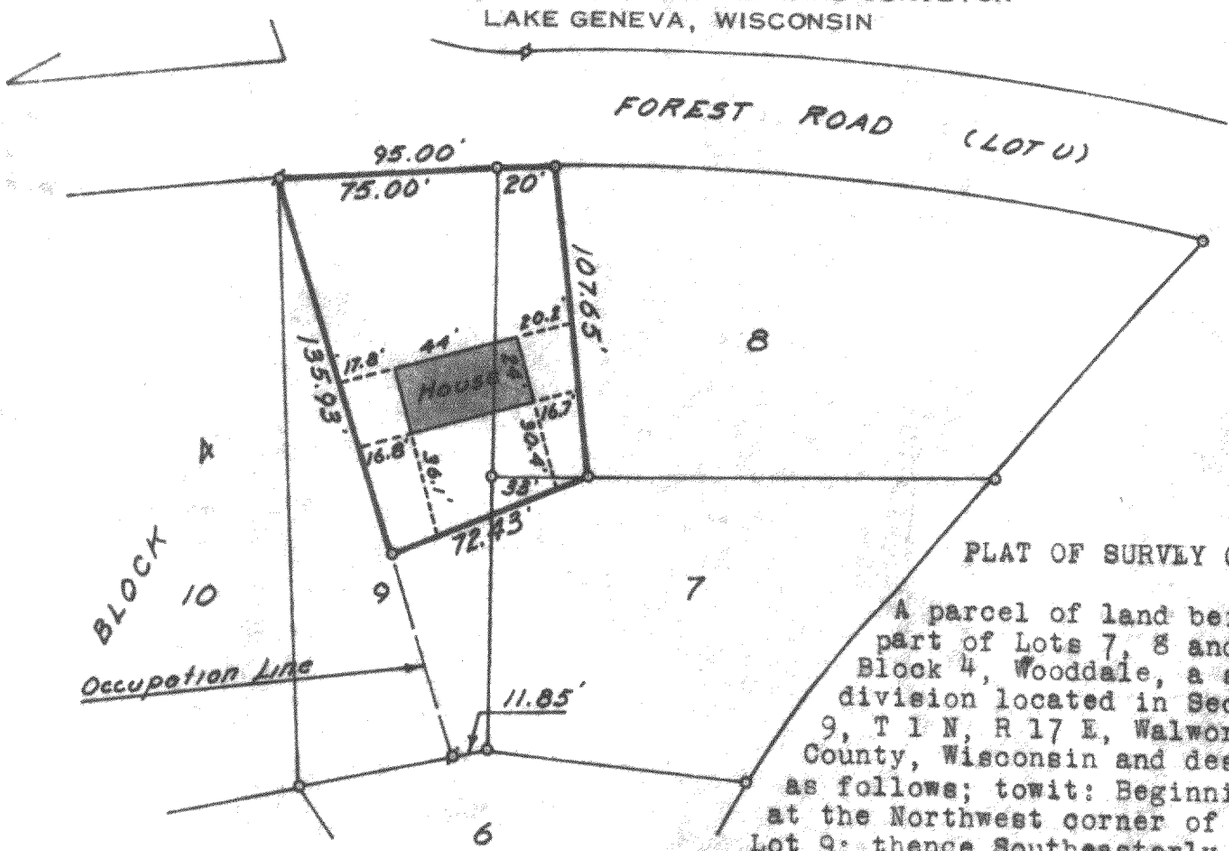

PLAT OF SURVEY OF

A parcel of land being part of Lots 7, 8 and 9, Block 4, Wooddale, a subdivision located in Section 9, T 1 N, R 17 E, Walworth County, Wisconsin and described as follows; towit: Beginning at the Northwest corner of said Lot 9; thence Southeasterly 135.93 feet along a line from the Northwest corner of said Lot 9 to a point 11.85 feet West of the Southeast corner of said Lot 9; thence Northeasterly 72.43 feet to a point on the North line of said Lot 7, 33 feet East of the Northwest corner of said Lot 7; thence Northerly 107.65 feet to a point on the North line of said Lot 8, 20.00 feet East of the Northwest corner of said Lot 8; thence Westerly 20.00 feet to the Northwest corner of said Lot 8; thence continue Westerly 75.00 feet to the Northwest corner of said Lot 9 and the place of beginning.

N

SCALE: 1"=60'

LEGEND

- ⊄ — IRON PIPE FOUND
- ○ — IRON PIPE PLACED
- ● — CONCRETE MONUMENT
- x — SPIKE

I, HAROLD H. KOLB, DO HEREBY CERTIFY THAT I HAVE SURVEYED THE PROPERTY HEREON DESCRIBED ACCORDING TO THE OFFICIAL RECORDS, AND THAT THE PLAT HEREON IS A CORRECT REPRESENTATION OF THE LOT LINES.

Harold H. Kolb
HAROLD H. KOLB
WISCONSIN REGISTERED LAND SURVEYOR, S—187
DATE March 25, 1965

IW-46A

117-157