
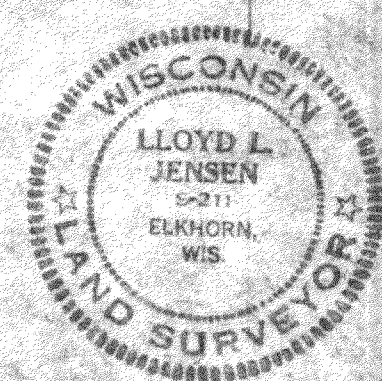



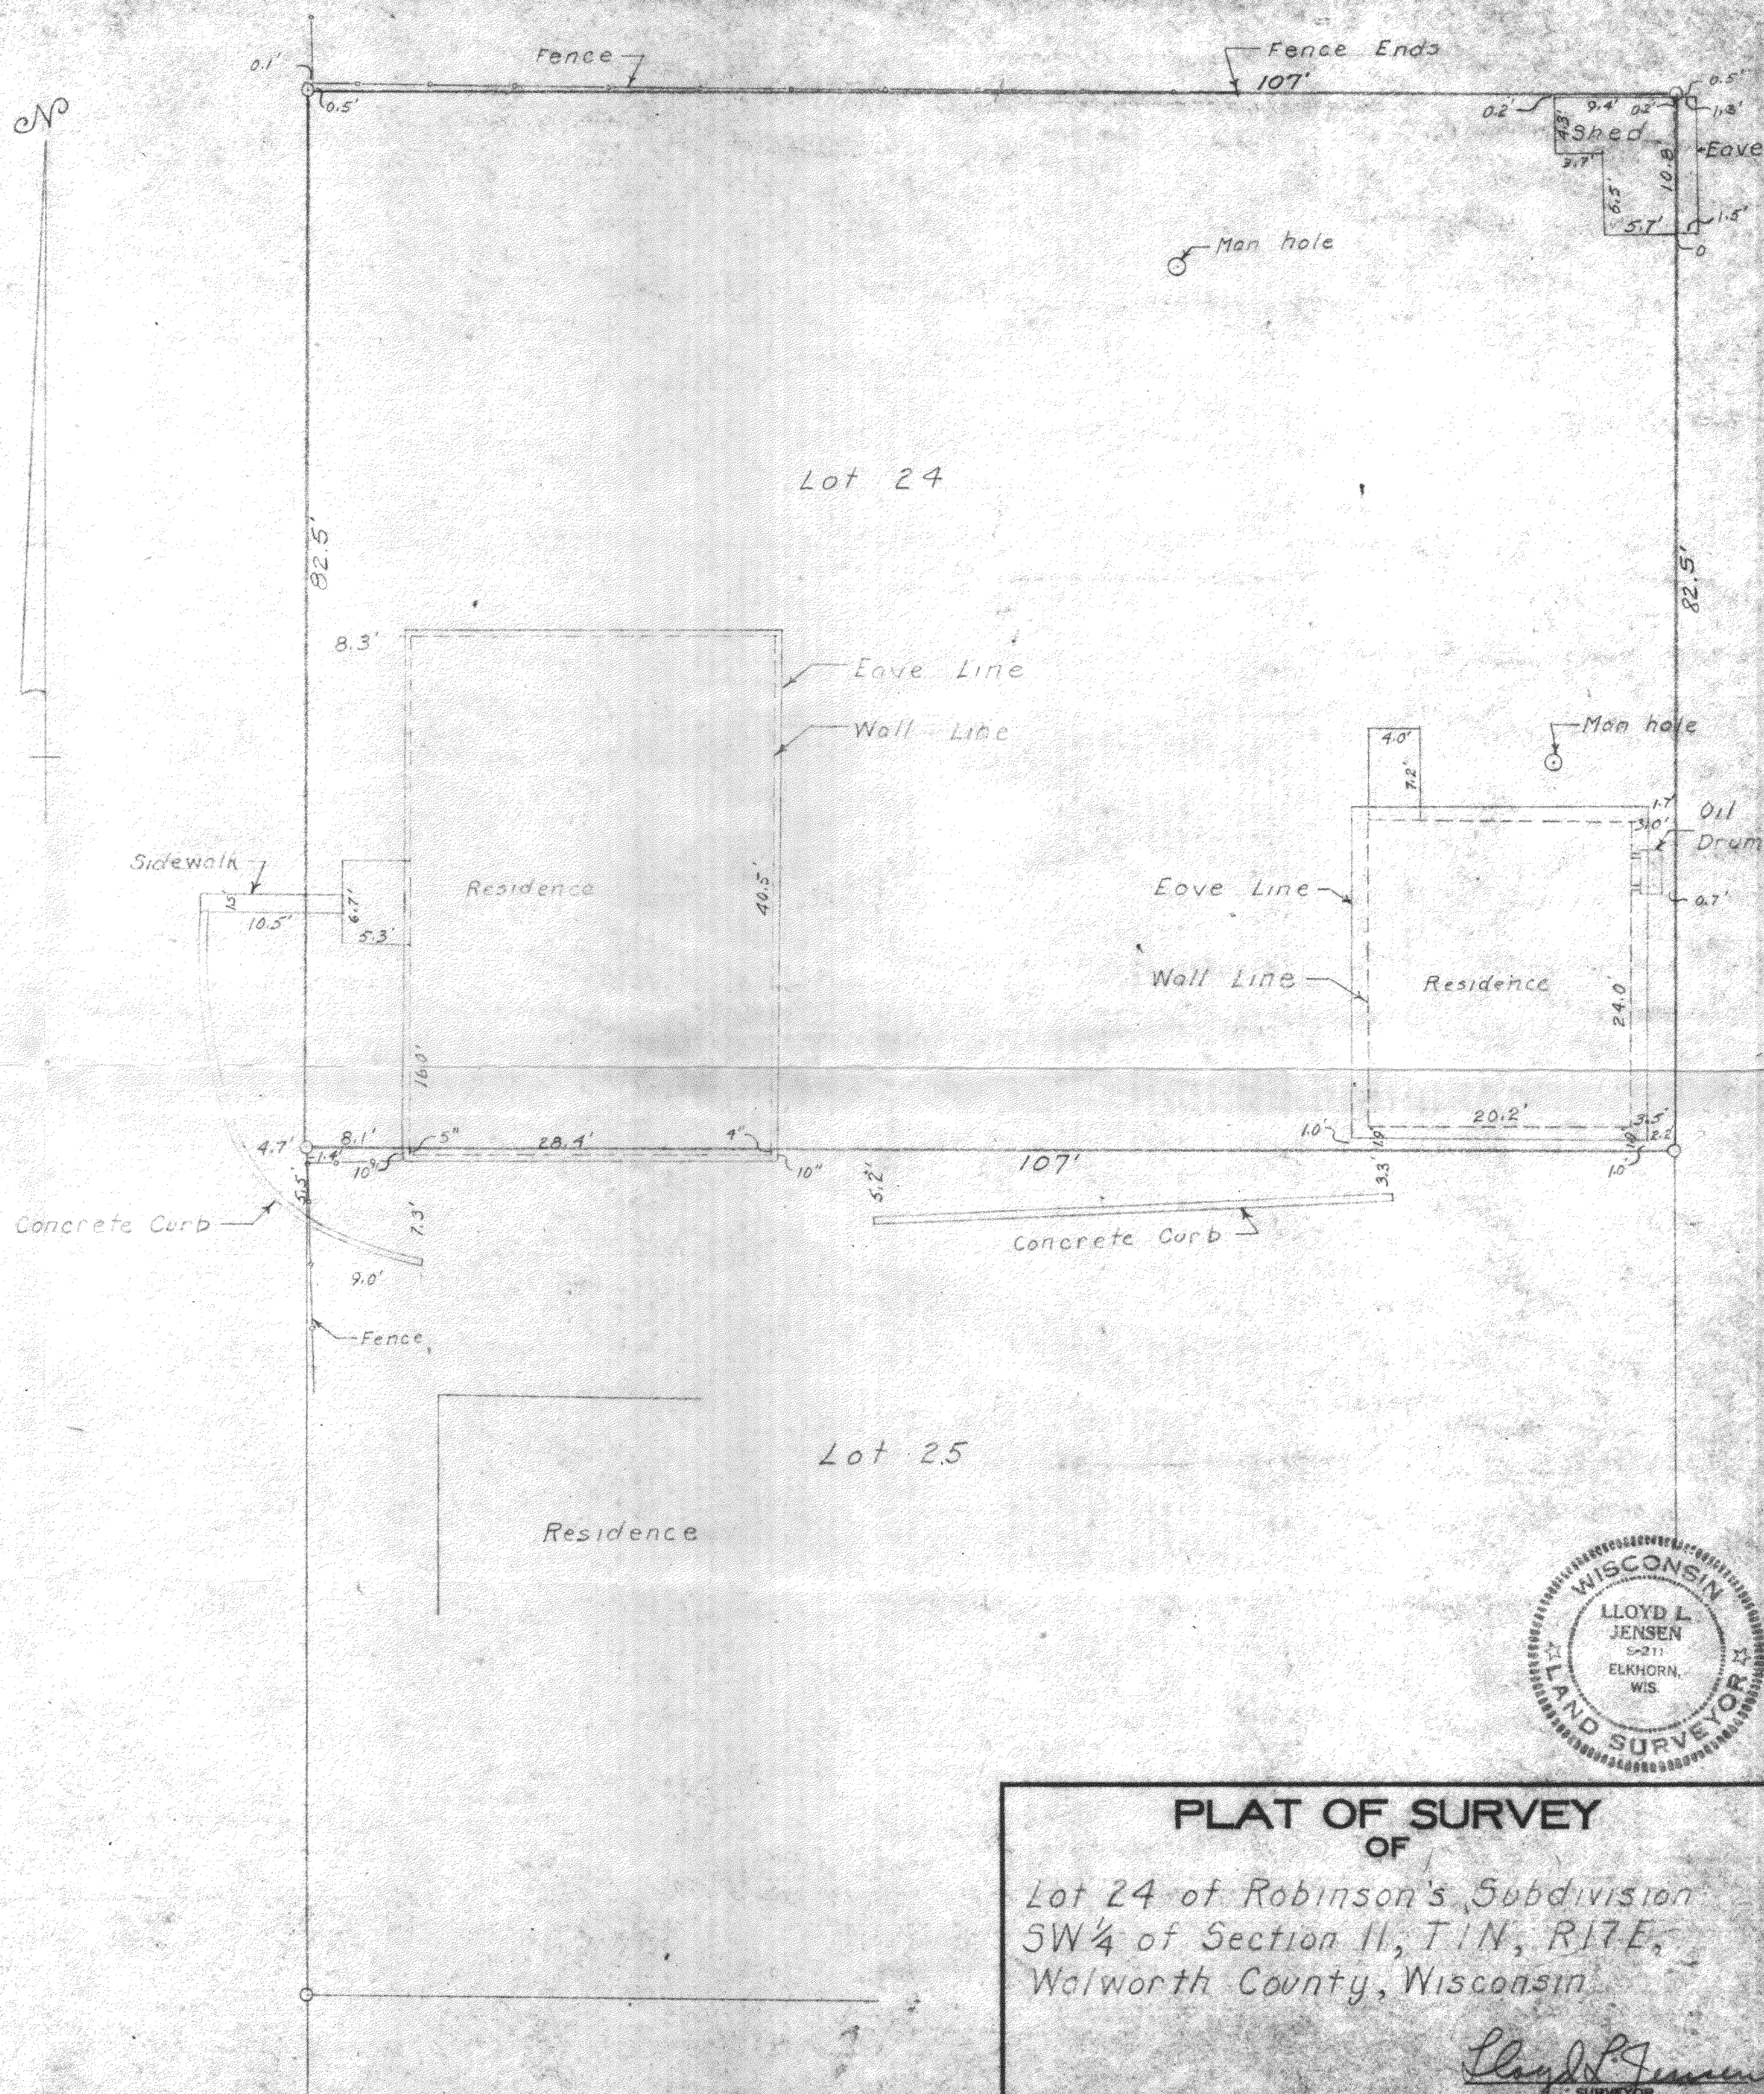

PLAT OF SURVEY
OF

Lot 24 of Robinson's Subdivision
SW 1/4 of Section 11, T1N, R17E,
Walworth County, Wisconsin

Lloyd L. Jensen
SURVEYOR

SCALE 1" = 10'

DATE July 2, 1967

IRBI-19

117-159.1