
WALWORTH COUNTY
SURVEYING & MAPPING
P. O. BOX 1115
LAKE GENEVA, WISCONSIN
414-248-0505

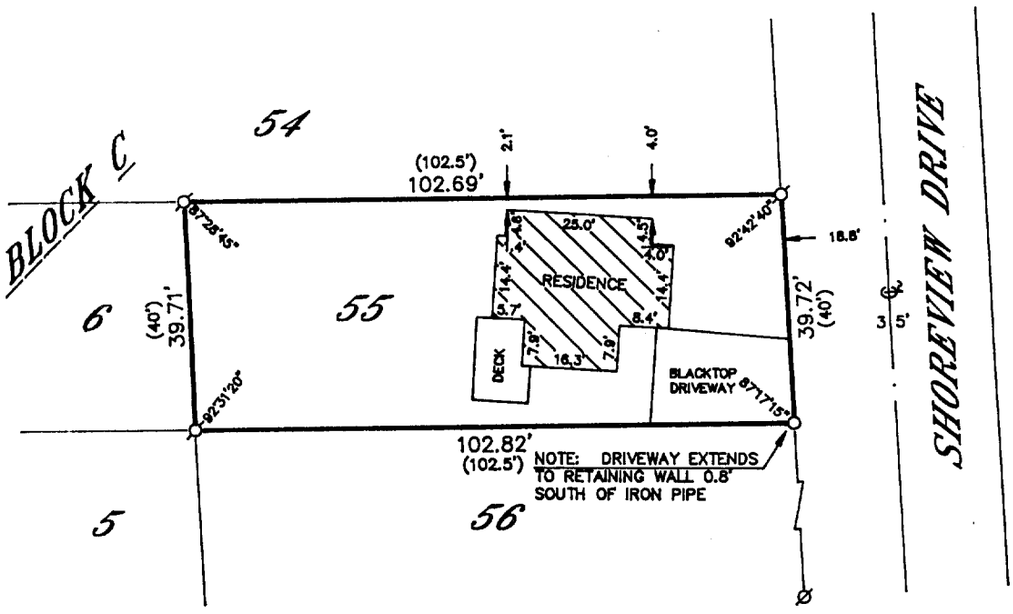

PLAT OF SURVEY OF

LOT 55 OF BLOCK "C" OF CISCO BEACH SUBDIVISION, BEING PART OF THE WEST 1/2 OF THE NORTHEAST 1/4 OF SECTION 5 AND LOT 1 OF THE ROWENA PARK SUBDIVISION, TOWNSHIP 1 NORTH, RANGE 17 EAST OF THE 4TH P.M., WALWORTH COUNTY, WISCONSIN.

ORDERED BY: CENTURY 21 ASSURED REALTY
P. O. BOX 367
WILLIAMS BAY, WISCONSIN
53191

RECEIVED
APR 18 1997



SCALE IN FEET

0 30 60

LEGEND

- ⊙—IRON PIPE FOUND
- ⌀—IRON ROD FOUND
- ■—CONCRETE MONUMENT FOUND
- O—IRON PIPE PLACED
- ()—RECORDED AS

I HEREBY CERTIFY THAT I HAVE SURVEYED THE ABOVE DESCRIBED PROPERTY AND THAT THE ABOVE MAP IS A TRUE REPRESENTATION THEREOF AND SHOWS THE SIZE AND LOCATION OF THE PROPERTY, ITS EXTERIOR BOUNDARIES, THE LOCATION OF ALL VISIBLE STRUCTURES AND DIMENSIONS OF ALL PRINCIPAL BUILDINGS THEREON, BOUNDARY FENCES, APPARENT EASEMENTS, ROADWAYS AND VISIBLE ENCROACHMENTS, IF ANY, TO THE BEST OF MY KNOWLEDGE AND BELIEF.

THIS SURVEY IS MADE FOR THE USE OF THE PRESENT OWNERS OF THE PROPERTY AND ALSO THOSE WHO PURCHASE, MORTGAGE OR GUARANTEE THE TITLE THERETO WITHIN ONE (1) YEAR FROM DATE HEREOF.

Robert M. Baerenwald

ROBERT M. BAERENWALD
WISCONSIN REGISTERED LAND SURVEYOR, S-1508

April 14, 1997
DATE

JOB NO. 4629

NOTE: THIS IS NOT A CERTIFIED COPY UNLESS SEALED.

IC1-70

117-1601