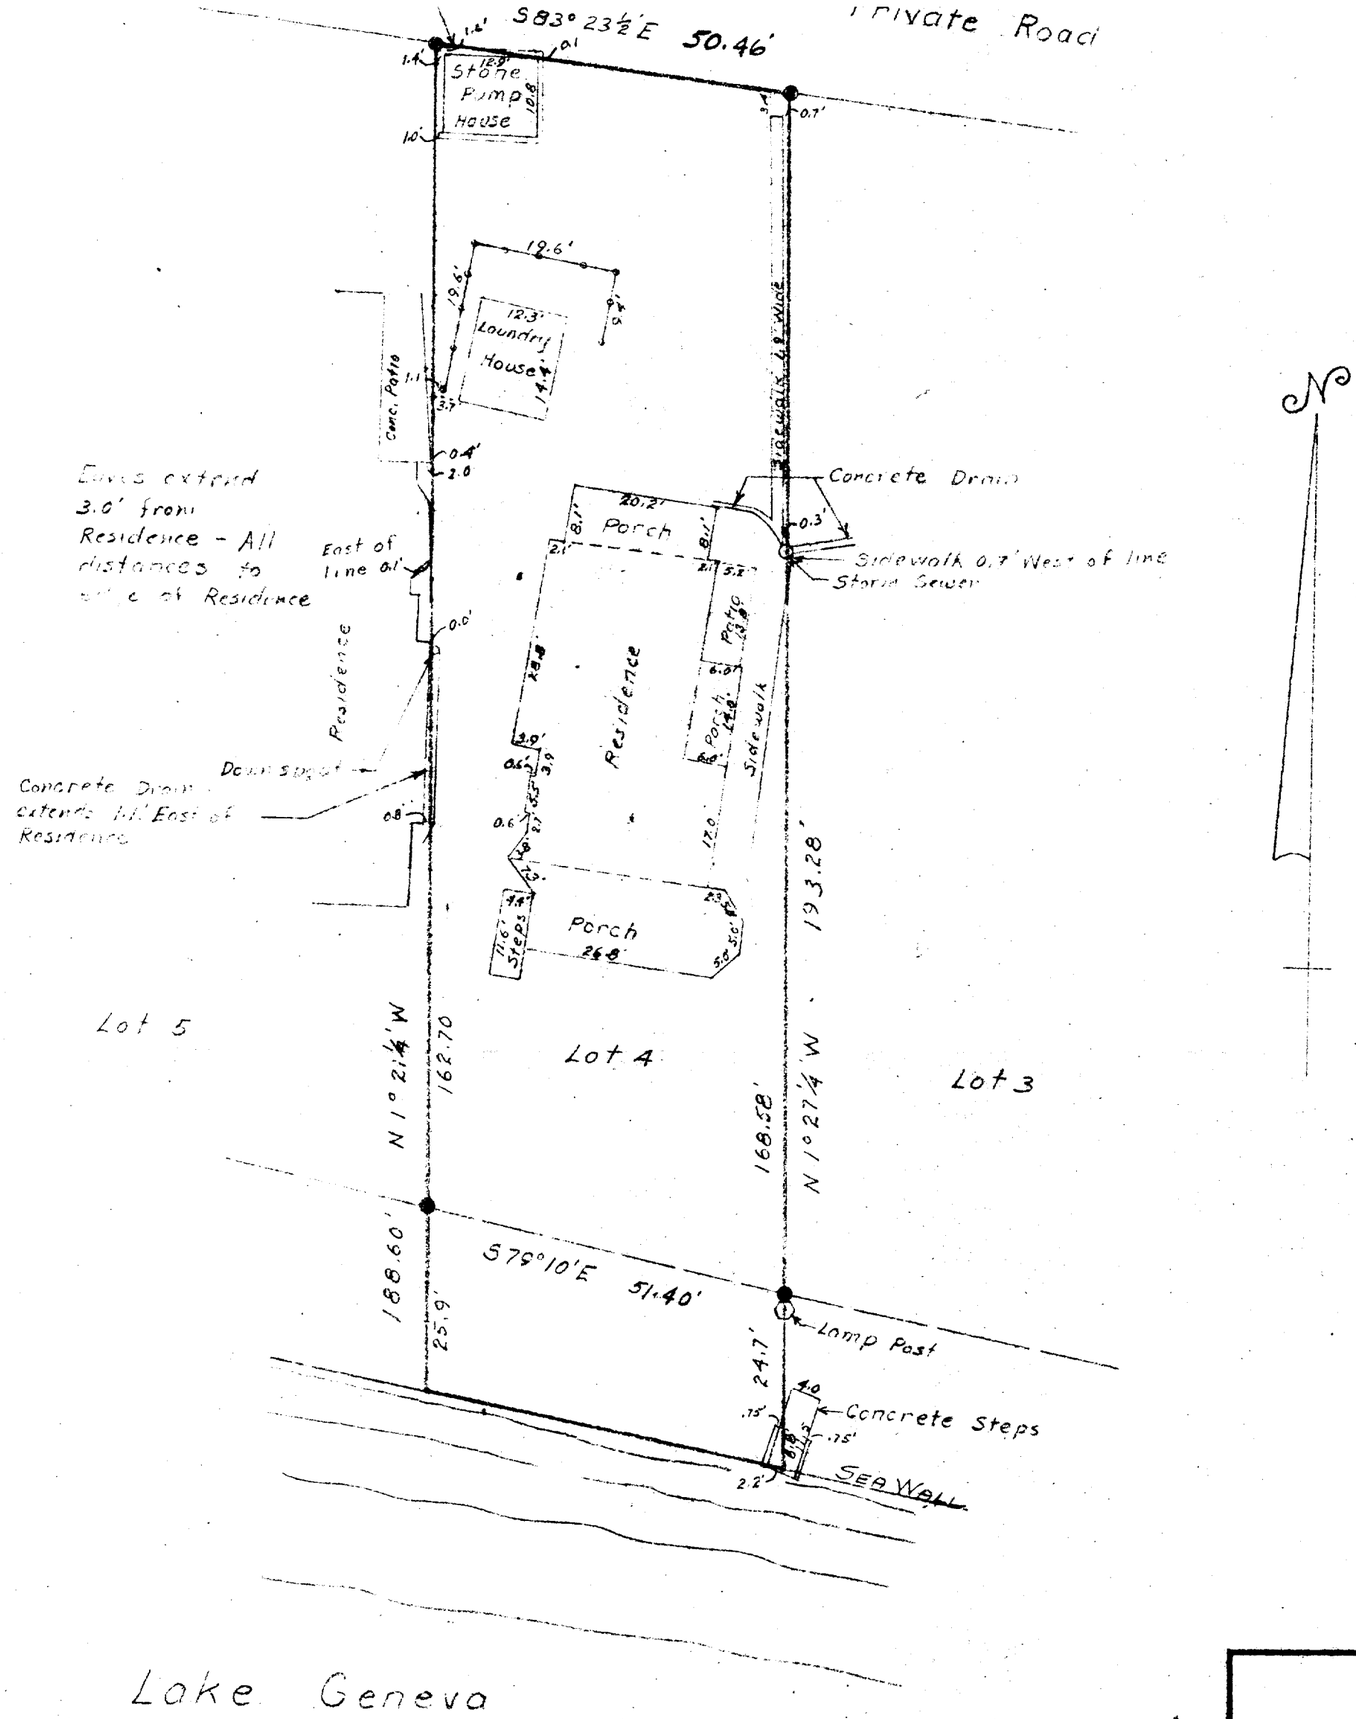

• - Concrete Monument

PLAT OF SURVEY
OF

Lot 4, Elgin Club, located in Section 4, T1N, R17E, Walworth County, Wisconsin

Floyd L. Jensen
SURVEYOR

SCALE 1" = 20'

DATE July, 1957

117-